


**KK BUILDING SECTION**  
SCALE 1:200

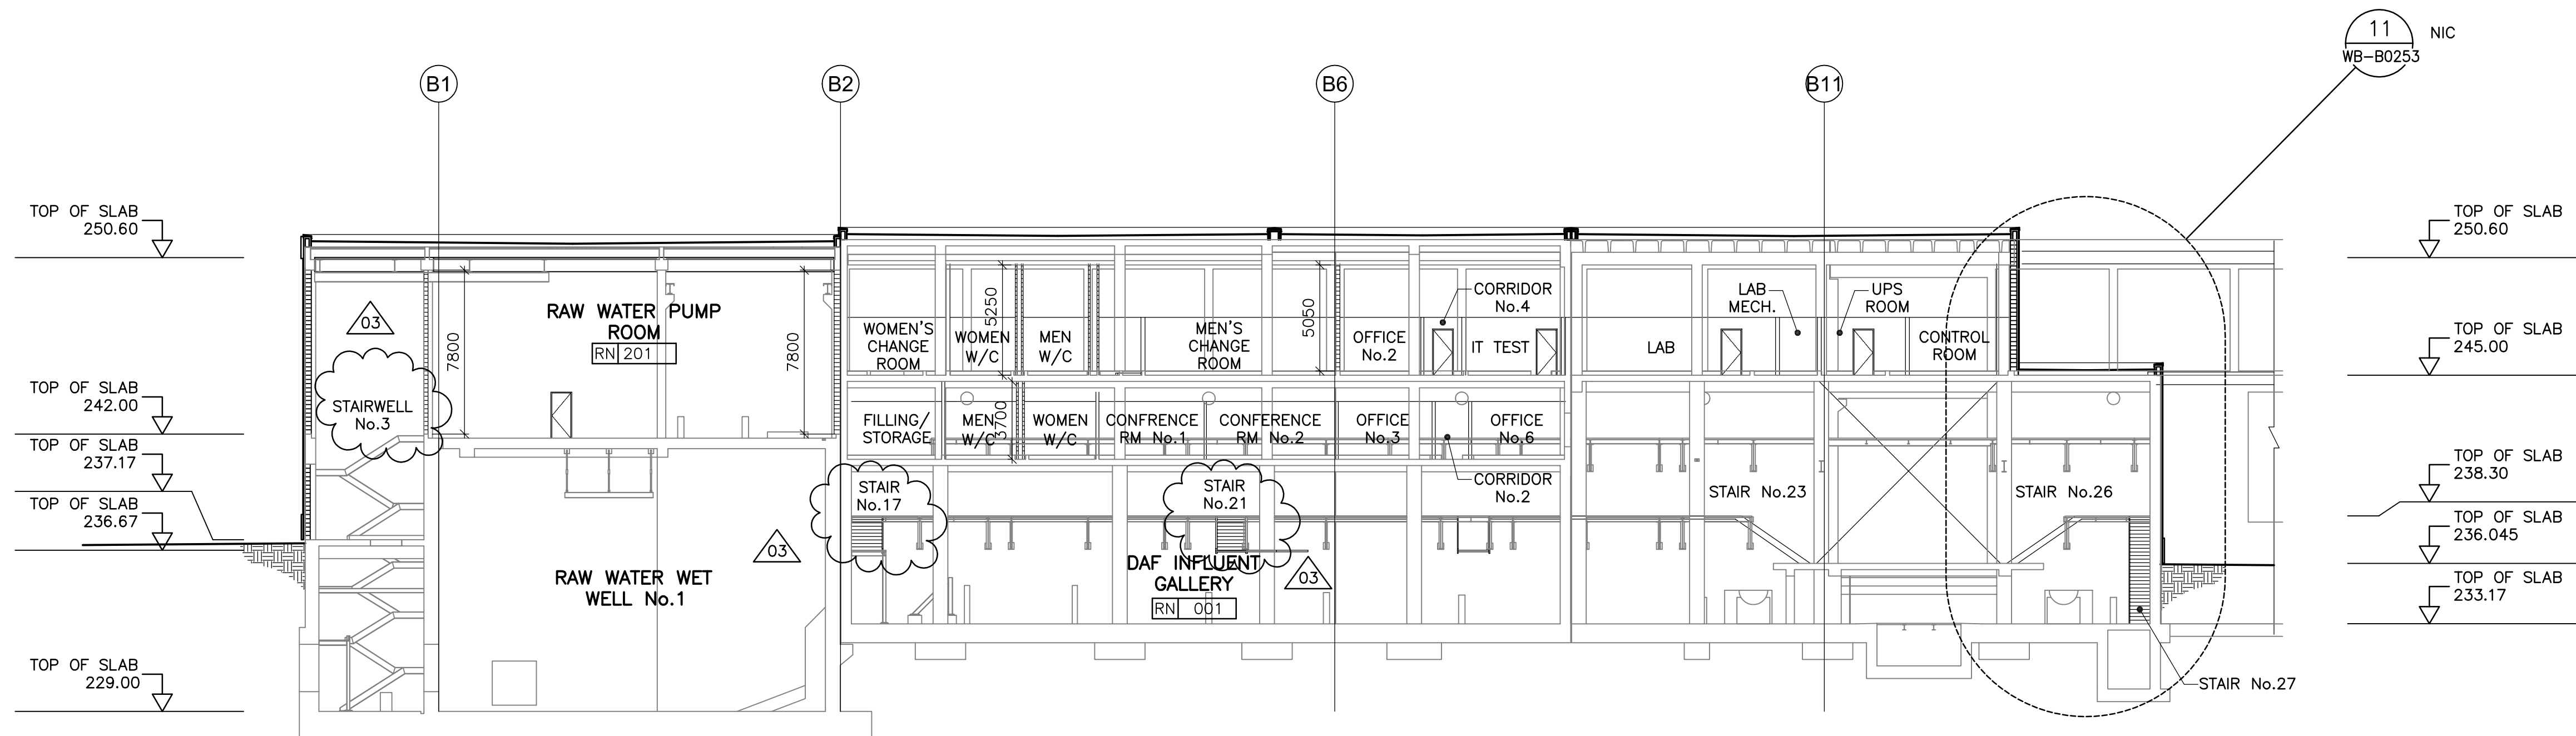

**LL BUILDING SECTION**  
SCALE 1:200

NOTE: BUILDING ENVELOPE AND ROOFING - NOT IN CONTRACT (REFER TO BID OPPORTUNITY 793-2006 & 171-2006 - TYP)



NO.	REVISIONS	DATE	BY
03	95-2007 ADDENDUM 01	07/06/12	LK
02	ISSUED FOR TENDER (95-2007)	07/06/05	LK
01	ISSUED FOR CONSTRUCTION	07/05/25	LK
00	ISSUED FOR TENDER (793-2006)	07/03/19	LK

DESIGNED BY	TWS	CHECKED BY	BJS
DRAWN BY	AL/LK/IC	APPROVED BY	AHL
SCALE:	AS NOTED	RELEASED FOR CONSTRUCTION BY:	R. SOROKOWSKI
DATE	2005/08/05	DATE	2007/03/19

ENGINEER'S SEAL  
ORIGINAL SIGNED BY  
NEIL COOPER  
2007/03/19  
CONSULTANT DRAWING NO.  
WB-B0206

**THE CITY OF WINNIPEG**  
WATER AND WASTE DEPARTMENT  
ENGINEERING DIVISION

WATER TREATMENT PLANT  
MAIN BUILDING  
BUILDING ENVELOPE

ARCHITECTURAL  
BUILDING SECTIONS

CITY FILE NUMBER  
SHEET OF  
CITY DRAWING NUMBER  
**1-0601B-A-B0206-001-03D**