SHEET: COW-A1 (05/2005)

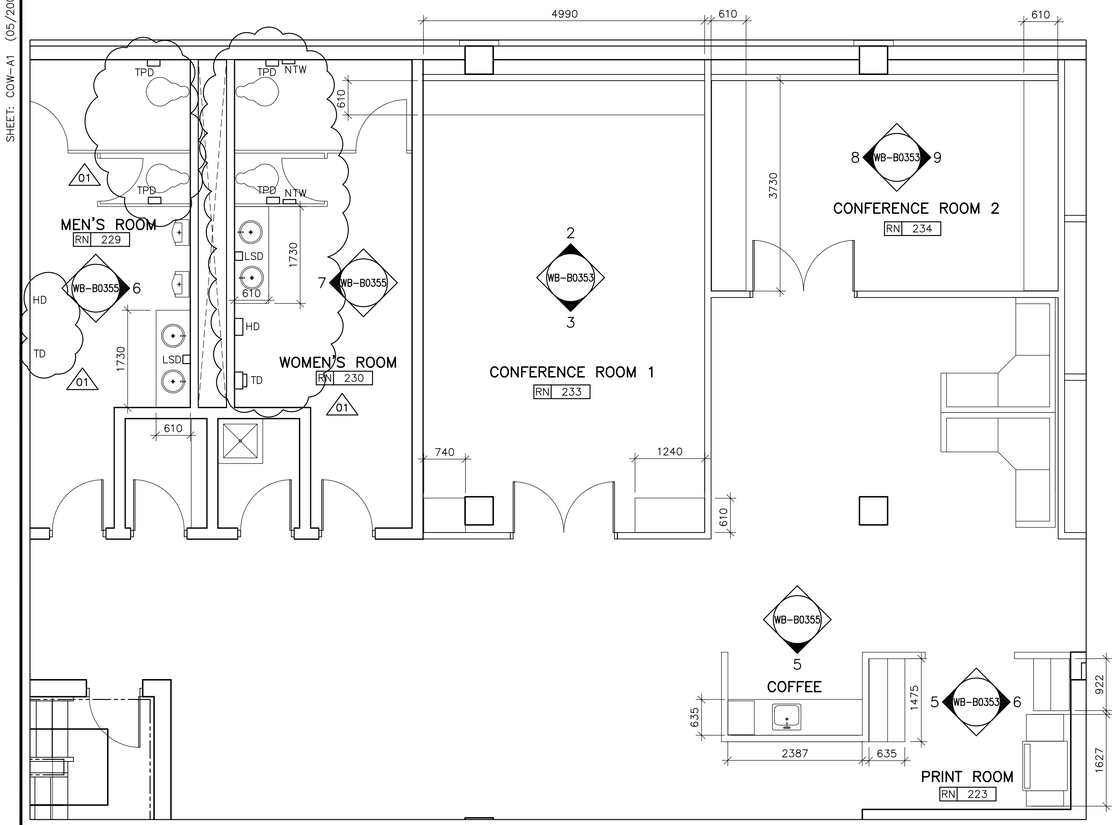

1 / WB-B0129 PARTIAL PLAN–MILLWORK (SECOND FLOOR LEVEL) 1 : 50

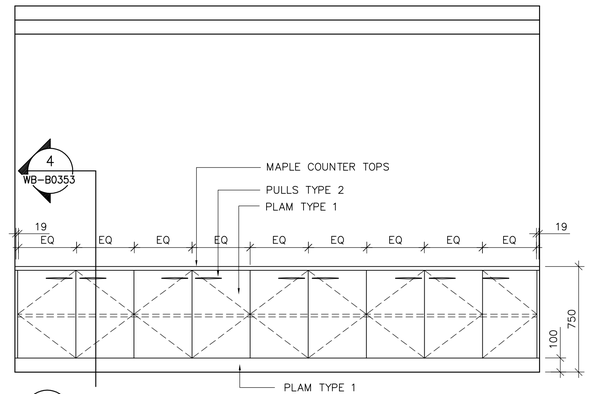

8/9 / WB-B0353 CONFERENCE ROOM 2 TYP ELEVATIONS 1 : 20

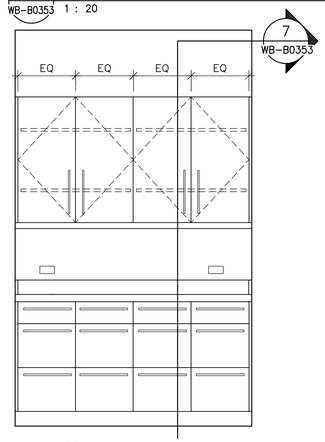

5 / WB-B0353 PRINT ROOM 223 1 : 20

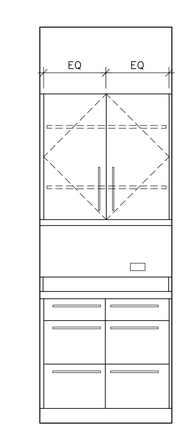

6 / WB-B0353 PRINT ROOM 223 1 : 20

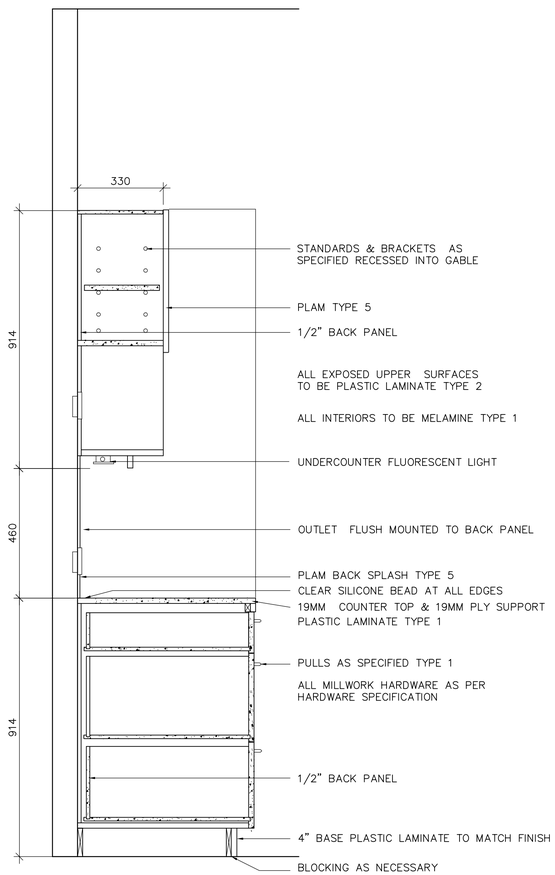

7 / WB-B0353 TYP MILWORK SECTION @ PRINT ROOMS 223/322 1 : 10

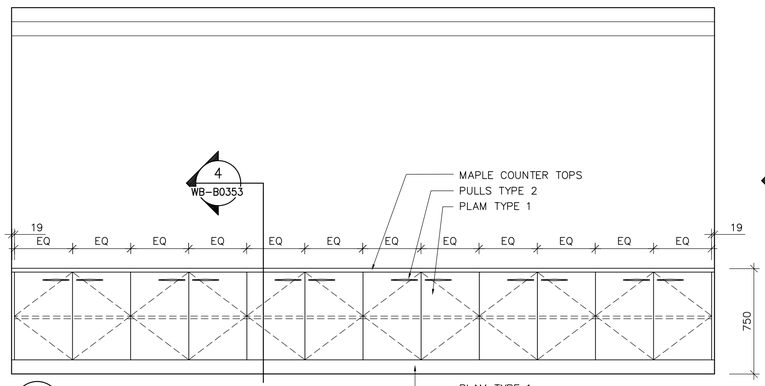

2 / WB-B0353 CONFERENCE ROOM 233 1 : 20

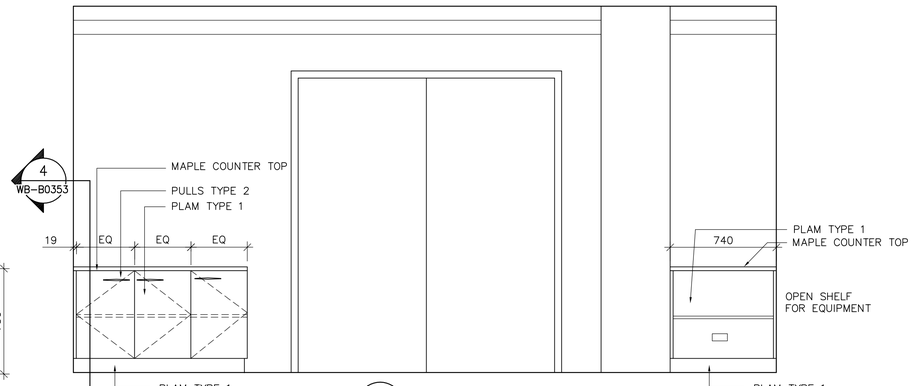

3 / WB-B0353 CONFERENCE ROOM 233 1 : 20

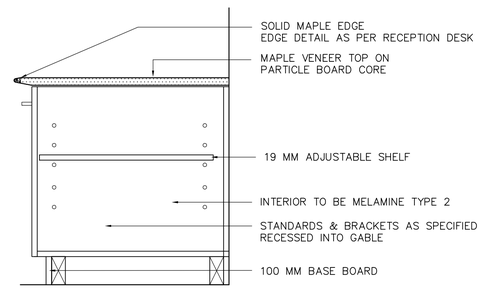

4 / WB-B0355 TYPICAL MILLWORK SECTION 1 : 10

PROVINCE OF MANITOBA
NEIL COOPER ARCHITECT INC. No.090
APPROVED ARCHITECTURAL CORPORATION

NO.	REVISIONS	DATE	BY
01	95–2007 ADDENDUM 07	07/07/27	LK
00	ISSUED FOR TENDER	07/06/05	LK

B.M. ELEV.

CH2MHILL
Fredericksen Cooper ARCHITECTS

EarthTech
A Tyco International Ltd. Company

DESIGNED BY	MG	CHECKED BY	BJS
DRAWN BY	MG	APPROVED	AHL
SCALE:	AS NOTED	RELEASED FOR CONSTRUCTION BY:	R. SOROKOWSKI
DATE	2005/08/05	DATE	2007/06/05

ENGINEER'S SEAL
ORIGINAL SIGNED BY
NEIL COOPER
2007/06/05

CONSULTANT DRAWING NO.
WB-B0353

Winnipeg
THE CITY OF WINNIPEG
WATER AND WASTE DEPARTMENT
ENGINEERING DIVISION

WATER TREATMENT PLANT
MAIN BUILDING
OFFICE AND PLANT INTERIOR FINISHES

ARCHITECTURAL
MILLWORK PLANS, ELEVATIONS, AND SECTIONS

CITY FILE NUMBER
SHEET OF
CITY DRAWING NUMBER
1-0601B-A-B0353-001-01D

Last Save: 2007–07–27 2:26 PM

\\FCA–S\DATA\NC\JOBDATA\2004\04018 WINNIPEG WATER TREATMENT\02A–CAD\WTP\CONT DWGS\FCA\INTERIOR ELEVATIONS–SAI\WB–B0353.DWG