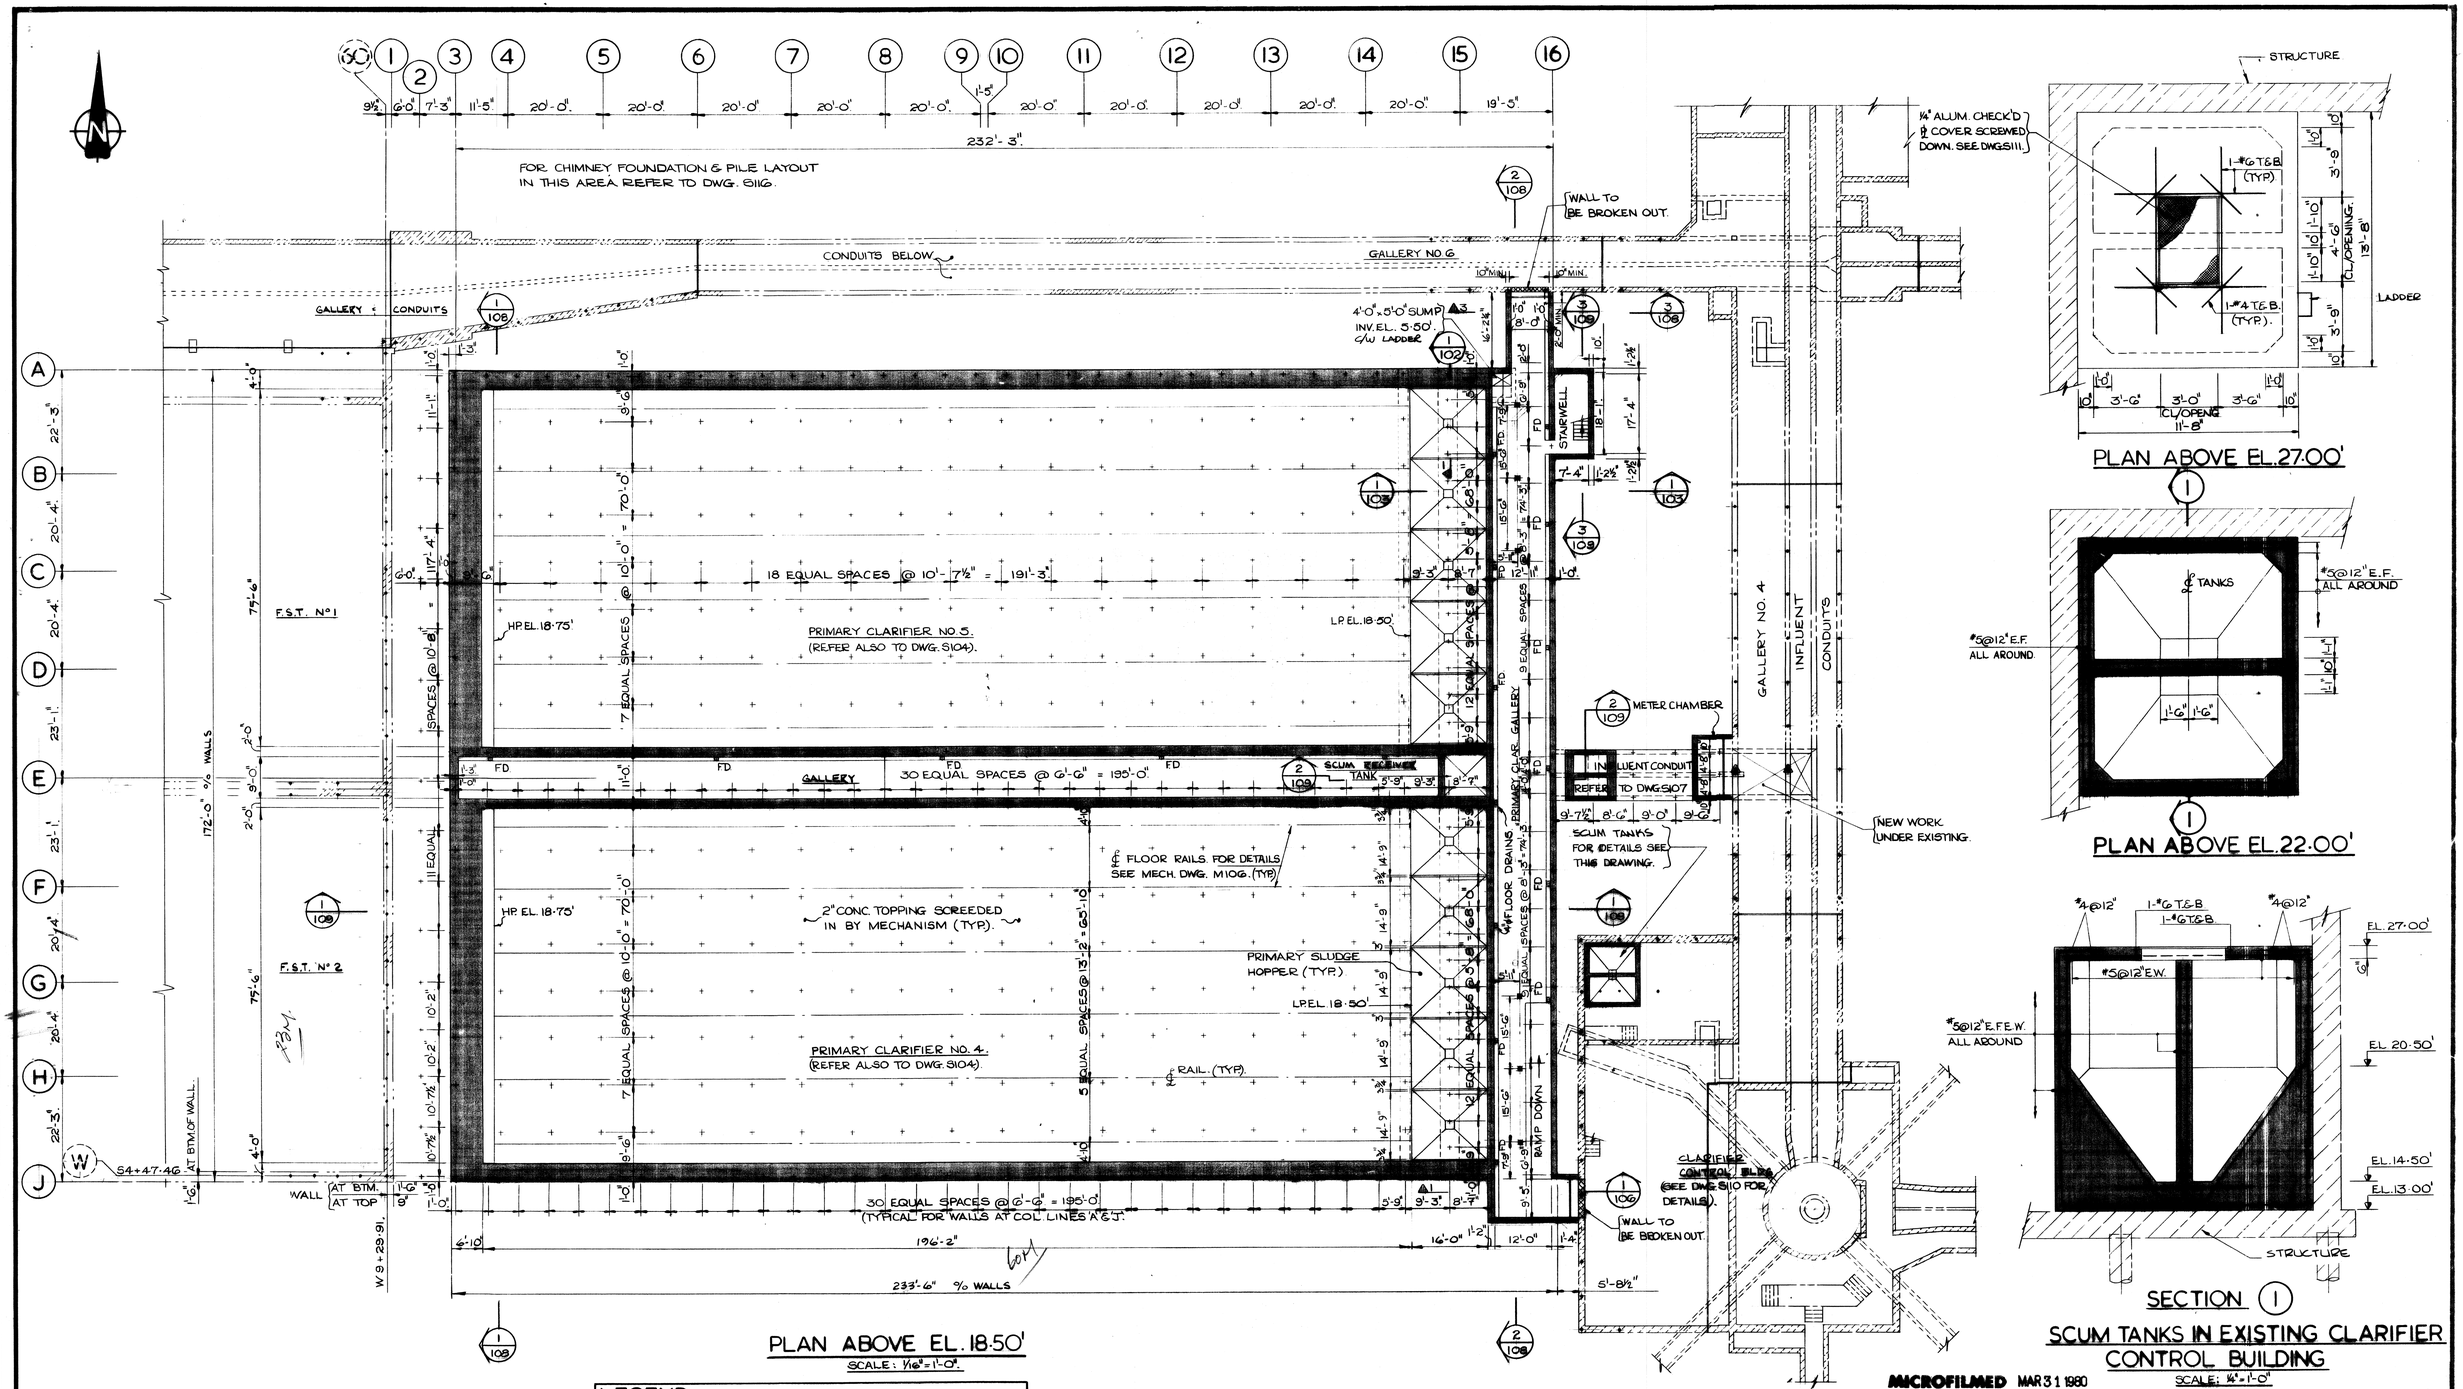

MICROFILMED MAR 31 1980

LEGEND

NEW WORK		NEW PILES	+
EXISTING WORK		EXISTING PILES	•
EXISTING WORK TO BE REMOVED		EXISTING PILES TO BE CUT BACK.	△

CENTRAL FILE | ENGINEERING FILE | DRAWING FILE NUMBER | DATE FILMED

GRID CO-ORDINATES

MICROFILMING | WORKS & OPERATIONS DEPT.

PROVINCE OF MANITOBA — G. REMPEL — May/78 — REGISTERED ENGINEER

REV.	DESCRIPTION	BY	DATE
	AS BUILT CJA		SEPT 79
	ISSUED FOR TENDER		15-5-78

W. L. WARDROP & ASSOCIATES LTD.
JAMES F. MacLAREN LIMITED
ENGINEERING CONSULTANTS

DRAWN BY: W. D. | DESIGNED BY: A. L.
CHECKED BY: C.V.W. | APPROVED BY: | DATE:

THE CITY OF WINNIPEG
WORKS & OPERATIONS DEPARTMENT
WATERWORKS, WASTE & DISPOSAL DIVISION

NORTH END WATER POLLUTION CONTROL CENTRE
PRIMARY CLARIFIER ADDITION
STRUCTURAL
PLAN ABOVE EL. 18.50'

SCALE: AS NOTED.
DATE: MAY 1978
CONSULTANT DRAWING NO. 76012-05-S101
CITY DRAWING NO. NEP-238

FILE 10873-D-40891 NR 11108