



FLATTENED INSIDE ELEVATION OF PLAZA WALL

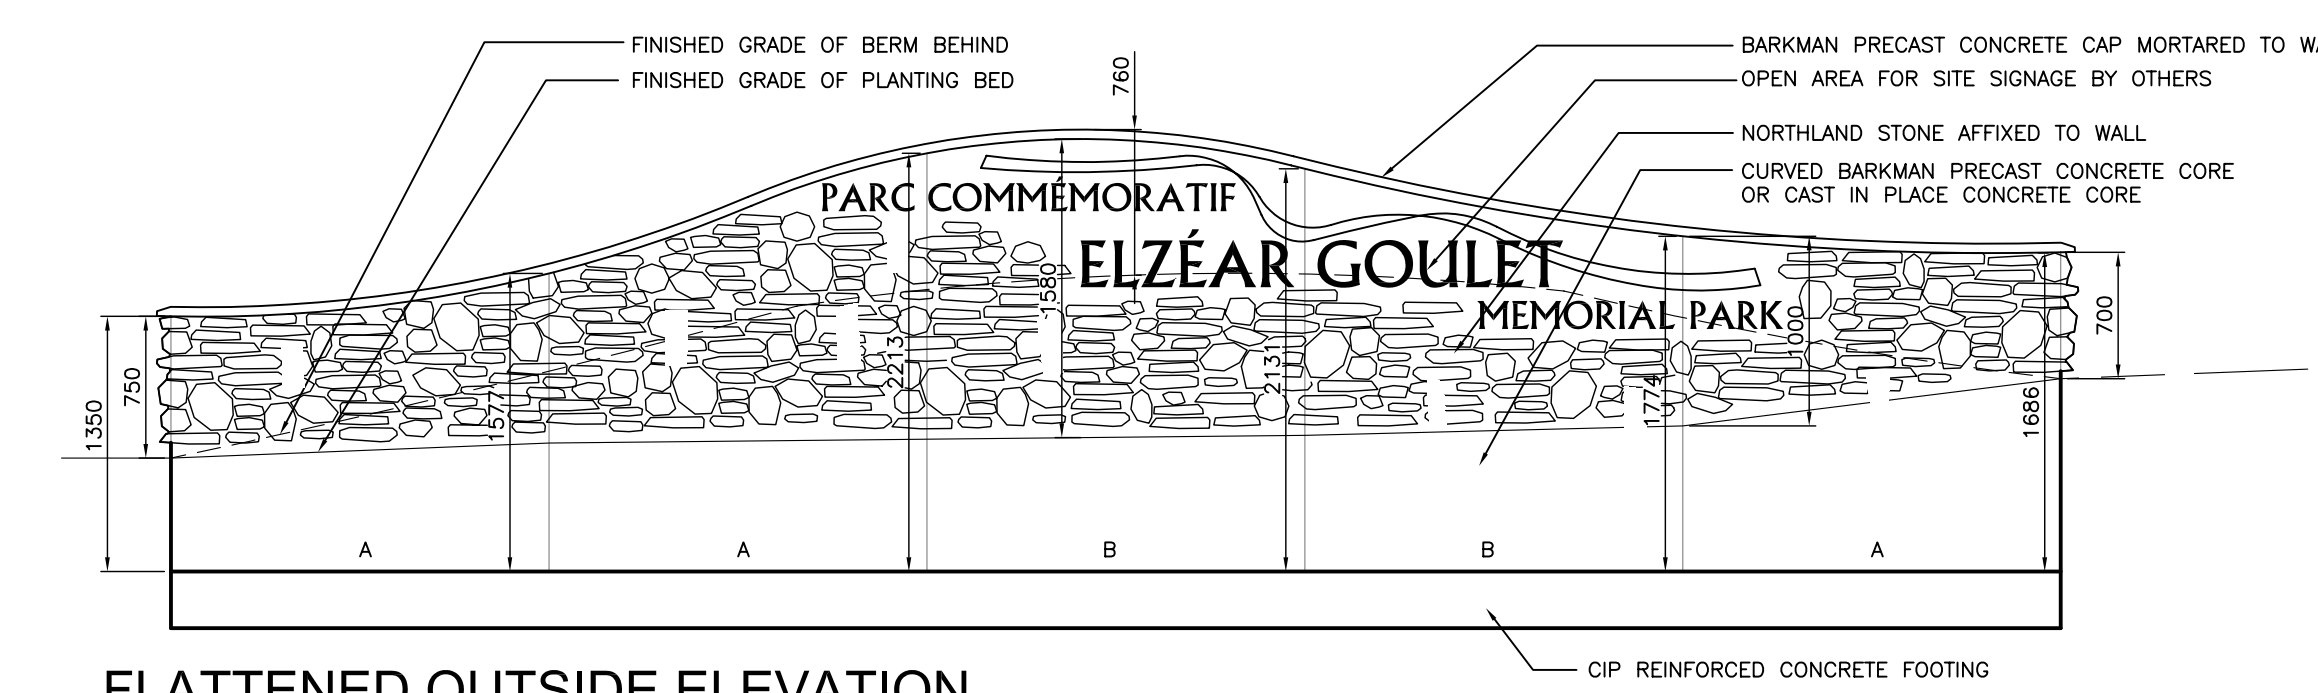


FLATTENED OUTSIDE ELEVATION

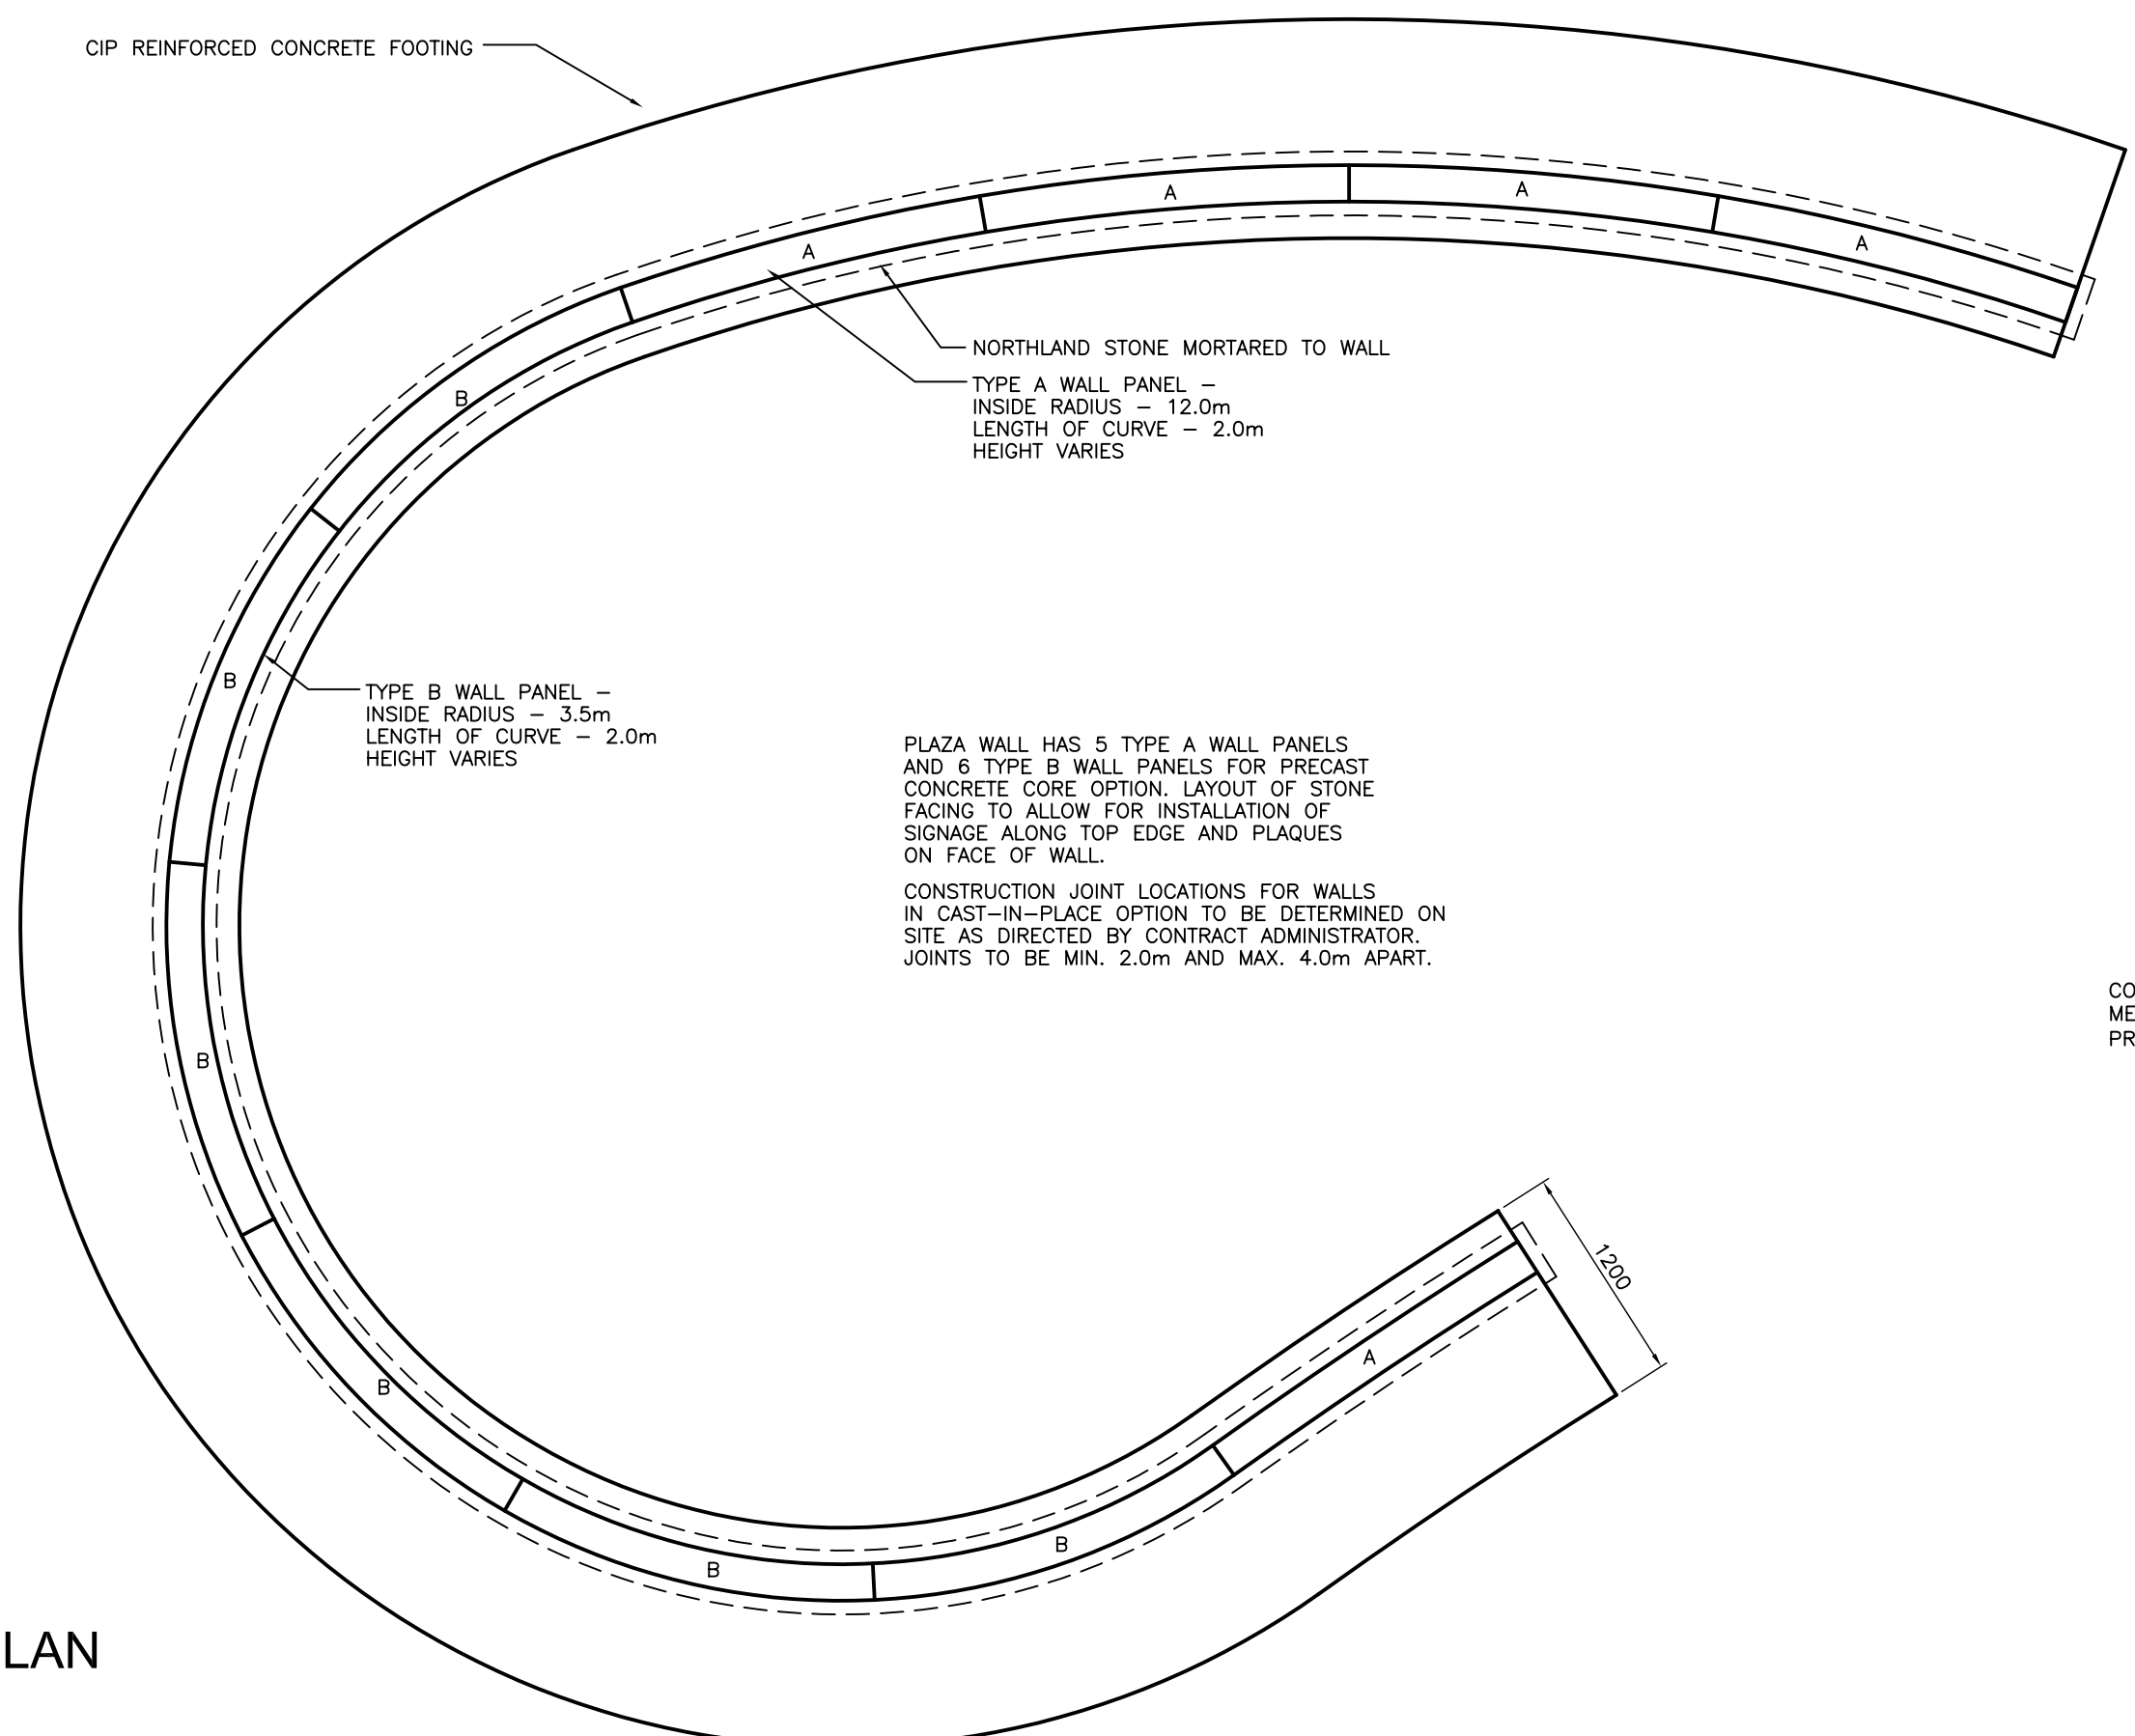


PLAN

11 PLAZA INTERPRETIVE WALL


L1 N.T.S.

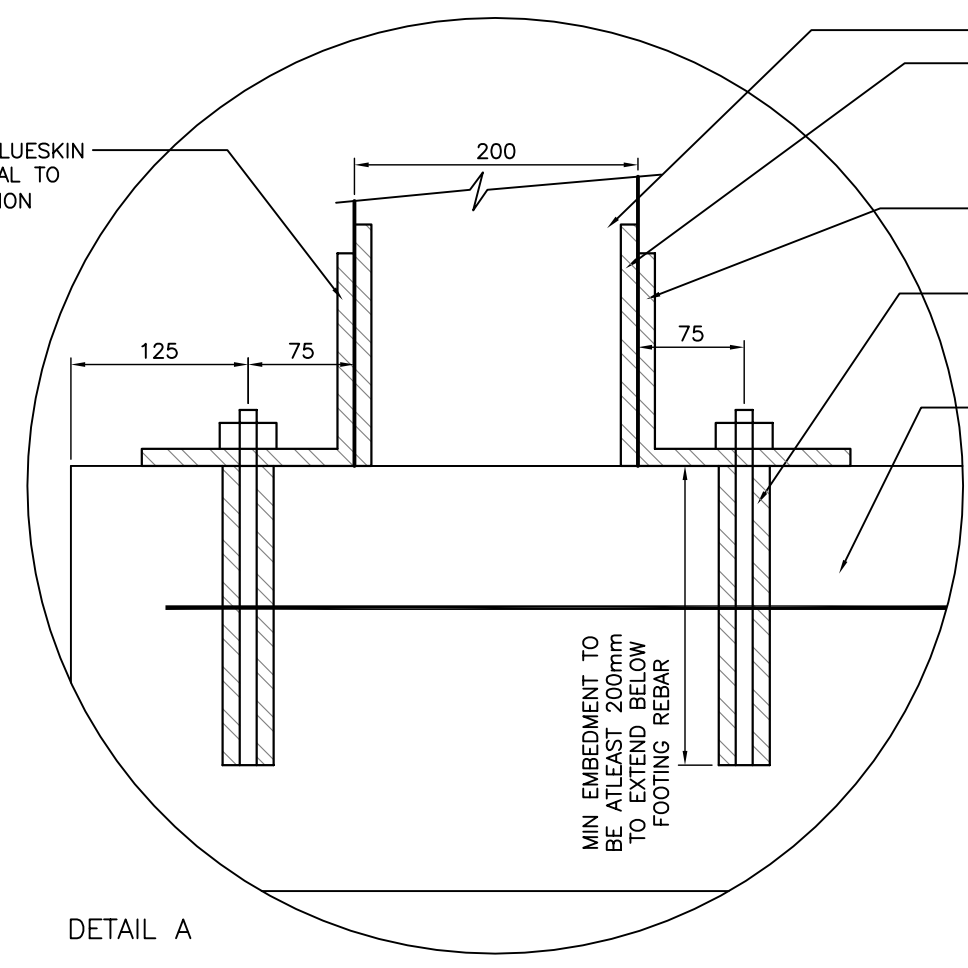

DETAIL A

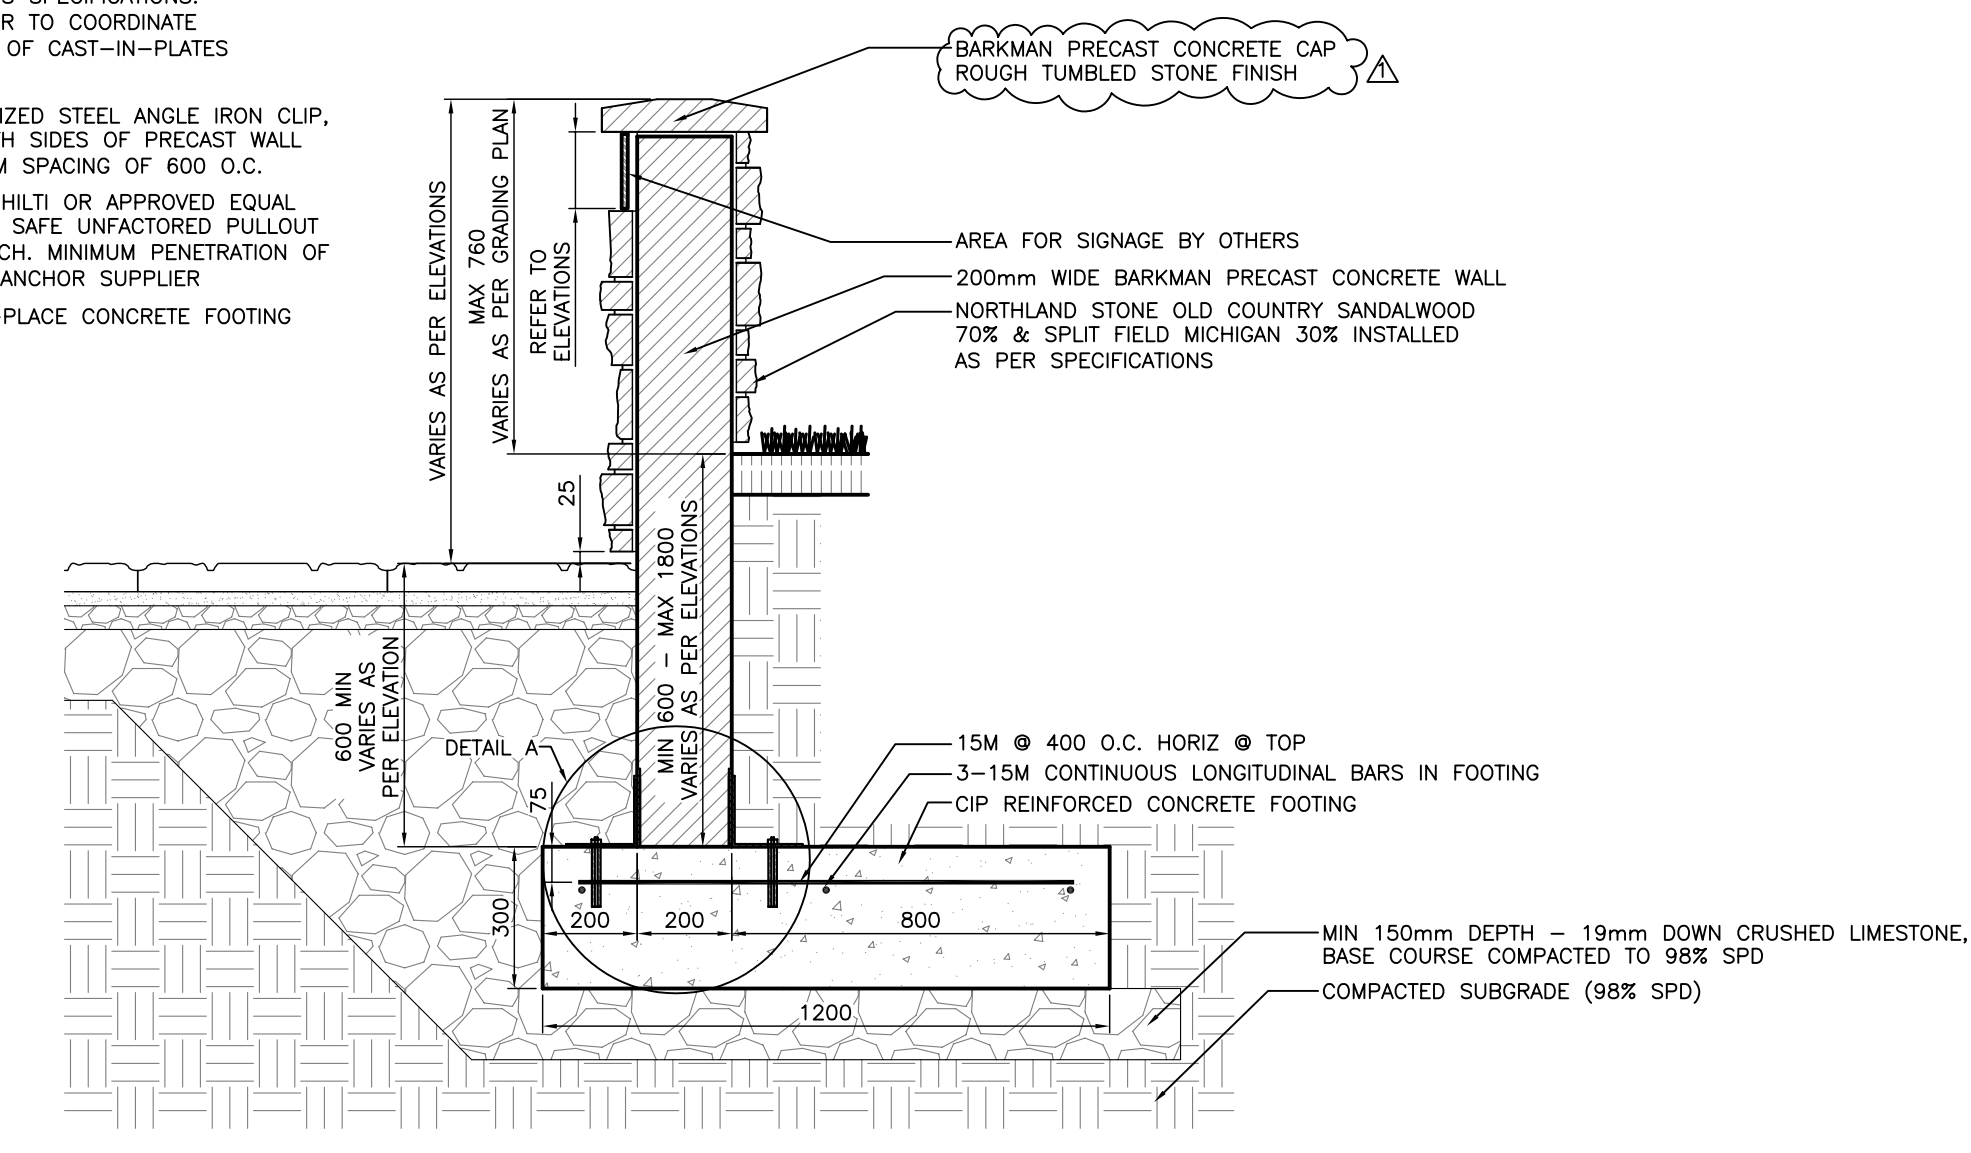


OPTION 2 - PRECAST CONCRETE CORE

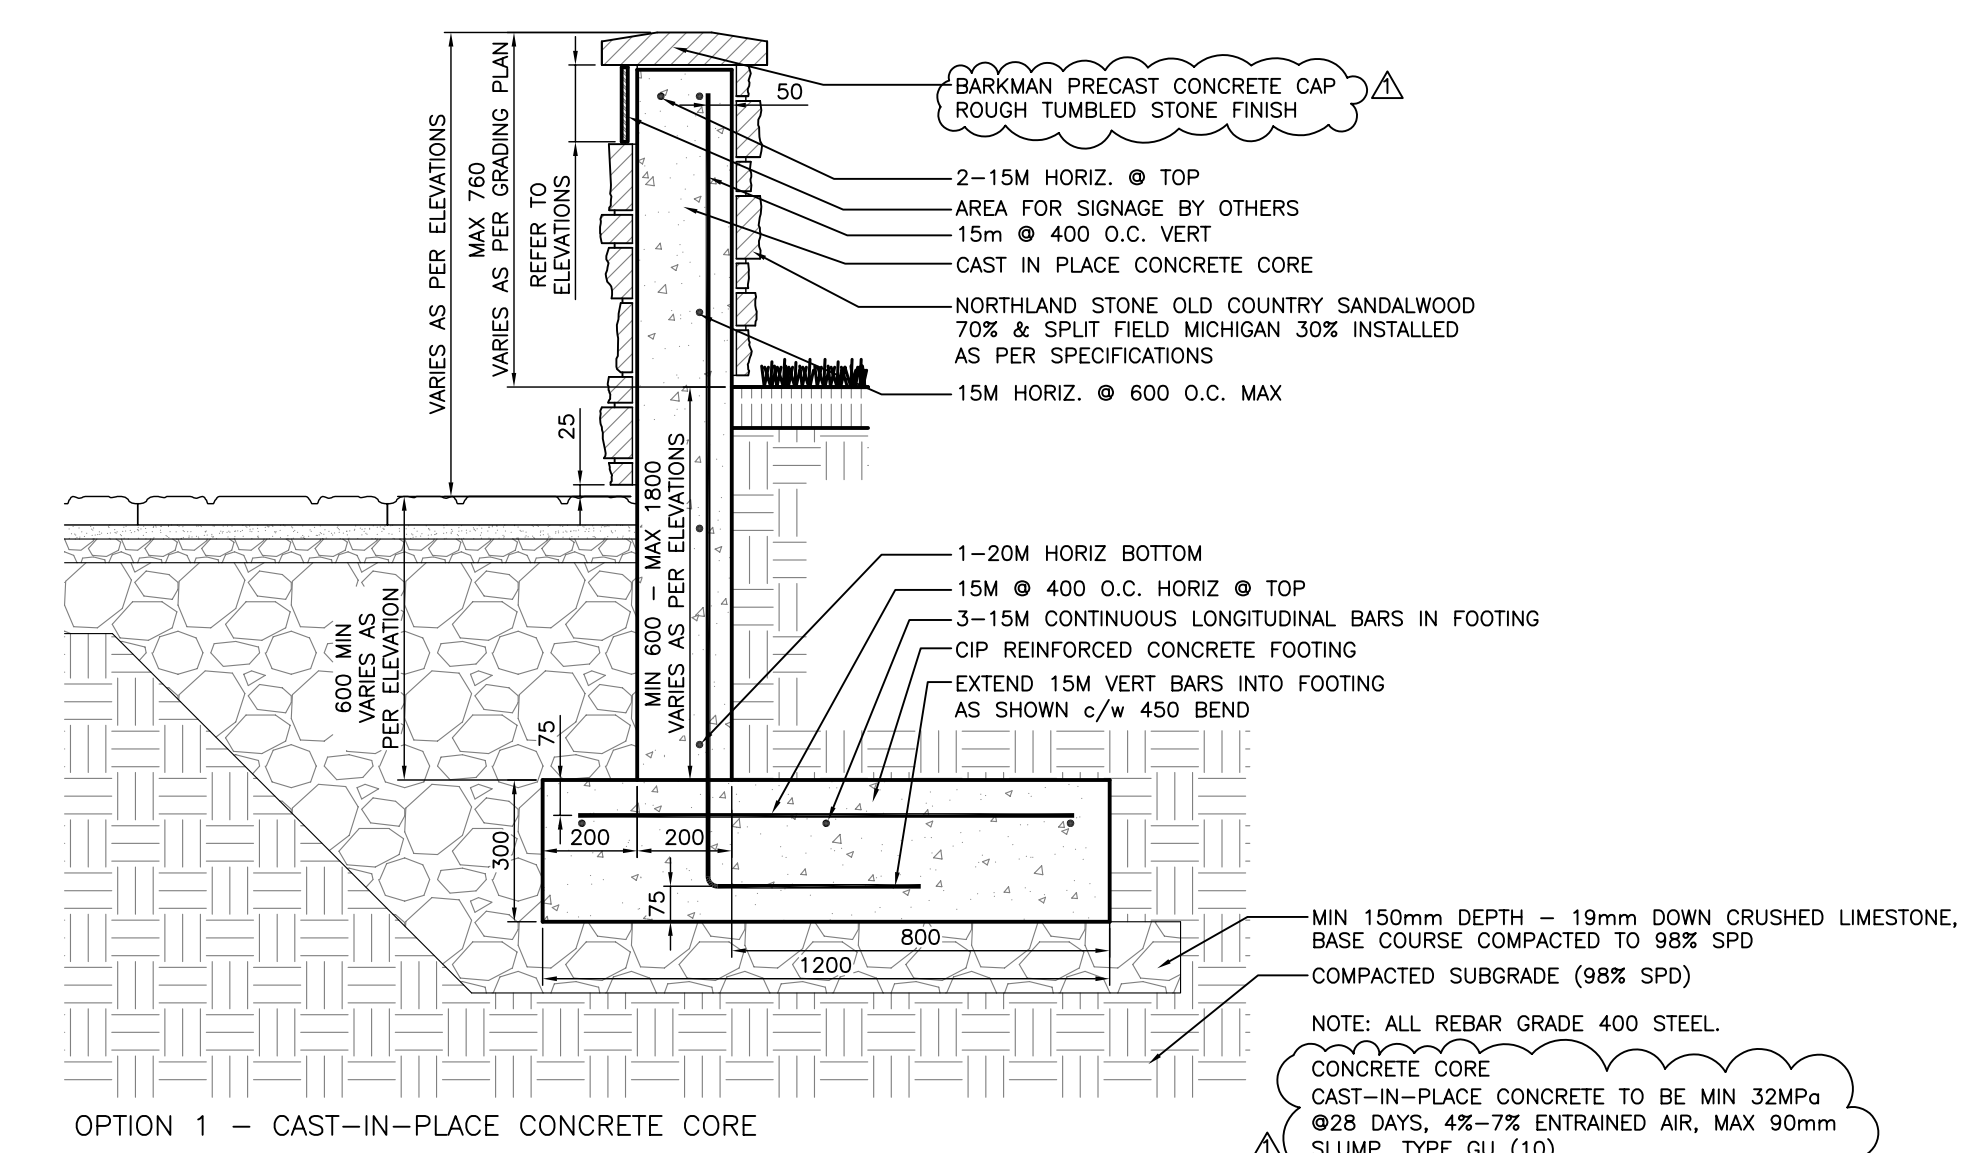

OPTION 1 - CAST-IN-PLACE CONCRETE CORE

14 CONCRETE CORE

L1 N.T.S.

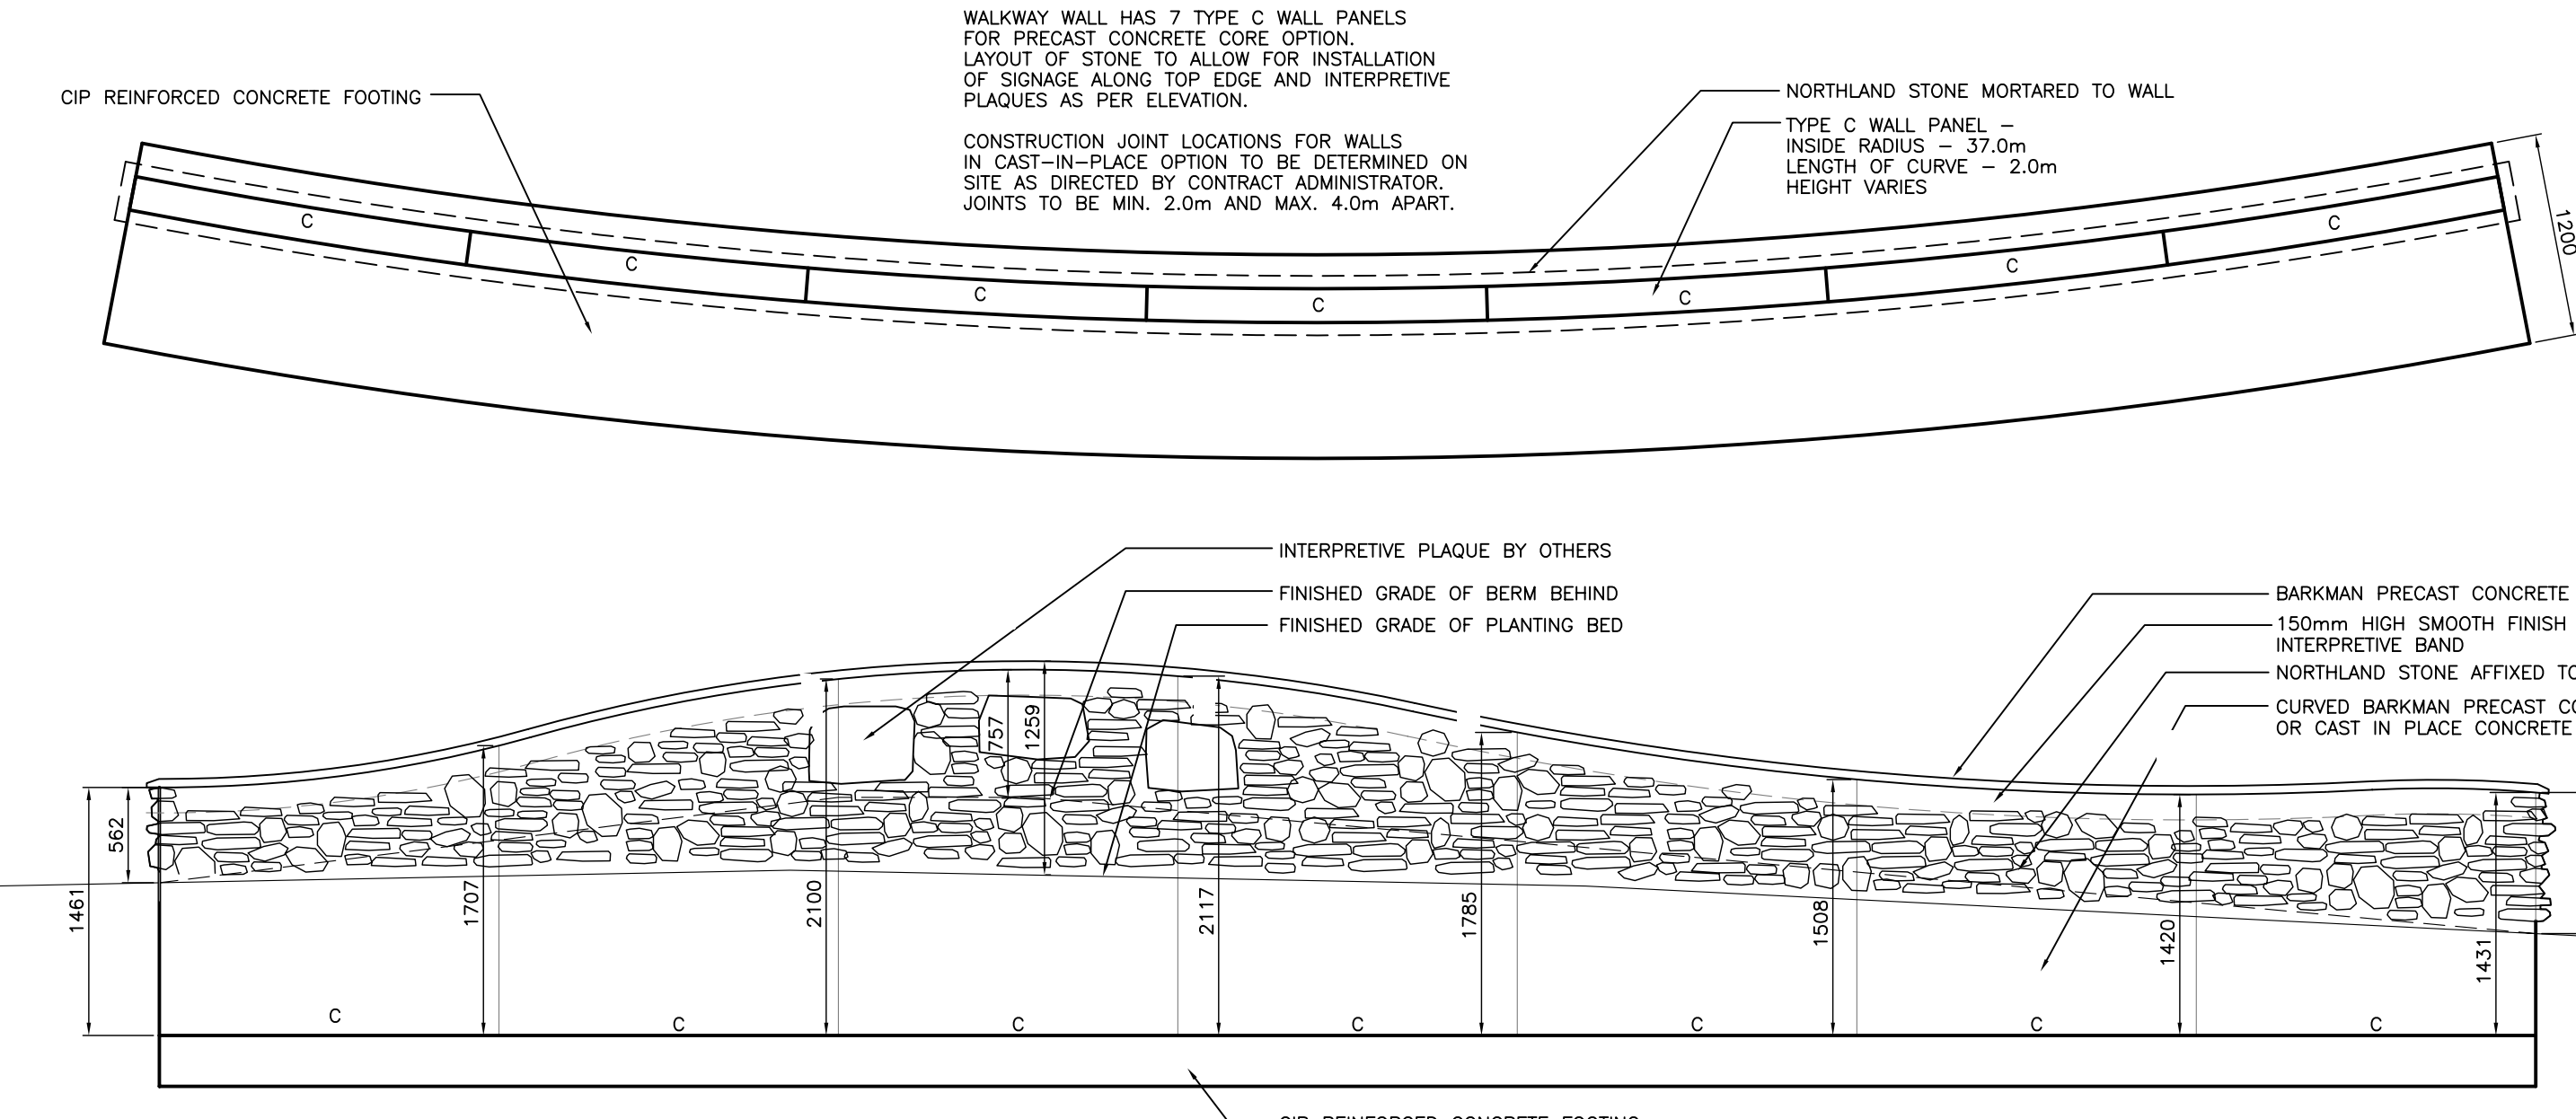


13 WALKWAY INTERPRETIVE WALL

L1 N.T.S.


12 ENTRANCE WALL / SITE SIGN

L1 N.T.S.

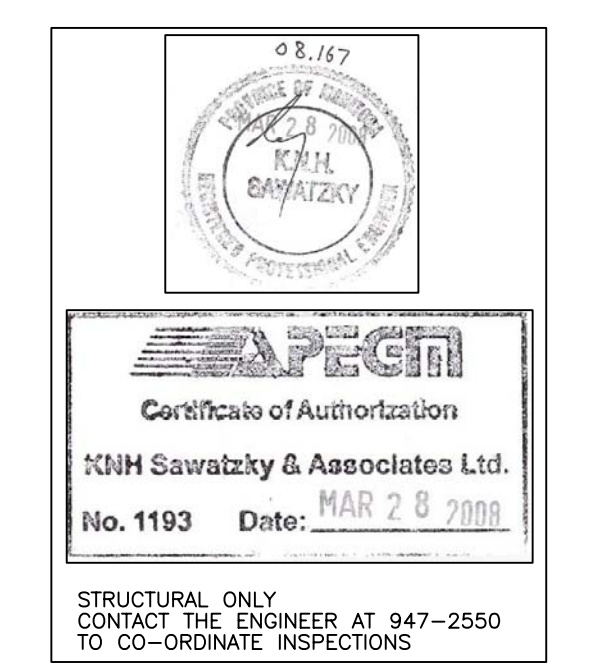

1	ADDENDUM 1	04/15/08	PR
	ISSUED FOR TENDER	04/04/08	AH
	ISSUED FOR PERMITS	04/01/08	AH

Date:	Scale:	14-03-08	AS NOTED
Designed By:	Drawn By:	Checked By:	
JW	JW	SR	

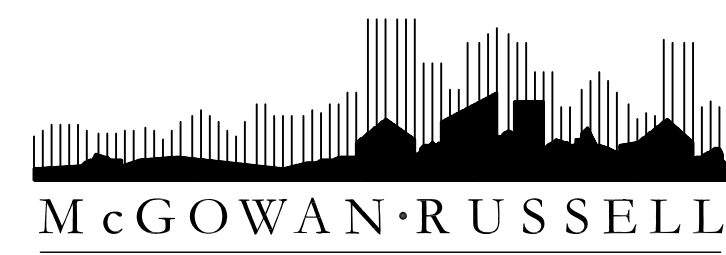

CITY OF WINNIPEG  
 Project Title  
**ELZÉAR GOULET  
 MEMORIAL PARK**

DETAILS