




**1 FRONT (WEST) ELEVATION**  
15 17  
1 : 50  
- GIRDERS NOT SHOWN FOR CLARITY

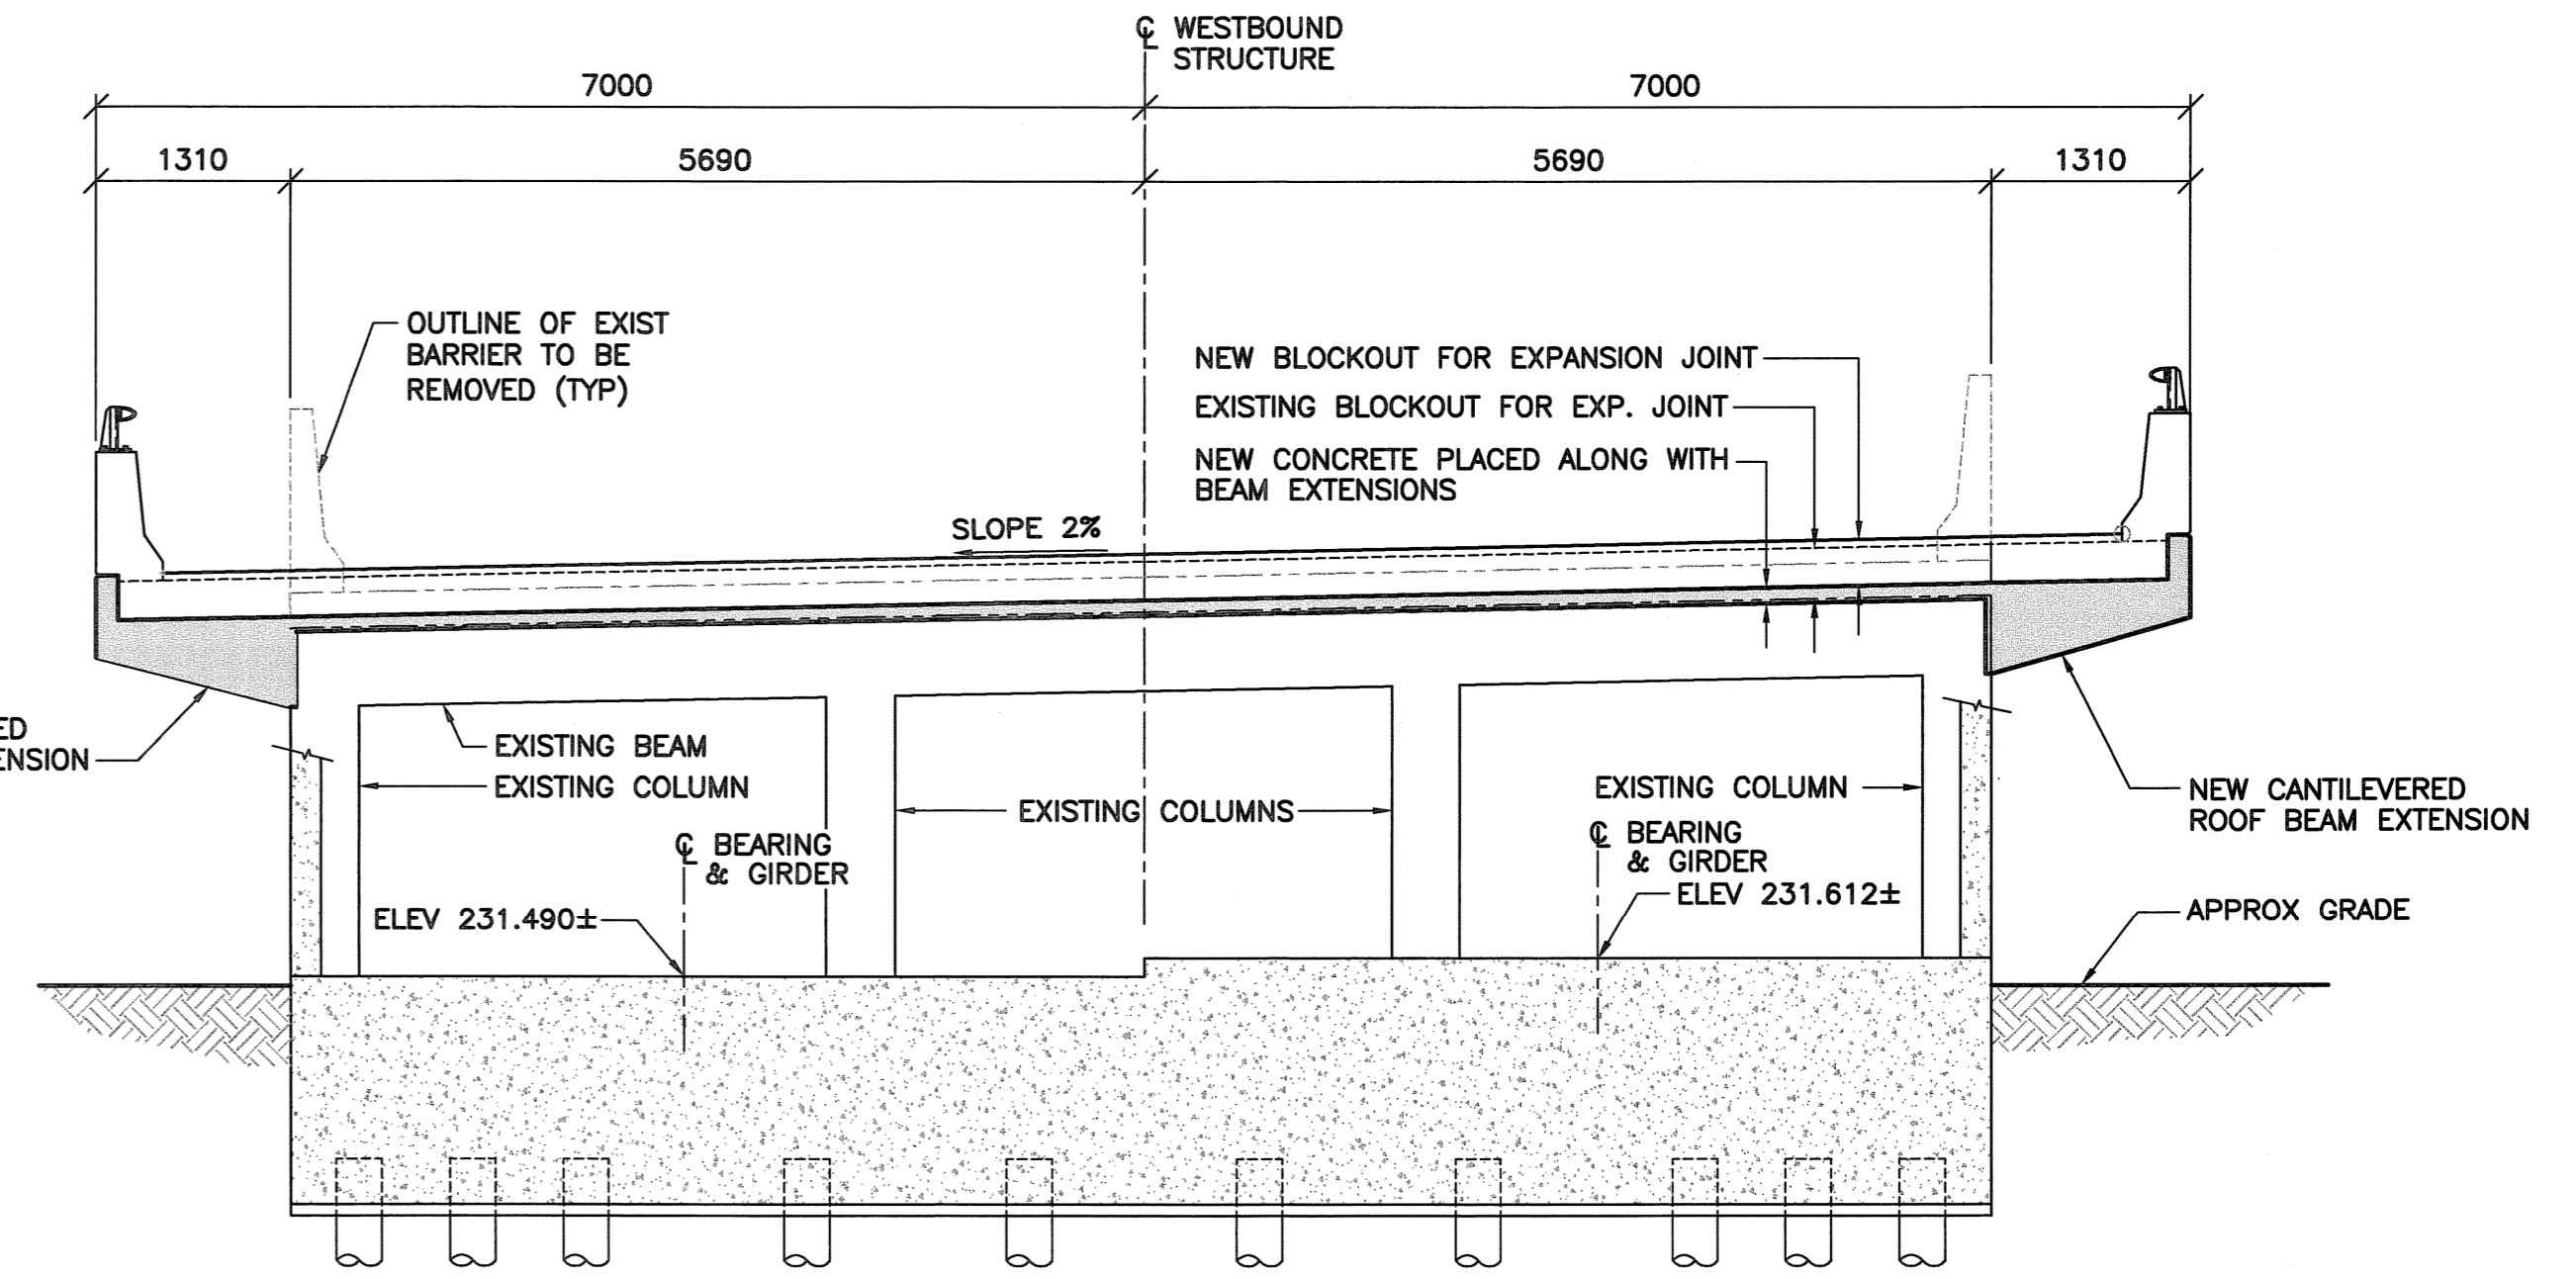


**2 SECTION**  
15 17  
1 : 50

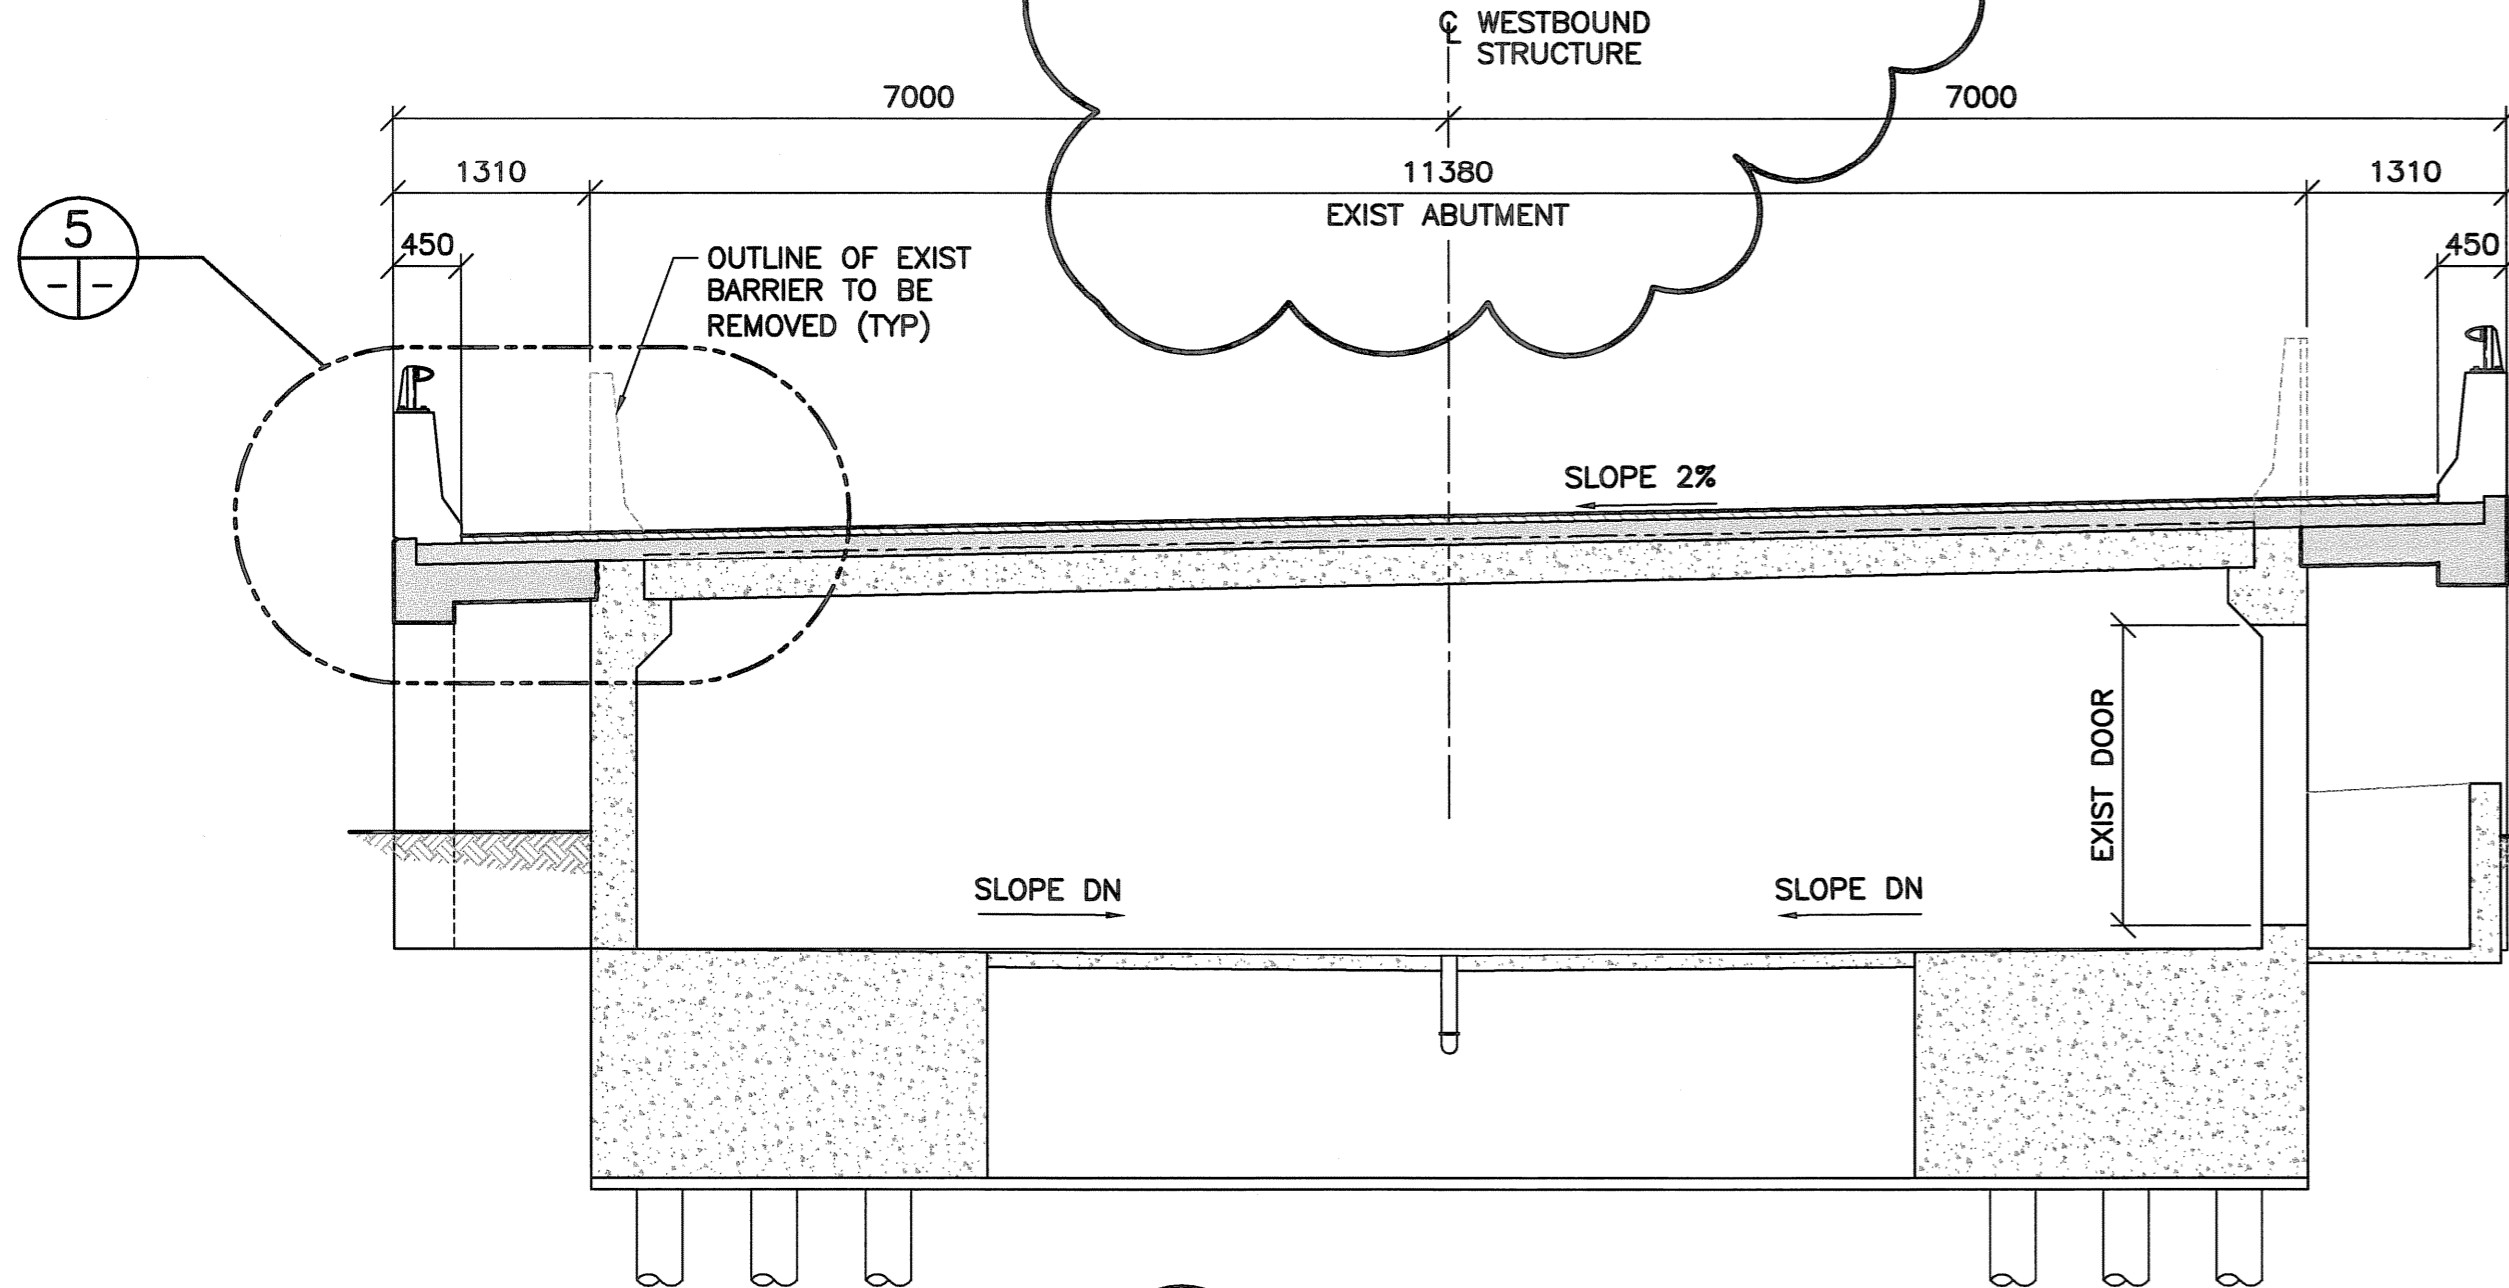

**3 SECTION**  
15 17  
1 : 50

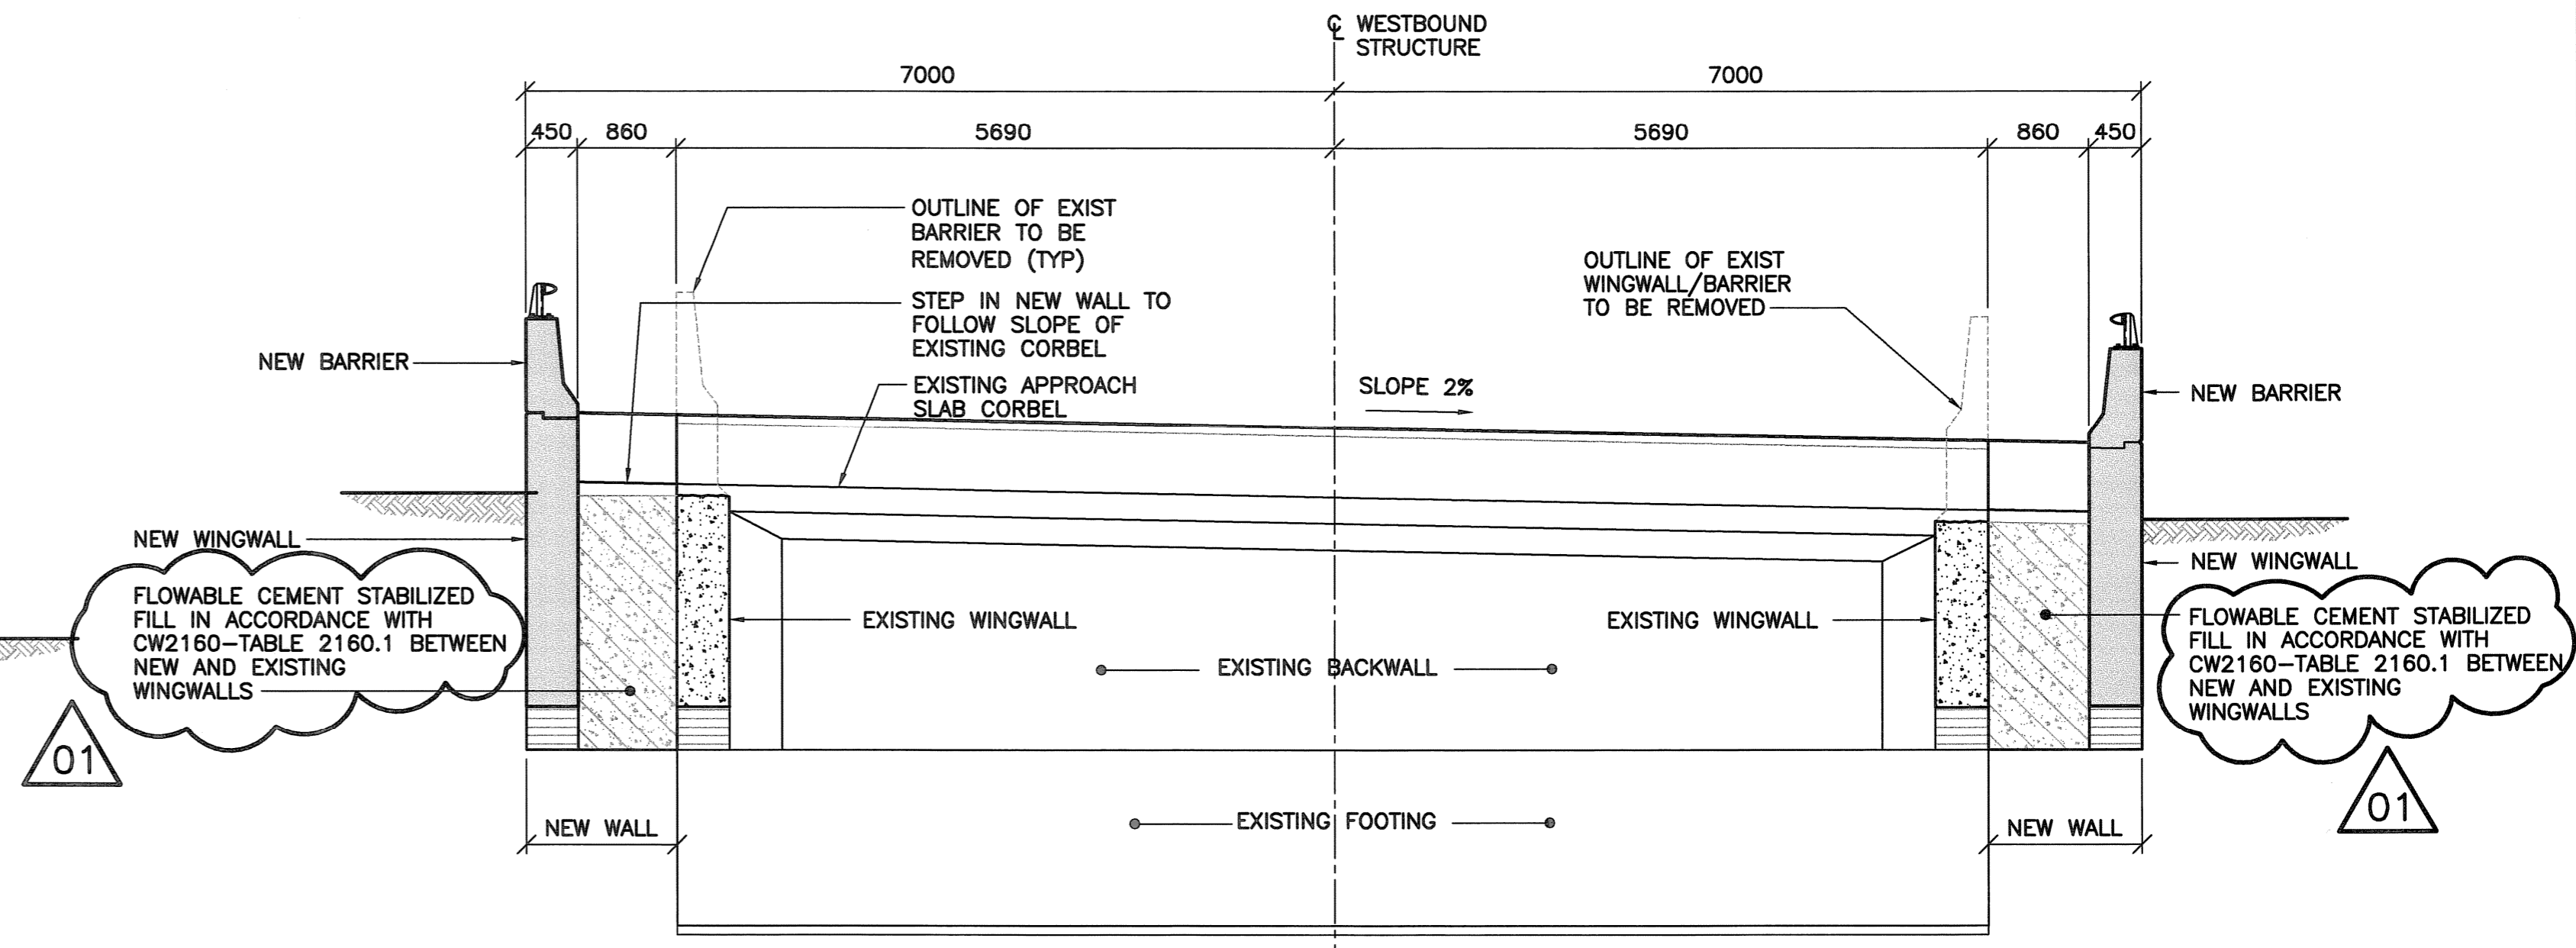

**4 SECTION/REAR ELEVATION**  
15 17  
1 : 50  
- NEW APPROACH SLAB NOT SHOWN FOR CLARITY

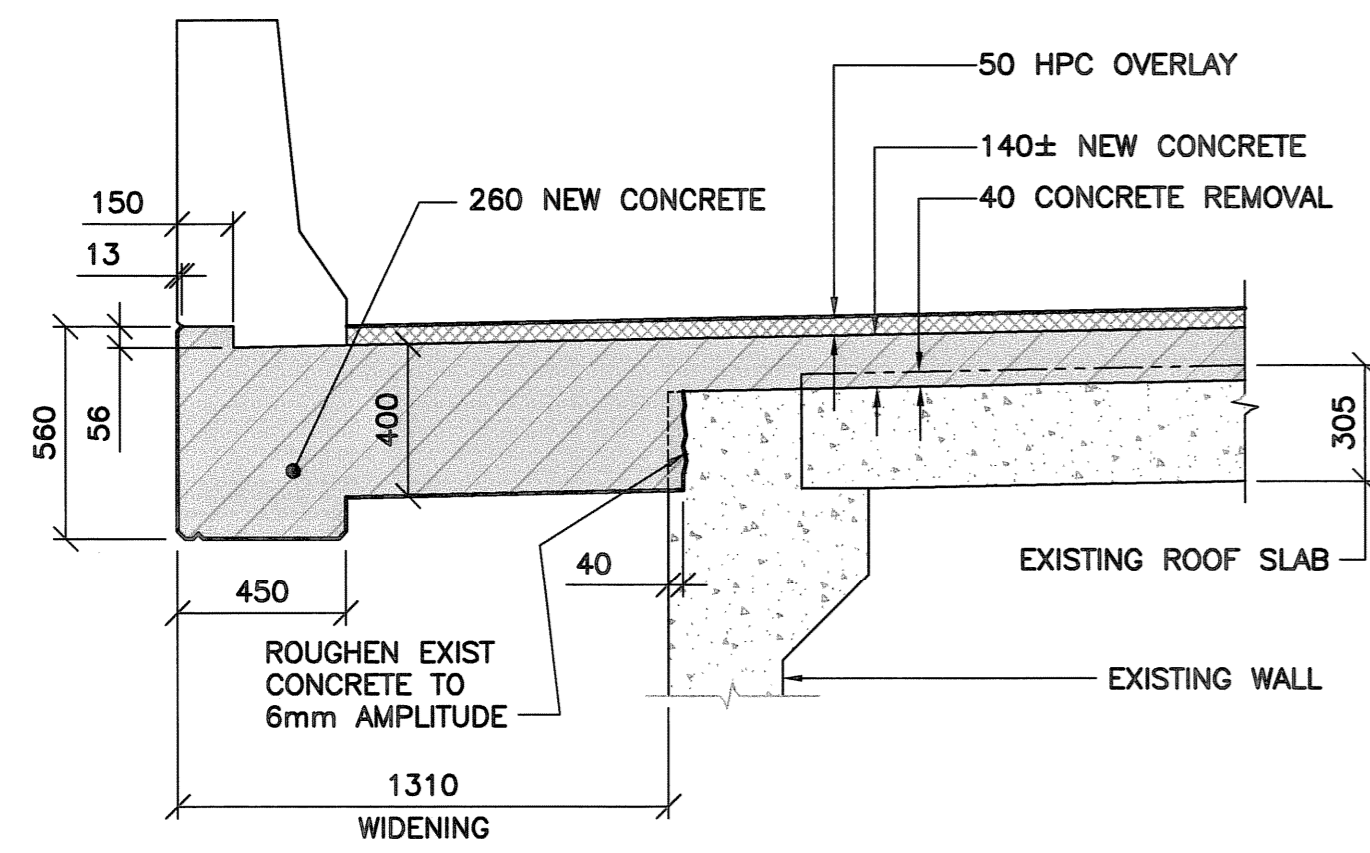

**5 DETAIL**  
1 : 20



B.M. ELEV.	F.B.	<b>WARDROP</b> Engineering Inc.	ORIGINAL DRAWING REVISION "00" SEALED BY E.F. SHEHATA 08.02.04
DESIGNED BY E.F.S.	CHECKED BY [Signature]	DRAWN BY G.I./P.S.	APPROVED BY [Signature]
ISSUED FOR ADDENDUM #2 08.03.05	DATE 08.02.05		
ISSUED FOR TENDER 08.02.05	DATE 08.02.05	HOR. SCALE: AS NOTED	DATE 08.02.05
NO. REVISIONS	DATE BY	VERTICAL: AS NOTED	DATE 08.02.05
		ACCEPTED BY [Signature]	DATE
		RANDY FRANKS, P. ENG. BRIDGE PROJECT ENGINEER	CONSULTANT DRAWING NO. 0600070700-DWG-S1117-00

**THE CITY OF WINNIPEG**  
PUBLIC WORKS DEPARTMENT  
TRANSPORTATION ENGINEERING DIVISION

**Winnipeg**

**FORT GARRY TWIN BRIDGES**  
WESTBOUND STRUCTURE REHABILITATION  
AND ASSOCIATED ROADWORKS

**EAST ABUTMENT - CONCRETE DETAILS 3**

CITY DRAWING NUMBER  
**B173-08-017W**  
SHEET 17 OF 54

17