


Drawing 01-R2

- Upper Cabinet
 - Lower Cabinet
 - Work Surfaces
 - Emerg. Lighting
- CFW20M3024 Part Number (Typical)

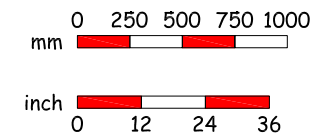

SCALE: 1" = 3'



DATE: November 13, 2009

Laboratory
RN 339
(Drawing 1 of 2)