



1 ELEVATION THROUGH TUNNEL LOOKING EAST
SCALE 1:500

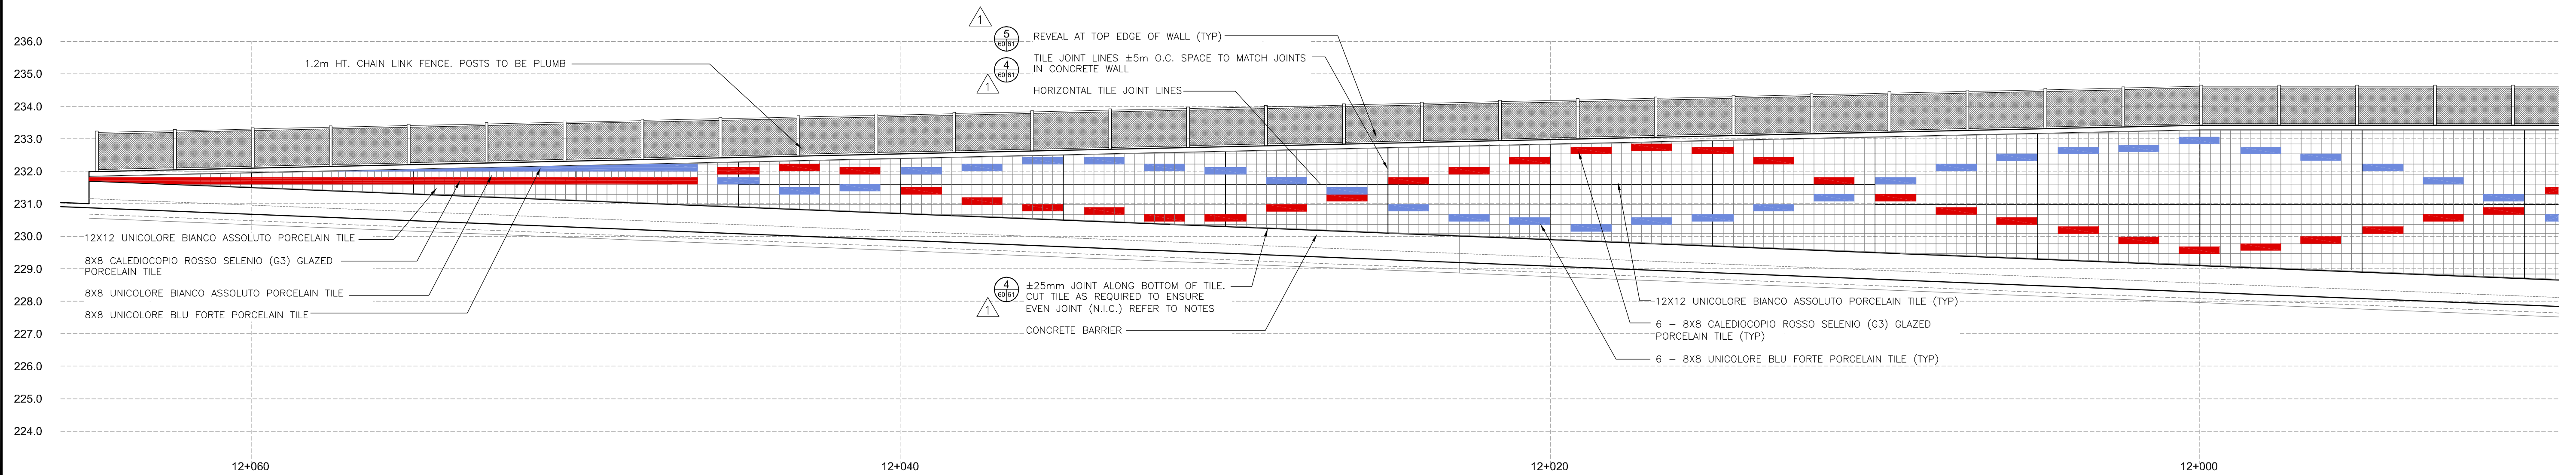

2 DETAIL ELEVATION - NORTH END
SCALE 1:100

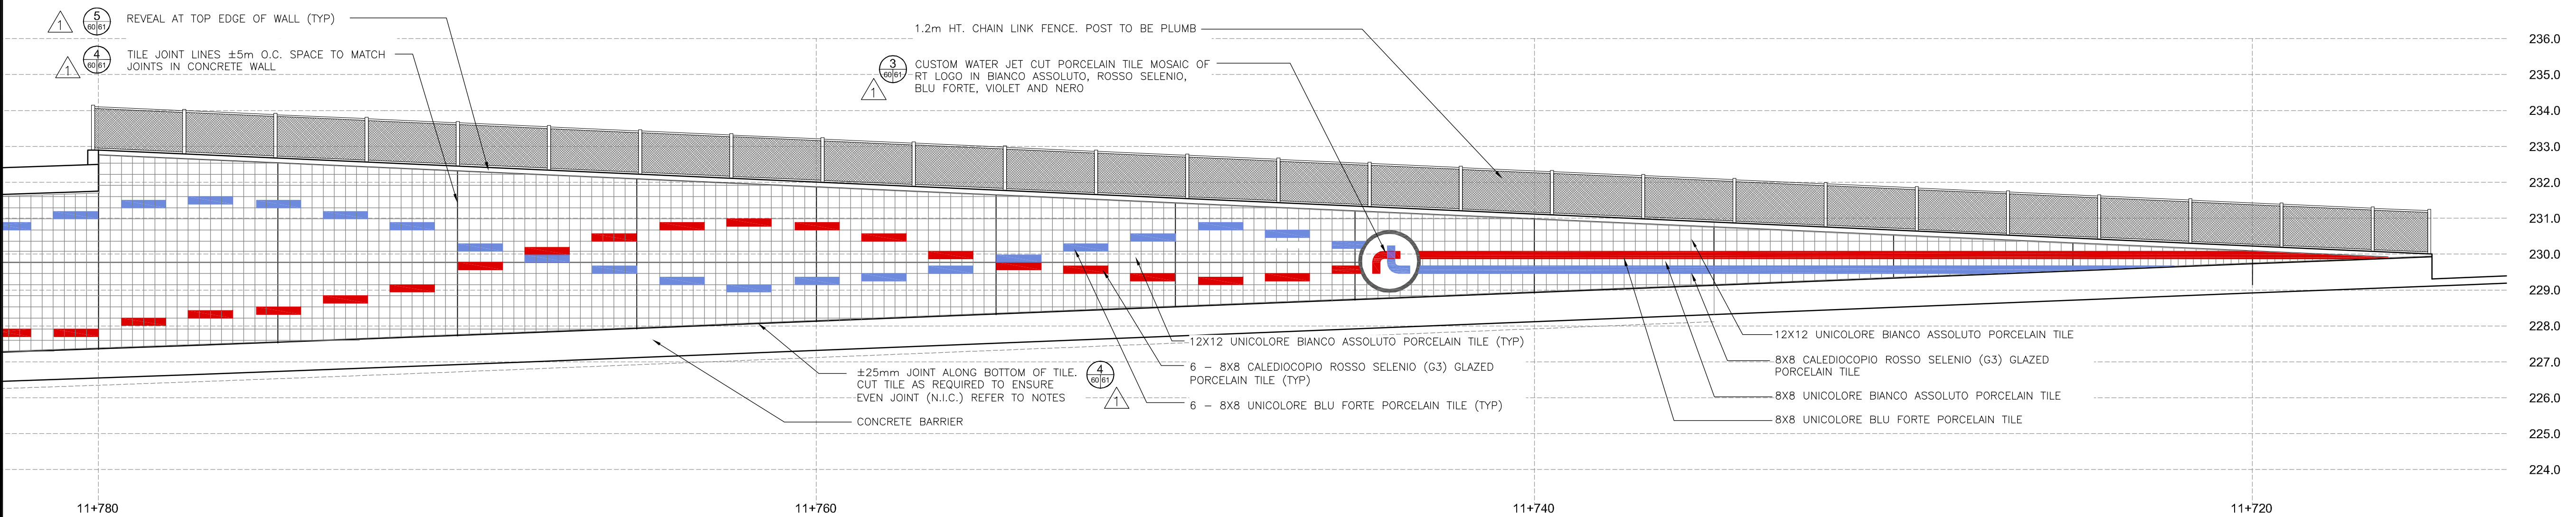

3 DETAIL ELEVATION - SOUTH END
SCALE 1:100

NOTES:
1. ALL TILE LAYOUTS SHOWN ARE APPROXIMATE AND ARE TO BE USED FOR GENERAL LAYOUT ONLY. CONTRACTOR TO LAYOUT TILE ON SITE FOR REVIEW AND APPROVAL BY CONTRACT ADMINISTRATOR PRIOR TO INSTALLATION.
2. CONTRACTOR TO STOP TILING ONE COURSE ABOVE LINE OF FUTURE BARRIER. TILES TO BE LEFT SQUARE. DO NOT CUT BOTTOM ROW OF TILES. STEP INSTALLATION. LEAVE EDGE CLEAN AND PREPARED FOR FUTURE TILE INSTALLATION BY OTHERS.

NO.	REVISIONS	DATE	BY
1	ISSUED FOR ADDENDUM 4	4/11/09	JW
0	ISSUED FOR TENDER	05/10/09	JW

DESIGNED BY	SR/JW
DRAWN BY	JW
CHECKED BY	SR
APPROVED BY	BM
HOR. SCALE	AS NOTED
VERTICAL	
DATE	2009/10/05

LOCATION UNDERGROUND STRUCTURES	APPROVED STRUCTURES	B.M. ELEV.	BM ELEV.
SUPV. U/O STRUCTURES COMMITTEE	DATE		

DESIGNED BY SR/JW
DRAWN BY JW
CHECKED BY SR
APPROVED BY BM
HOR. SCALE AS NOTED
VERTICAL
DATE 2009/10/05

RELEASED FOR CONSTRUCTION
DATE

DILLON CONSULTING

the Manitoba Association of Professional Engineers
JACQUELINE L. WILKIE
member no. 75
ORIGINALLY STAMPED BY
JACKIE WILKIE 05/10/09
CONSULTANT PROJECT NO.
088813

THE CITY OF WINNIPEG TRANSIT DEPARTMENT

Winnipeg

SOUTHWEST RAPID TRANSIT CORRIDOR - STAGE 1
TRANSITWAY TUNNEL AT CN RIVERS SUBDIVISION
MILEAGE 1.38 & ASSOCIATED WORKS

TILE PATTERN LAYOUT
EAST WALL

CITY DRAWING NUMBER
U237-09-60
SHEET 60 OF 73
CONSULTANT DRAWING NUMBER
C4-S1302-T