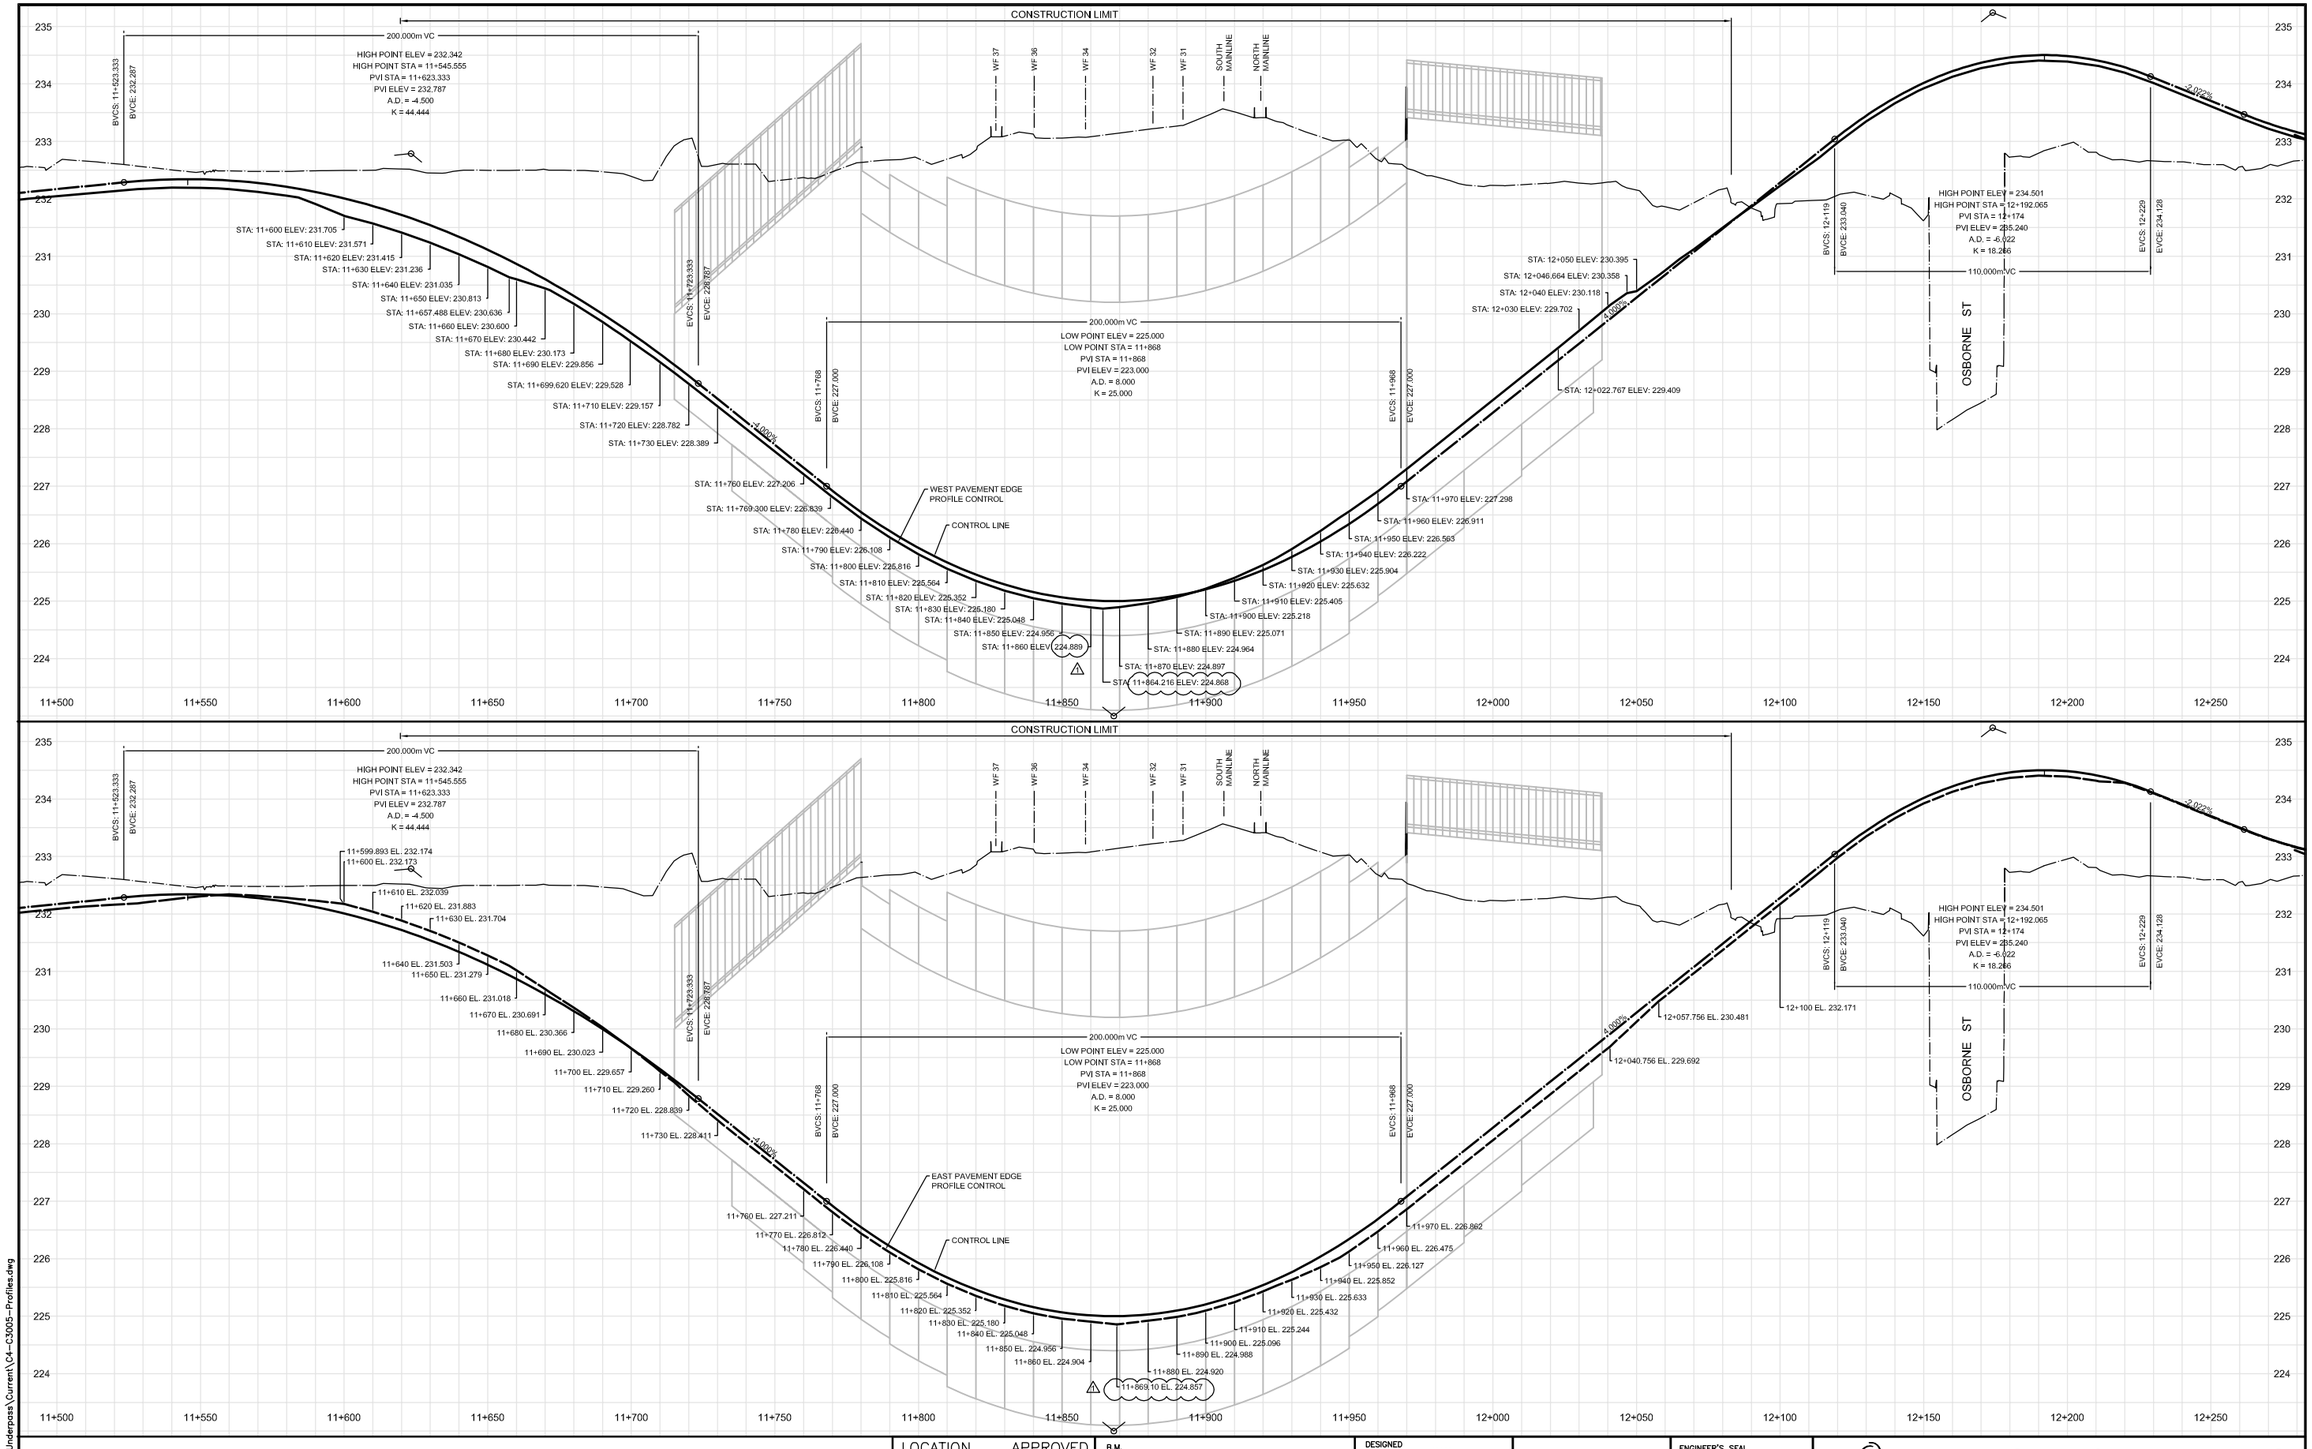

G:\040\088813\Contract\Contract 4 - Underpass\Current\C4-C3005-Profiles.dwg

APEGM
Certificate of Authorization
Dillon Consulting Limited (MB)
No. 1789 Date: 10/13/2009

LOCATION UNDERGROUND APPROVED STRUCTURES

SUPV. U/G STRUCTURES COMMITTEE _____ DATE _____

NOTE:
LOCATION OF UNDERGROUND STRUCTURES AS SHOWN ARE BASED ON THE BEST INFORMATION AVAILABLE, BUT NO GUARANTEE IS GIVEN THAT ALL EXISTING UTILITIES ARE SHOWN OR THAT THE GIVEN LOCATIONS ARE EXACT. CONFIRMATION OF EXISTENCE AND EXACT LOCATION OF ALL SERVICES MUST BE OBTAINED FROM THE INDIVIDUAL UTILITIES BEFORE PROCEEDING WITH CONSTRUCTION.

B.M. ELEV.

NO.	REVISIONS	DATE	BY
1	ISSUED FOR ADDENDUM #4	11.04.2009	TJH
0	ISSUED FOR TENDER	10.13.2009	TJH

DESIGNED BY	RTP
DRAWN BY	RTP/TJH
CHECKED BY	DPK
APPROVED BY	DPK
HOR. SCALE	1 : 1000
VERTICAL	1 : 50
DATE	10/13/2009

DILLON CONSULTING

RELEASED FOR CONSTRUCTION

DATE

ENGINEER'S SEAL
PROVINCE OF MANITOBA
ORIGINAL STAMPED BY
D.P. KRAHN
10/13/2009
Member
4226
REGISTERED PROFESSIONAL ENGINEER

CONSULTANT PROJECT NO.
088813

Winnipeg

THE CITY OF WINNIPEG
TRANSIT DEPARTMENT

SOUTHWEST RAPID TRANSIT CORRIDOR - STAGE 1
TRANSITWAY TUNNEL AT CN RIVERS SUBDIVISION
MILEAGE 1.38 & ASSOCIATED WORKS

TUNNEL PROFILE

CITY DRAWING NUMBER: U237-09-67
SHEET: 67 OF 73
CONSULTANT DRAWING NUMBER: C4-C3005-T