



NOTE:  
1. 6 PEDESTALS REQUIRED, LOCATION TO BE COORDINATED WITH SHORING SPECIFICATIONS.

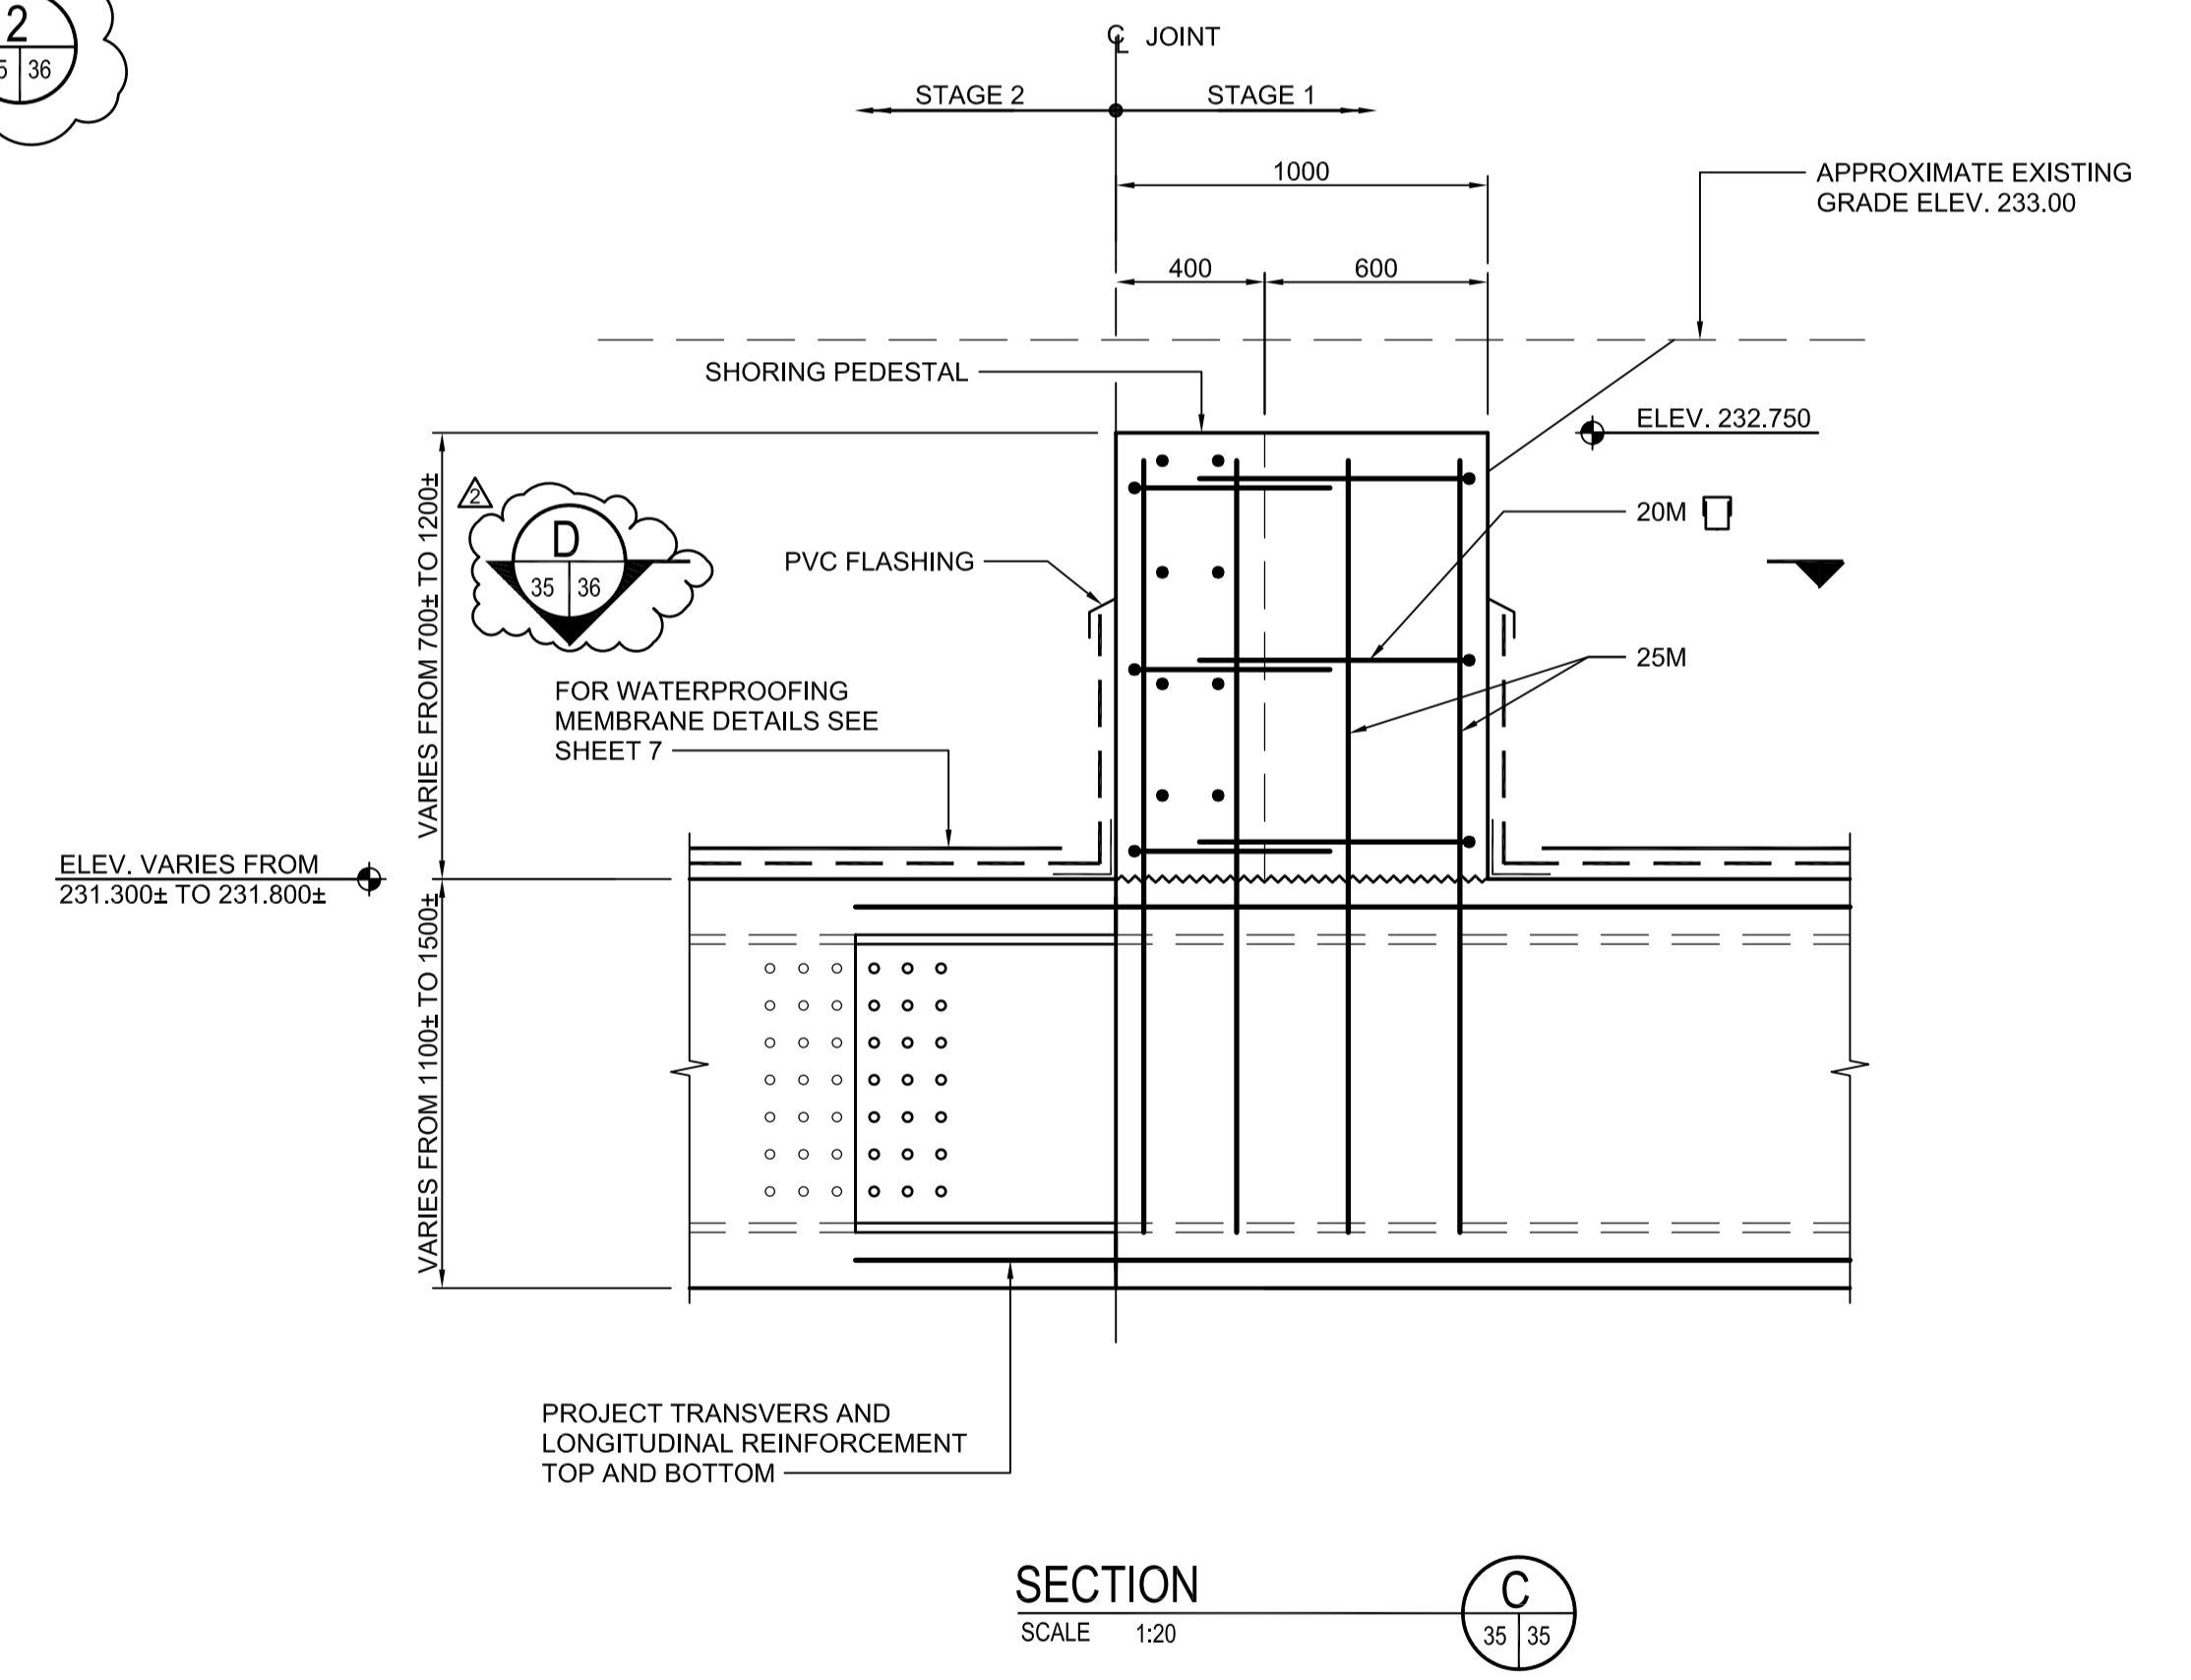

G:\csc\088813\Contract\Contract - 1\Current\C4-S1112-P.dwg

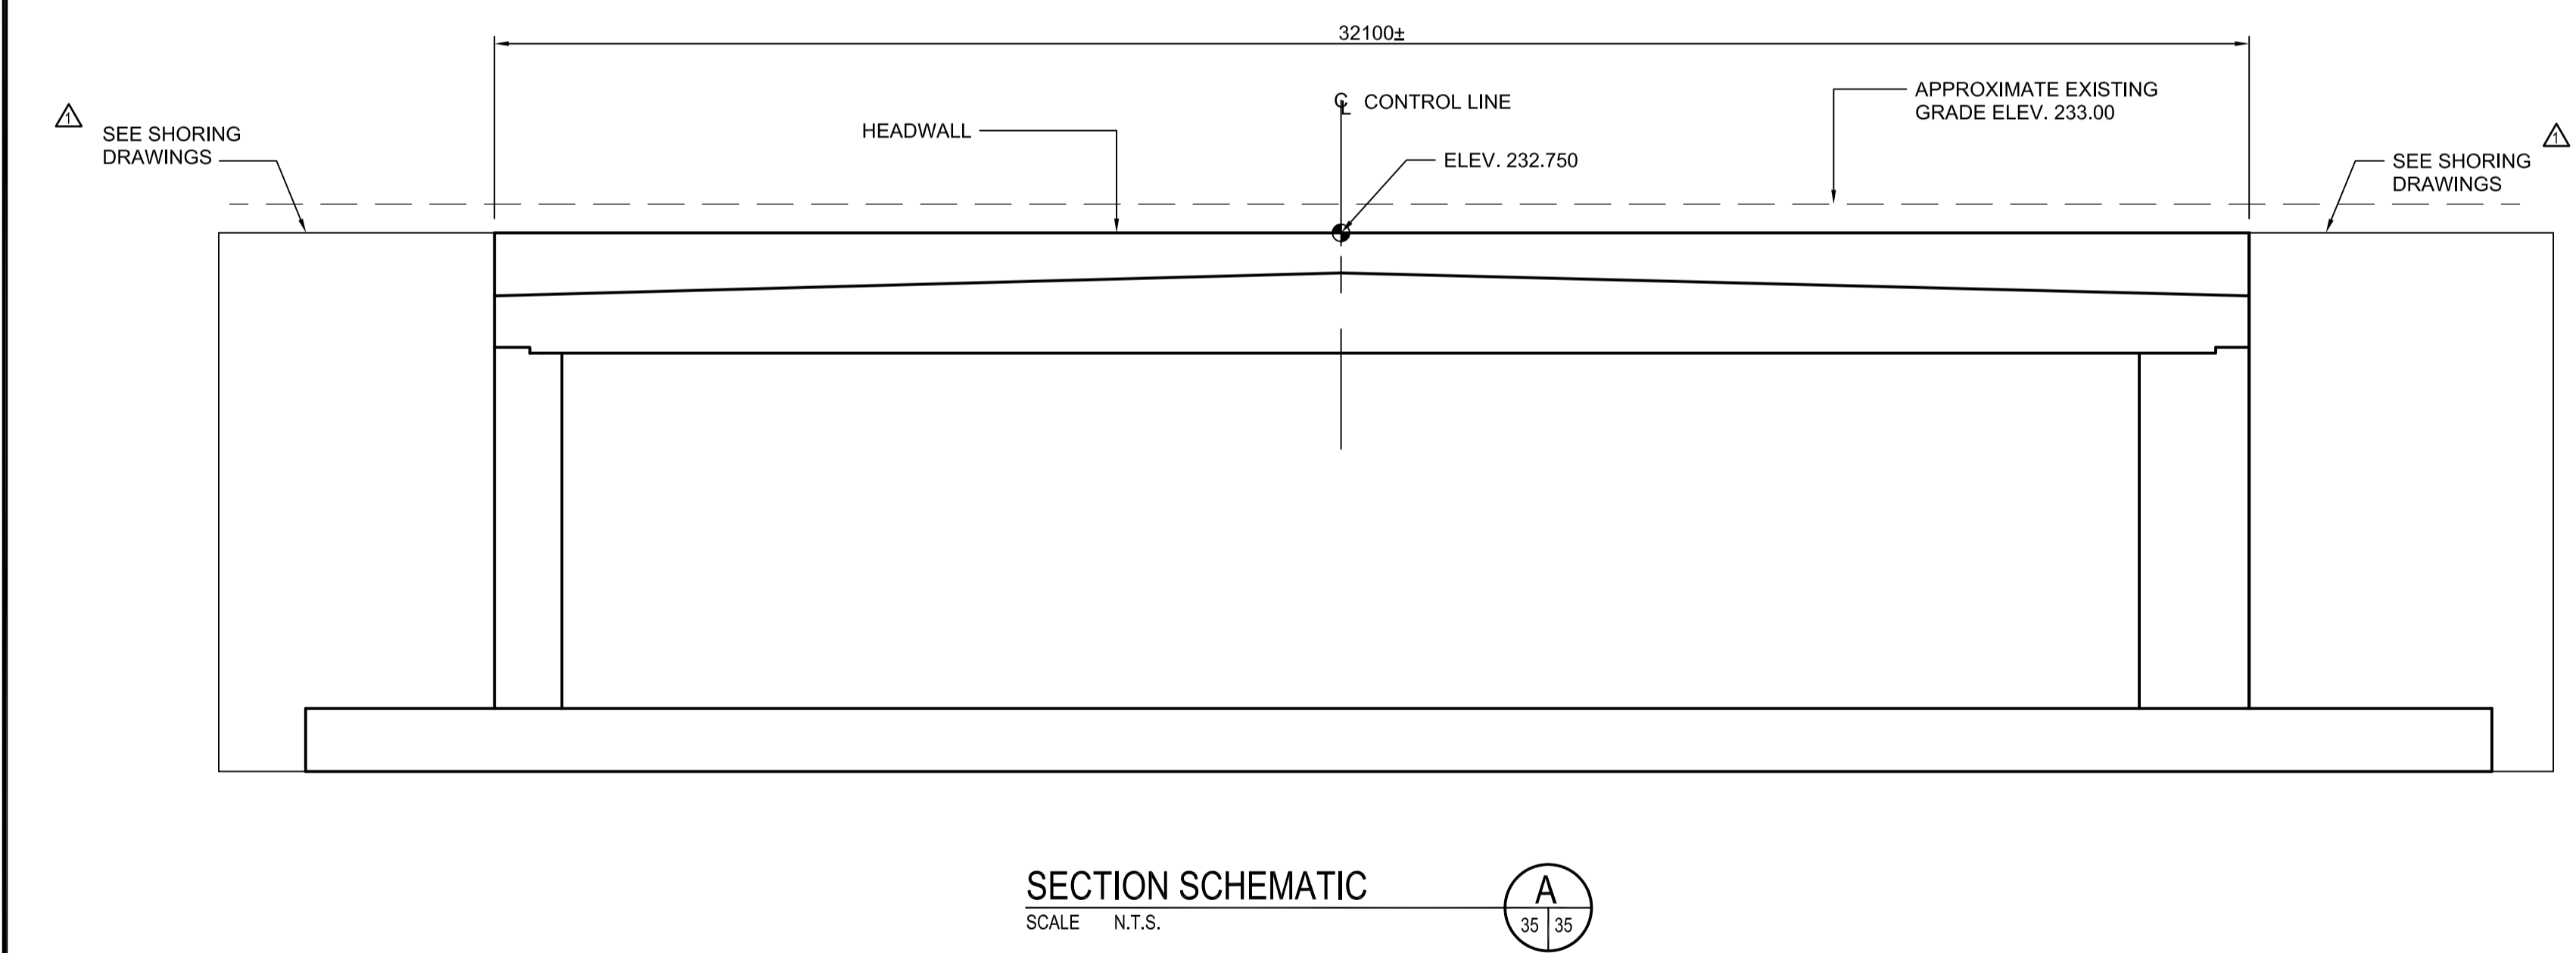

LOCATION UNDERGROUND APPROVED STRUCTURES SUPV. U/G STRUCTURES COMMITTEE DATE	B.M. ELEV.	DESIGNED BY: KGW DRAWN BY: RCB CHECKED BY: KGW APPROVED BY: DPK		ENGINEER'S SEAL 		SOUTHWEST RAPID TRANSIT CORRIDOR - STAGE 1 TRANSITWAY TUNNEL AT CN RIVERS SUBDIVISION MILEAGE 1.38 & ASSOCIATED WORKS	CITY DRAWING NUMBER U237-09-35 SHEET 35 OF 73																			
NOTE: LOCATION OF UNDERGROUND STRUCTURES AS SHOWN ARE BASED ON THE BEST INFORMATION AVAILABLE BUT NO GUARANTEE IS GIVEN THAT ALL EXISTING UTILITIES ARE SHOWN OR THAT THE GIVEN LOCATIONS ARE EXACT. CONFIRMATION OF EXISTENCE AND EXACT LOCATION OF ALL SERVICES MUST BE OBTAINED FROM THE INDIVIDUAL UTILITIES BEFORE PROCEEDING WITH CONSTRUCTION.	<table border="1"> <tr> <th>NO.</th> <th>REVISIONS</th> <th>DATE</th> <th>BY</th> <th>DATE</th> </tr> <tr> <td>2</td> <td>ISSUED WITH ADDENDUM #5</td> <td>11/10/2009</td> <td>RCB</td> <td></td> </tr> <tr> <td>1</td> <td>ISSUED WITH ADDENDUM #4</td> <td>11/04/2009</td> <td>RCB</td> <td></td> </tr> <tr> <td>0</td> <td>ISSUED FOR TENDER</td> <td>10/13/2009</td> <td>RCB</td> <td></td> </tr> </table>	NO.	REVISIONS	DATE	BY	DATE	2	ISSUED WITH ADDENDUM #5	11/10/2009	RCB		1	ISSUED WITH ADDENDUM #4	11/04/2009	RCB		0	ISSUED FOR TENDER	10/13/2009	RCB		HOR. SCALE AS SHOWN VERTICAL AS SHOWN	RELEASED FOR CONSTRUCTION DATE	CONSULTANT PROJECT NO. 088813	HEADWALL DETAILS SHEET 1 OF 2	CONSULTANT DRAWING NUMBER C4-S1112-T
NO.	REVISIONS	DATE	BY	DATE																						
2	ISSUED WITH ADDENDUM #5	11/10/2009	RCB																							
1	ISSUED WITH ADDENDUM #4	11/04/2009	RCB																							
0	ISSUED FOR TENDER	10/13/2009	RCB																							