



\\FLEESER\Studio_Share\0002_Current_Projects\Projects\0727 Assiniboine Park Zoo Pavilion\6. Contract Administration\6.1.4 Addenda\addendum.1 drawings\0727 - ADD 1.4 - 46 Int. Elevations.dwg

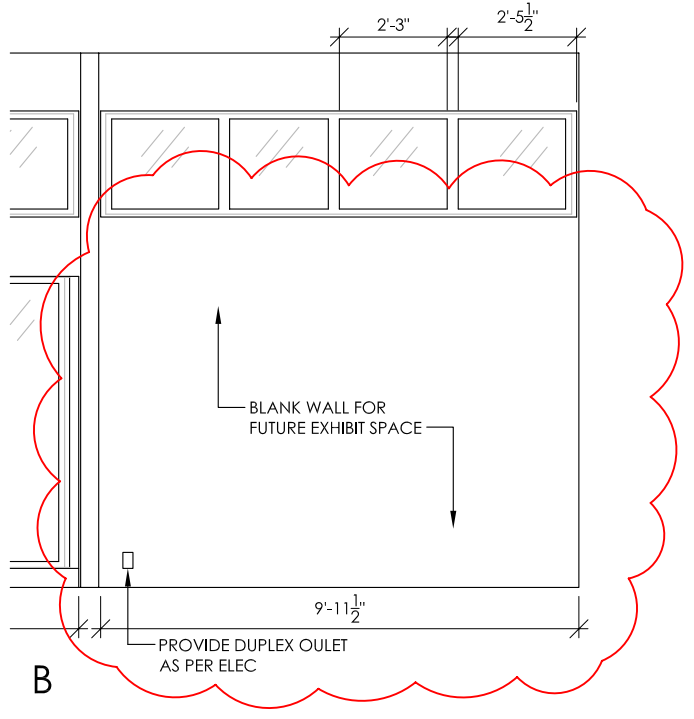

B

1 PAVILION - RM 103
1/4" = 1'-0"

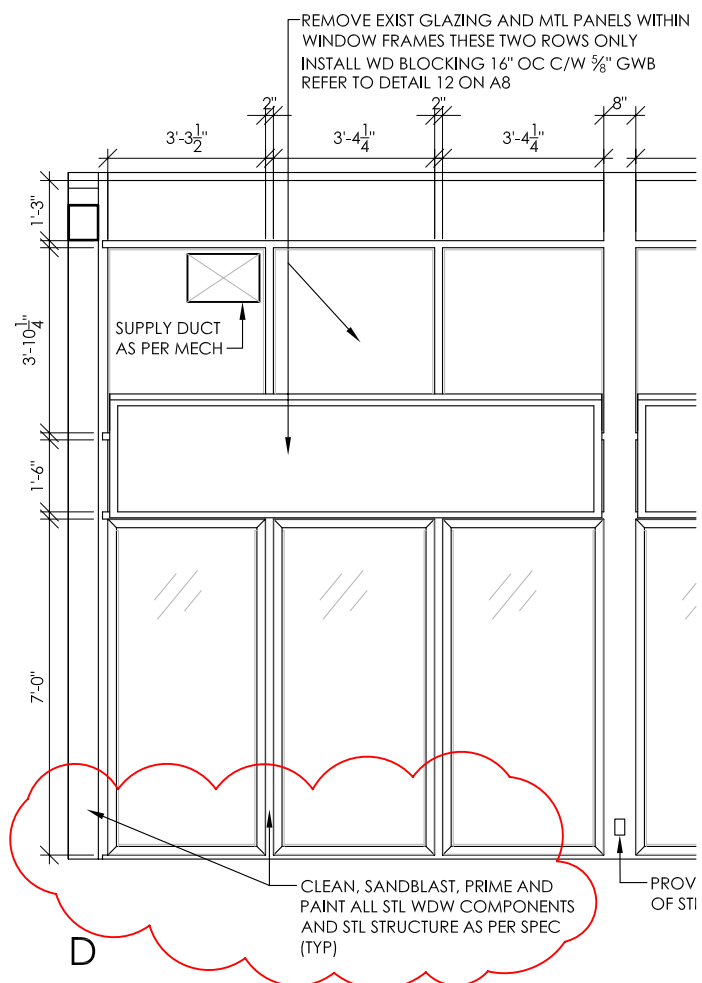

D

1 PAVILION - RM 103
1/4" = 1'-0"

Project:
Assiniboine Park Zoo
Asiatic Lion Pavilion Winnipeg, MB

Drawing Title:
INTERIOR
ELEVATIONS

Project Number: 0727

Sheet No:

Date: 09_MAR_09

ADD

ADDENDUM

1.4

678 MAIN STREET WINNIPEG, MB R3B 1E4
204 488 3857 tel. 204 488 0216 fax. www.bridgmancollaborative.ca

bridgmancollaborative
ARCHITECTURE

bridgmancollaborative

This drawing is property of the Architect and cannot be reproduced or used without the consent of the Architect. The contractor is responsible for checking and verifying all levels and dimensions and shall report all discrepancies to the Architect and obtain clarification prior to commencing work.