


6 PLAN DETAIL
1-1/2" = 1'-0"

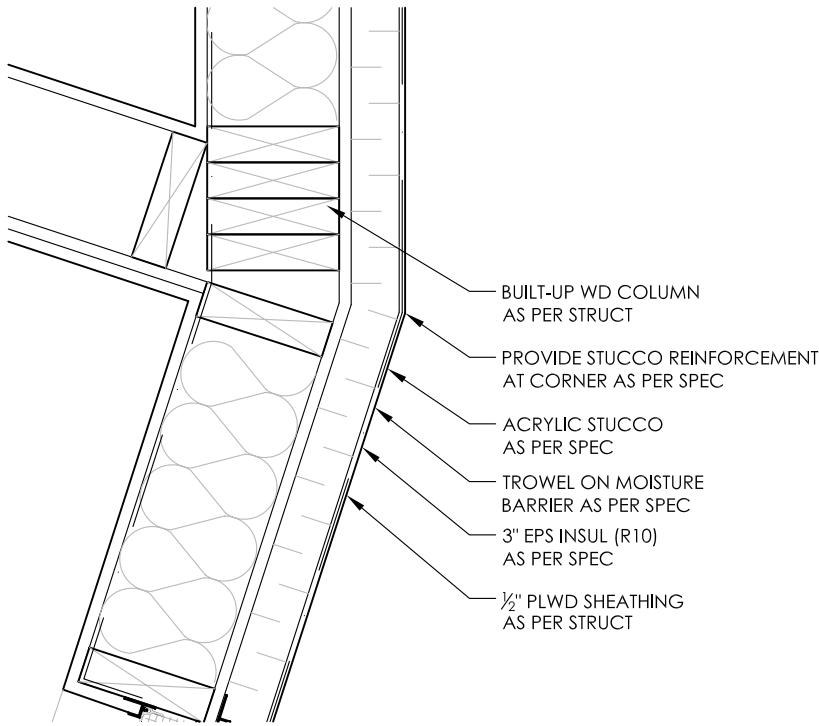

2 PLAN DETAIL
1-1/2" = 1'-0"

Project:
Assiniboine Park Zoo
Asiatic Lion Pavilion Winnipeg, MB

Drawing Title:
REVISED
DETAILS

Project Number: 0727 Sheet No:
Date: 09_MAR_09 **ADD**
ADDENDUM 1.6