

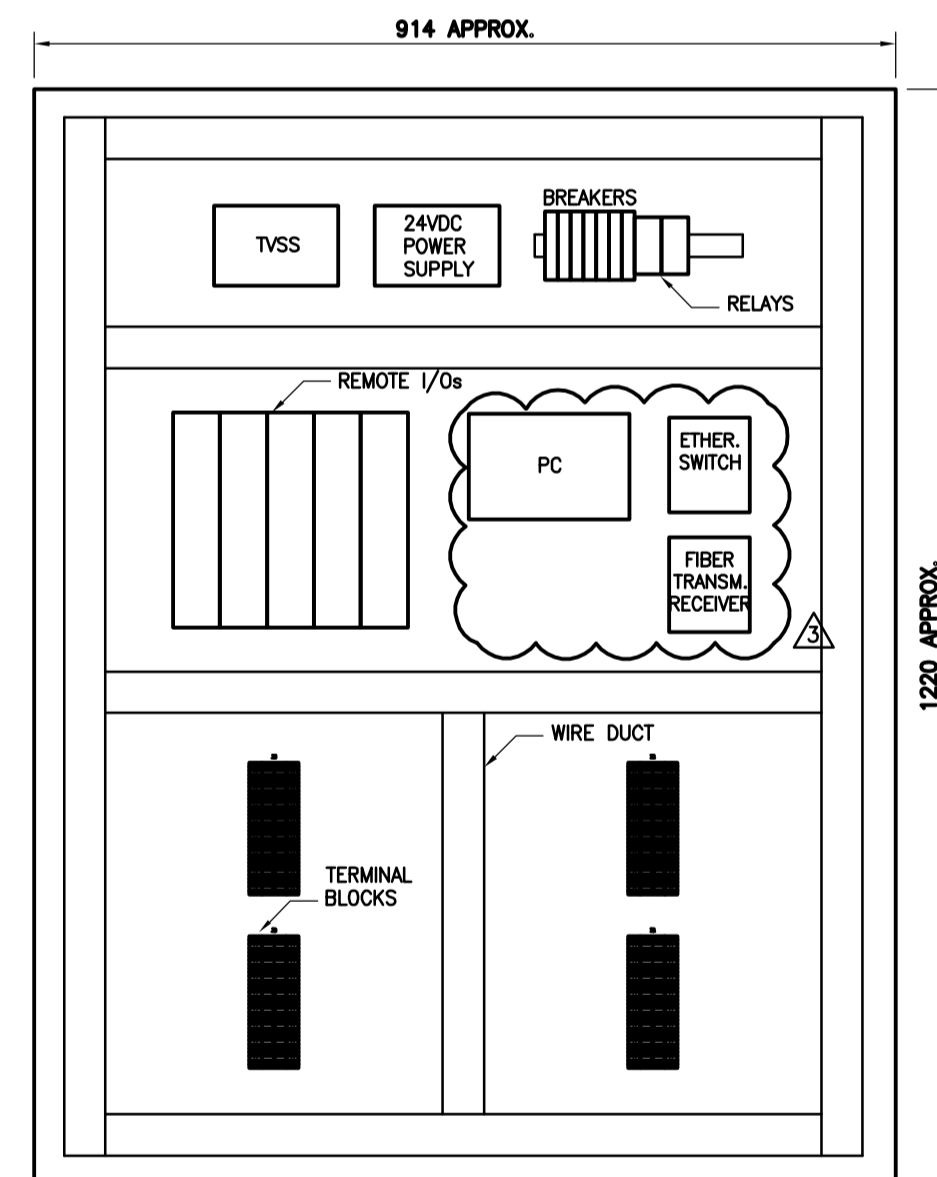
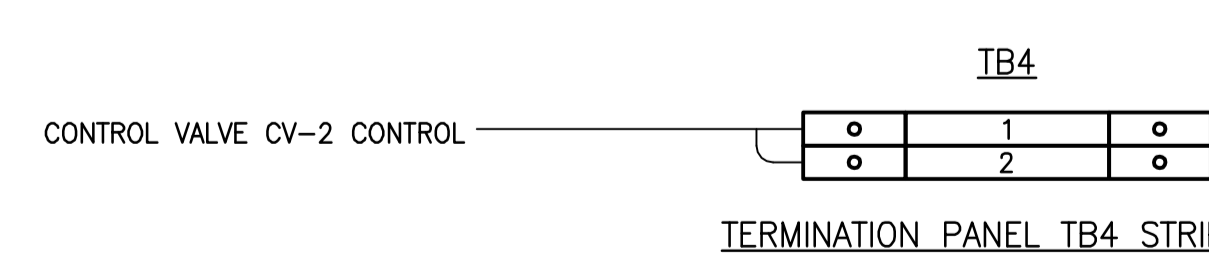
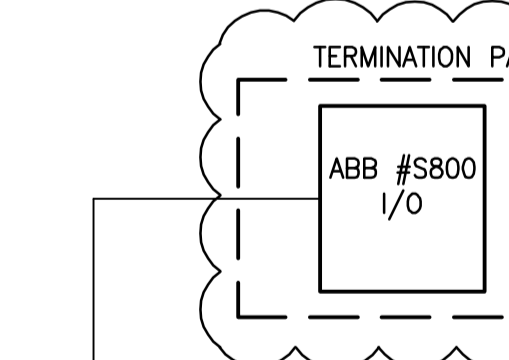
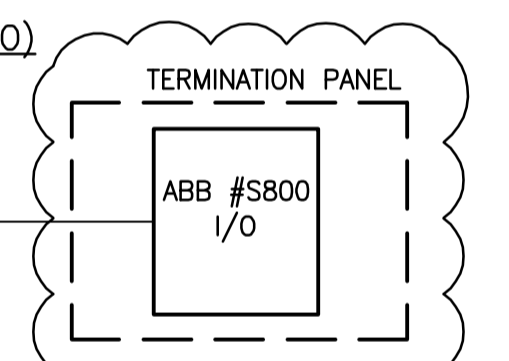
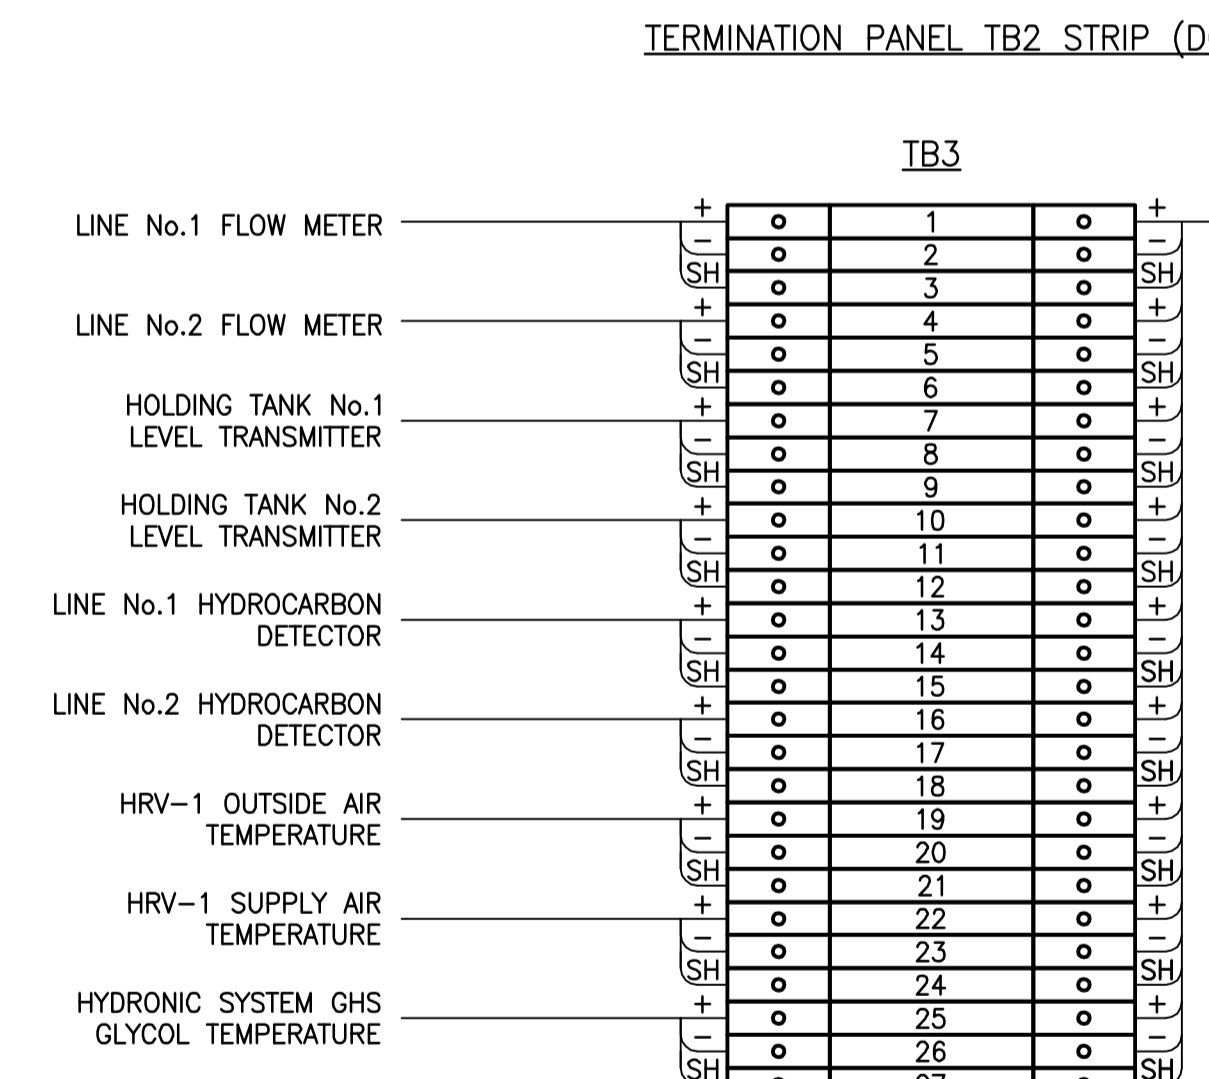
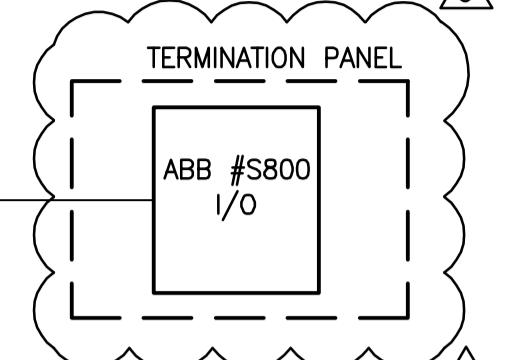
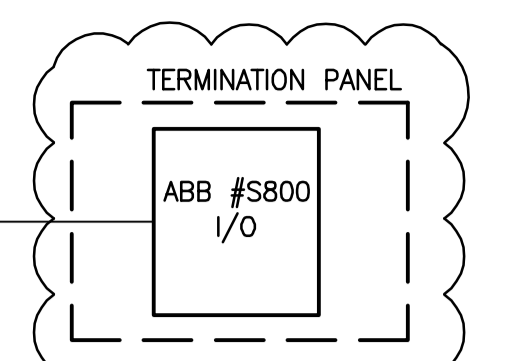


TERMINATION PANEL WIRING DETAIL

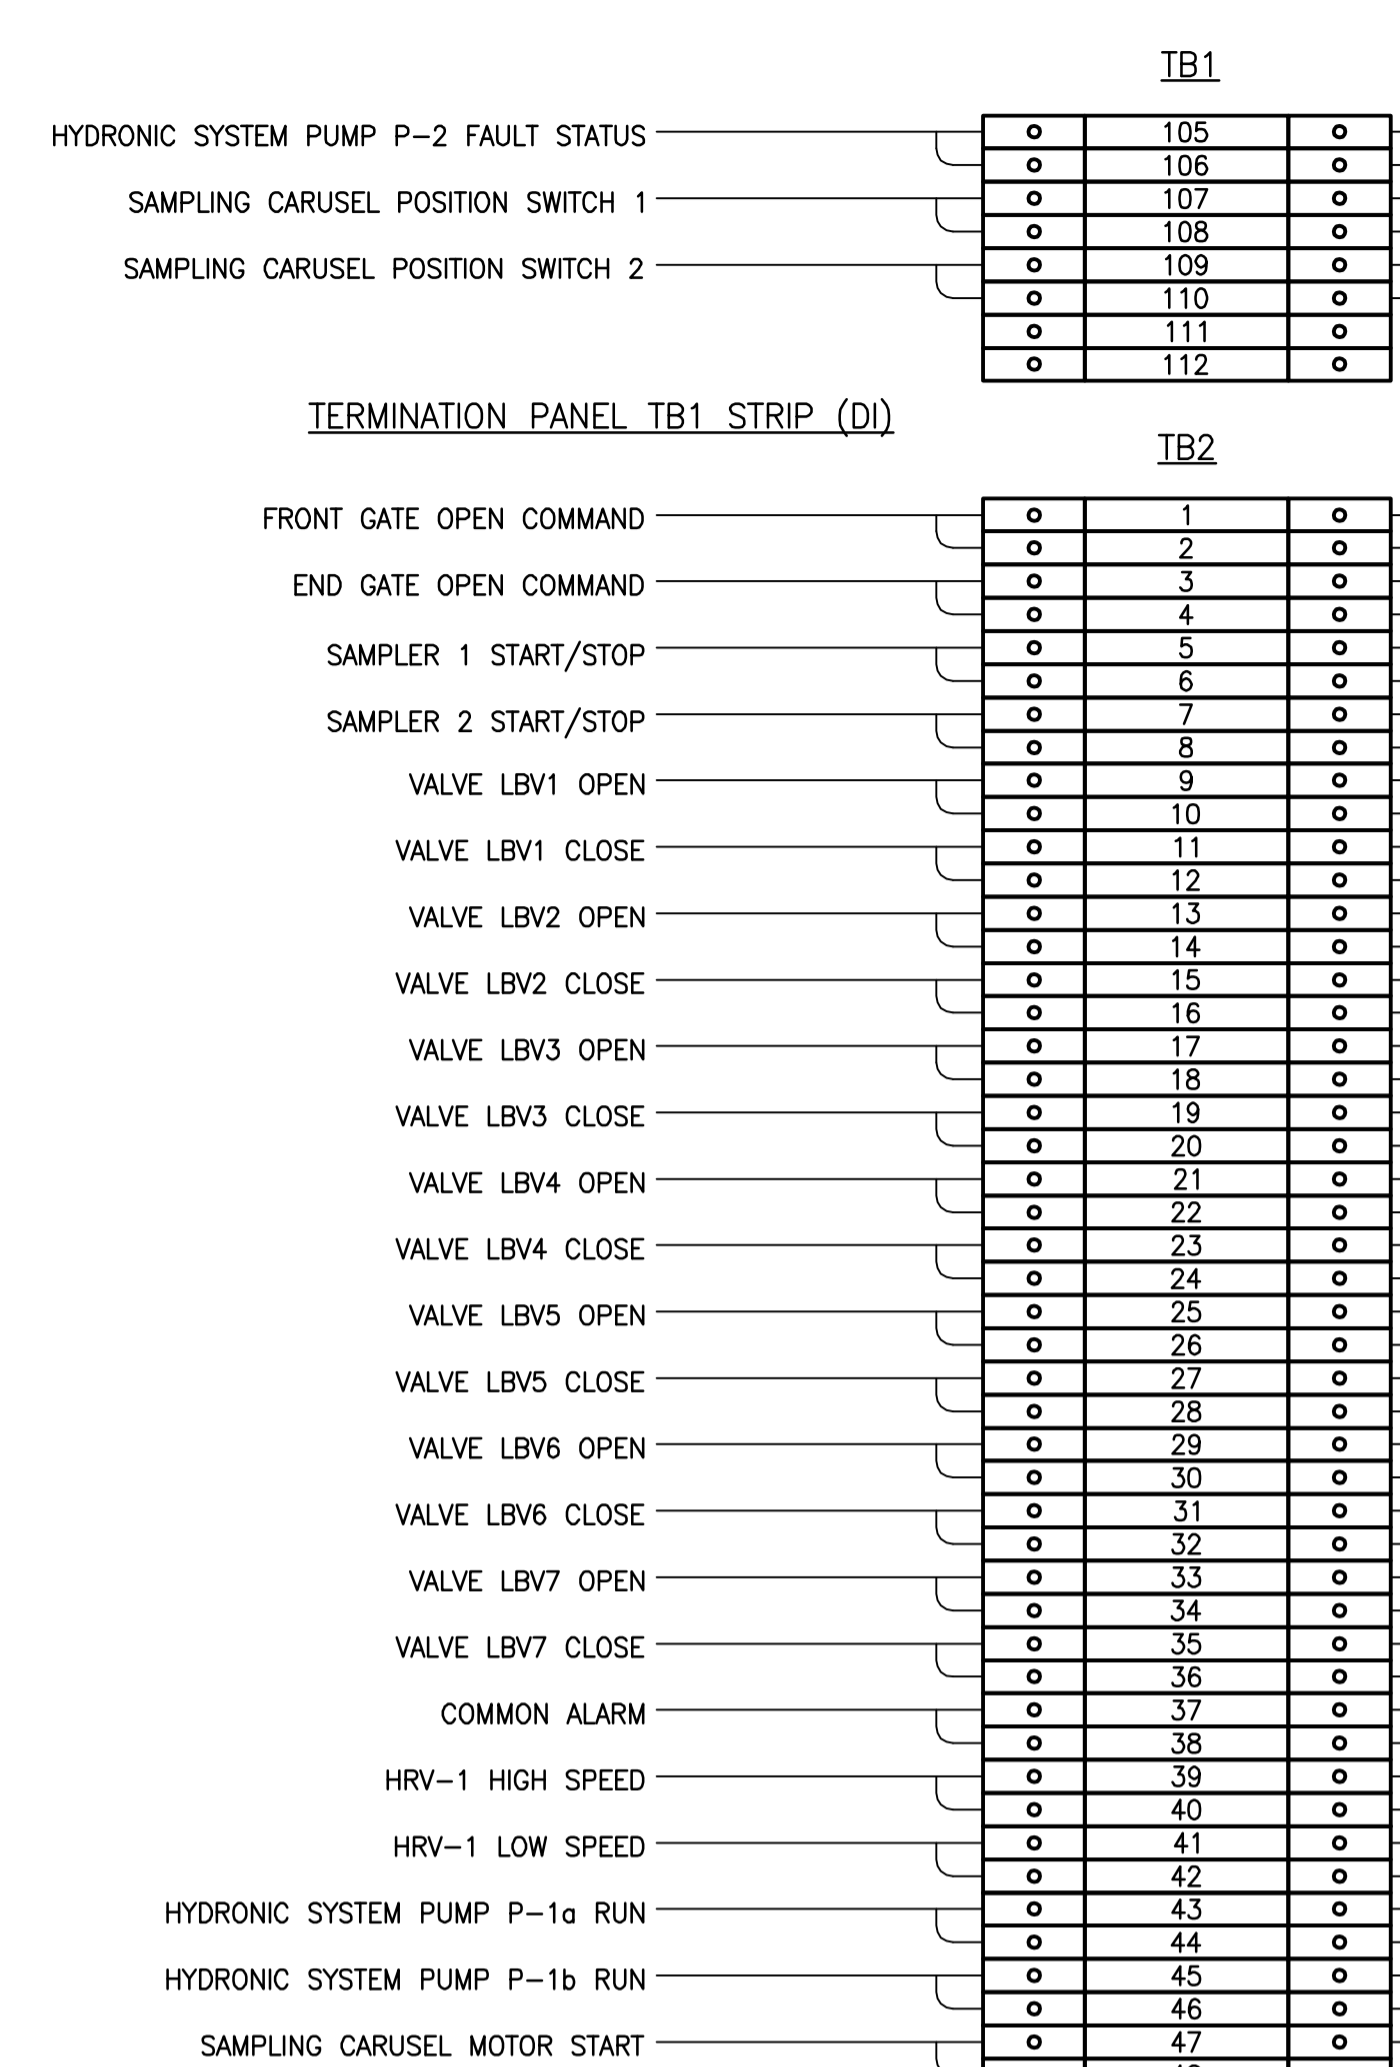

TERMINATION PANEL WITH REMOTE I/Os AND PC

SAMPLER 1 HOA SWITCH IN HAND			
SAMPLER 1 HOA SWITCH IN AUTO			
SAMPLER 2 RUN STATUS			
SAMPLER 2 FAULT STATUS			
SAMPLER 2 HOA SWITCH IN HAND			
SAMPLER 2 HOA SWITCH IN AUTO			
SUMP PIT HIGH LEVEL			
BOILER B-1a RUN STATUS			
BOILER B-1b RUN STATUS			
HRV-1 FILTER HIGH DIFF. PRESS.			
HRV-1 RETURN FILTER HIGH DIFF. PRESS.			
HRV-1 SUPPLY AIR FLOW SWITCH			
HYDRONIC SYSTEM PUMP P-1a RUN STATUS			
HYDRONIC SYSTEM PUMP P-1a FAULT STATUS			
HYDRONIC SYSTEM PUMP P-1b RUN STATUS			
HYDRONIC SYSTEM PUMP P-1b FAULT STATUS			
HYDRONIC SYSTEM PUMP P-2 RUN STATUS			

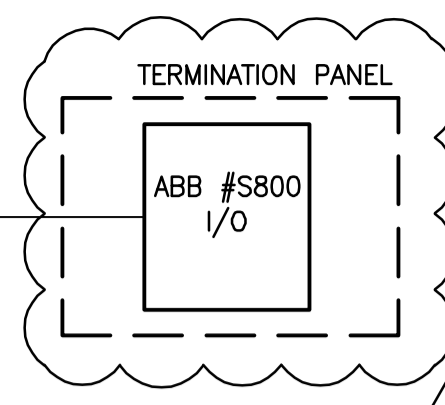

APEGM
Certificate of Authorization
Stantec Consulting Ltd.
No. 1301 Date: _____

V:\112\0000\11210300\Drawings\04_Monitoring\Sheet_Electrical\WEPCC\110300-100-mwpc.dwg 2009-11-20 02:17:04 By: wmmiller

METRIC
WHOLE NUMBERS INDICATE MILLIMETRES
DECIMALIZED NUMBERS INDICATE METRES

LOCATION APPROVED UNDERGROUND STRUCTURES		B.M. ELEV.
SUPV. U/G STRUCTURES COMMITTEE	DATE	
NOTE: LOCATION OF UNDERGROUND STRUCTURES AS SHOWN ARE BASED ON THE BEST INFORMATION AVAILABLE BUT NO GUARANTEE IS GIVEN THAT ALL EXISTING UTILITIES ARE SHOWN OR THAT THE GIVEN LOCATIONS ARE EXACT. CONFIRMATION OF EXISTENCE AND EXACT LOCATION OF ALL SERVICES MUST BE OBTAINED FROM THE INDIVIDUAL UTILITIES BEFORE PROCEEDING WITH CONSTRUCTION.		
1	REVISED AS PER ADDENDUM #3	
A	ISSUED FOR TENDER	10.02.16 S.T.
NO.	REVISIONS	DATE BY

Stantec Consulting Ltd.		ENGINEER'S SEAL
905 Waverley Street, Winnipeg, Manitoba Tel 204-489-5900 Fax 204-453-9012		ORIGINAL SEALED BY SLOBODAN TREBIC P. ENG. 10/02/16
DESIGNED BY S.T.	CHECKED BY D.D.	
DRAWN BY S.T.	APPROVED BY	
HOR. SCALE: -	RELEASED FOR CONSTRUCTION:	
VERTICAL:	DATE	

THE CITY OF WINNIPEG WATER AND WASTE DEPARTMENT		
Winnipeg		
NORTH END WATER POLLUTION CONTROL CENTRE HAULED WASTEWATER RECEIVING FACILITIES LEACHATE RECEIVING BUILDING		
CONTROL PANEL WIRING, DCS I/Os		
TENDER NO. 822-2009	CITY DRAWING NUMBER I-OIOIA-A0003-001	SHEET 1 OF 1