



KEY PLAN
SCALE: NTS

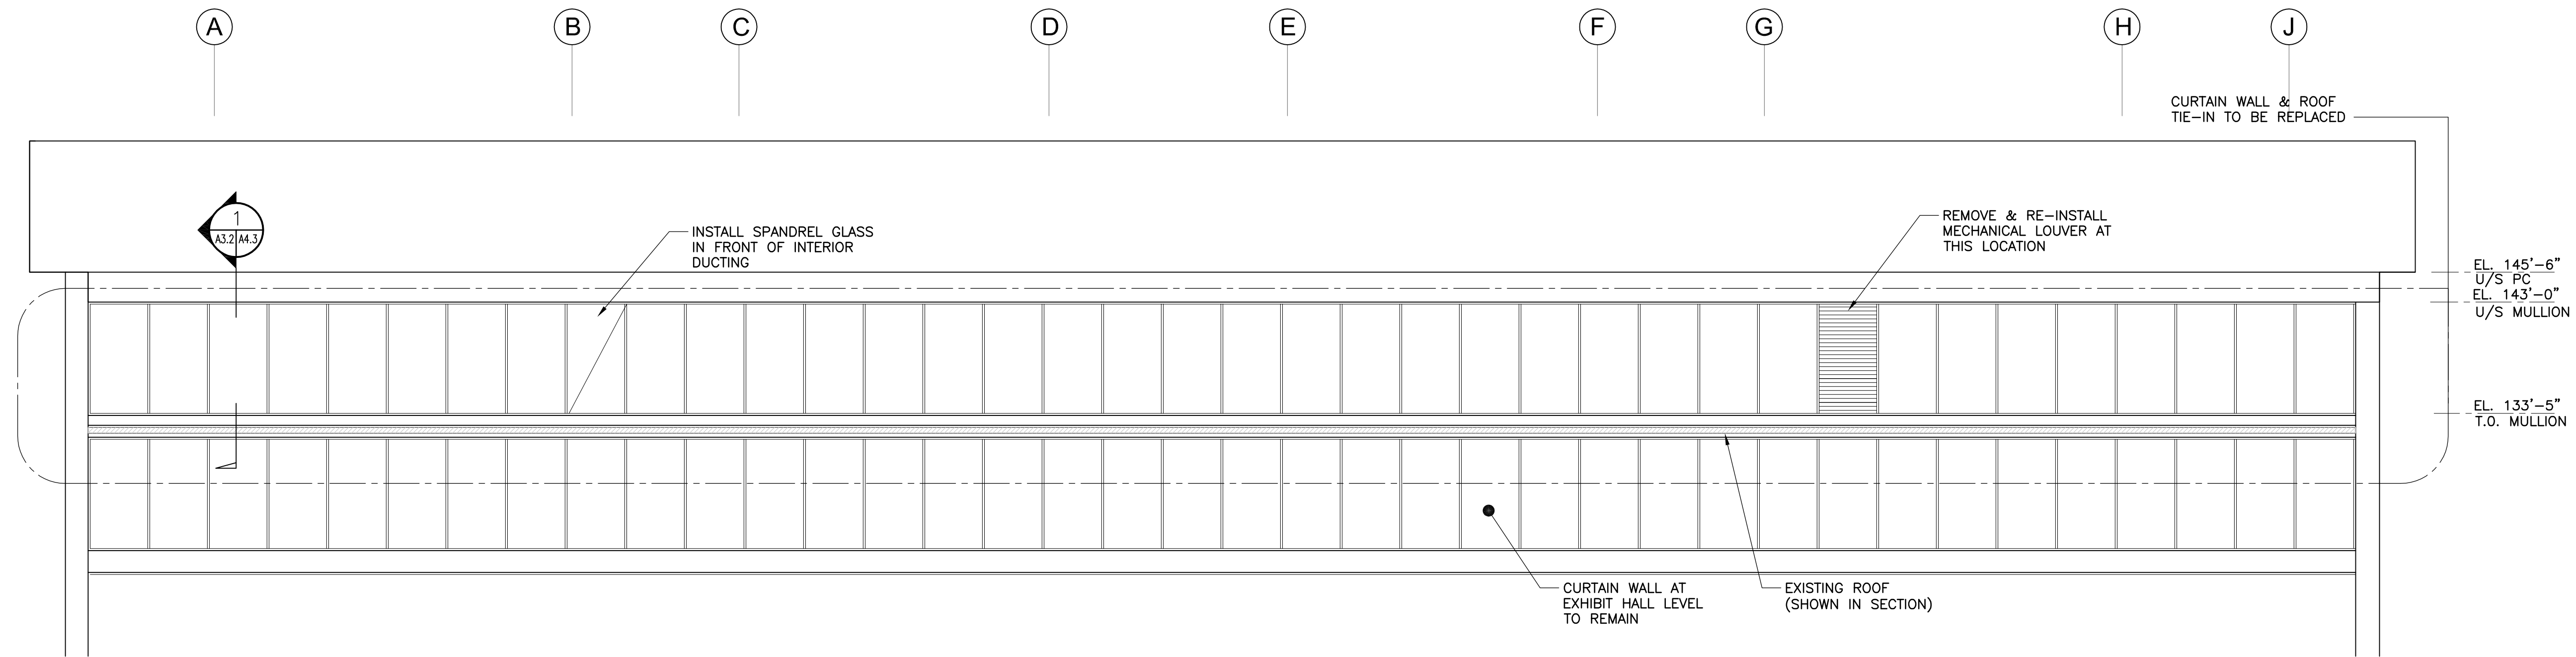


1 PARTIAL ELVATION-WEST
SCALE: 1/8"=1'-0"

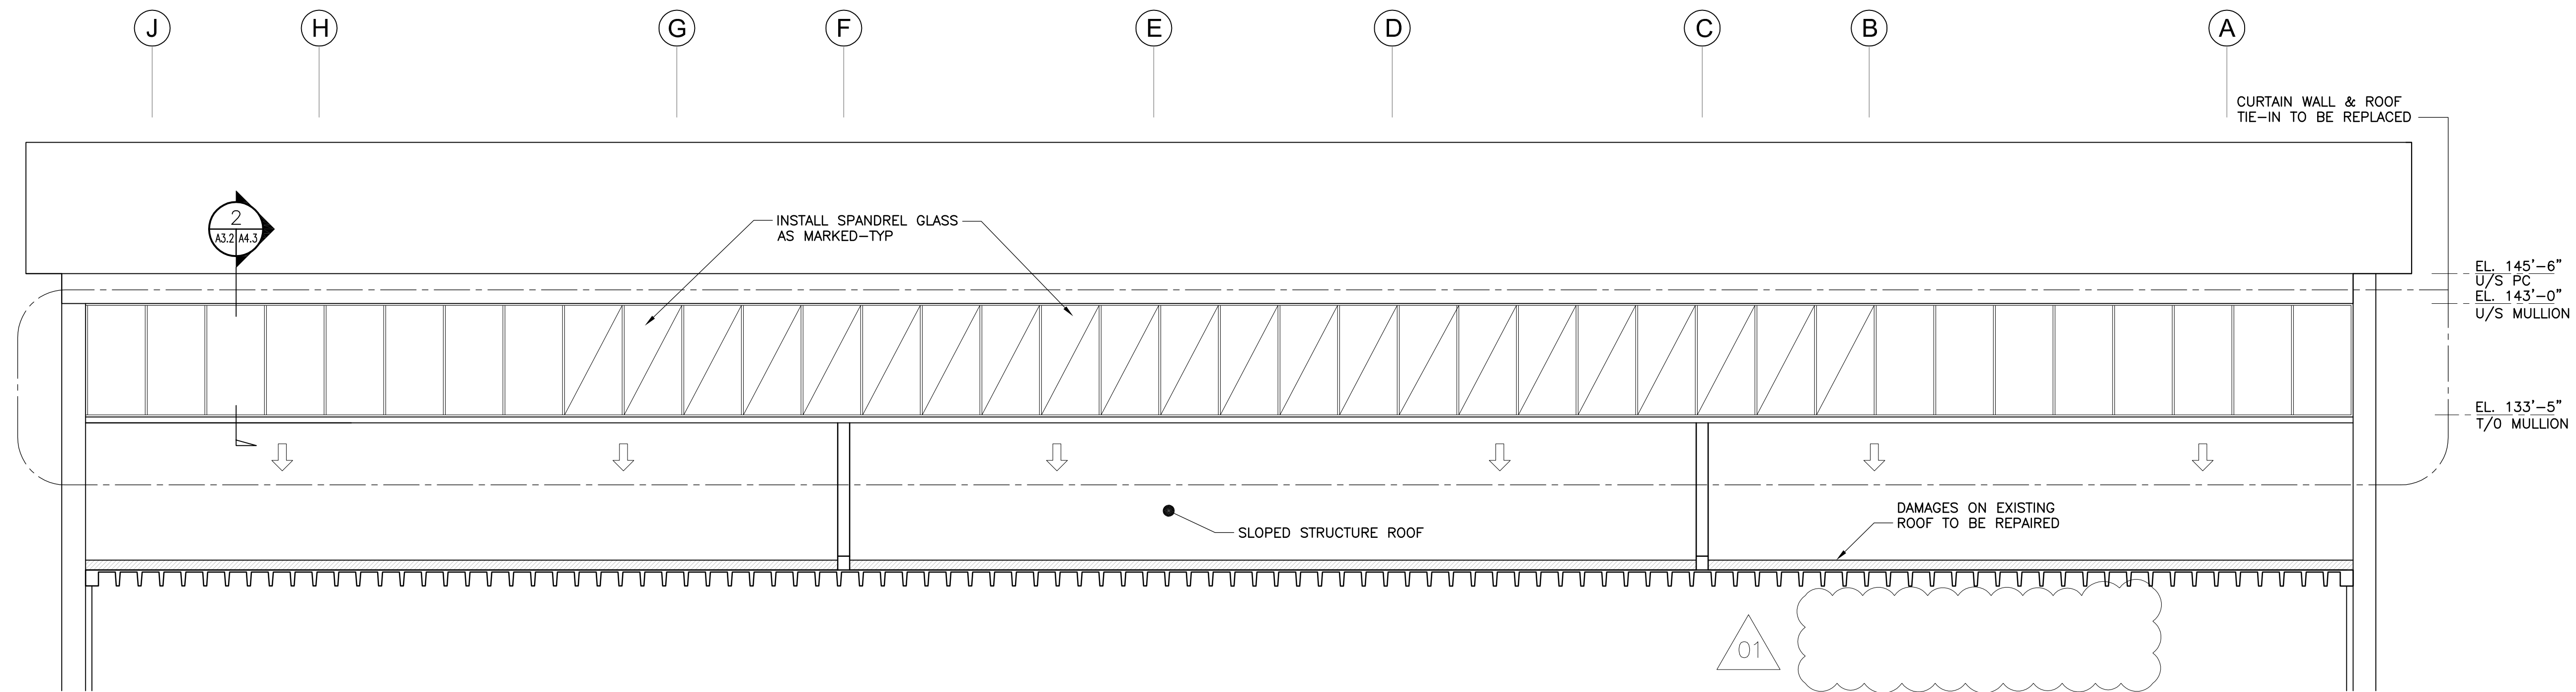

2 PARTIAL ELVATION-EAST
SCALE: 1/8"=1'-0"

REV	DESCRIPTION	DATE	BY
01	ISSUED FOR ADDENDUM-01	MAR 16, 2010	AL
00	ISSUED FOR TENDER	MAR 02, 2010	AL

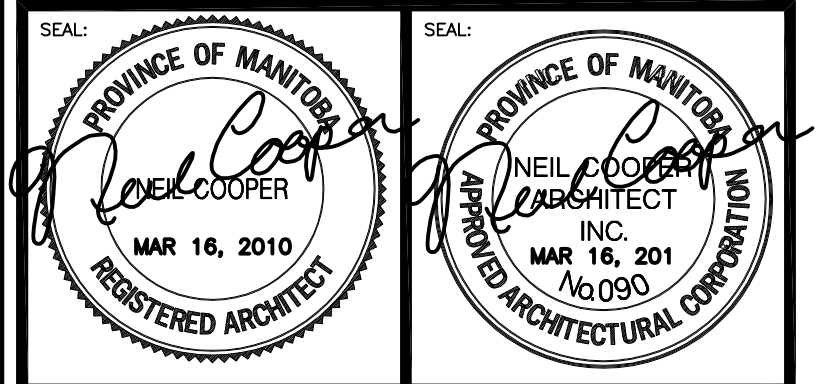

THIS DRAWING MUST NOT BE SCALED.
THE GENERAL CONTRACTOR SHALL VERIFY ALL DIMENSIONS, DATUMS AND LEVELS PRIOR TO COMMENCEMENT OF WORK AND IS HELD RESPONSIBLE FOR REPORTING ANY DISCREPANCY OR OMISSION TO NEIL COOPER ARCHITECT INC. IMMEDIATELY.

THIS DRAWING IS THE EXCLUSIVE PROPERTY OF NEIL COOPER ARCHITECT INC. AND CAN BE REPRODUCED ONLY WITH THE PERMISSION OF NEIL COOPER ARCHITECT INC. IN WHICH CASE THE REPRODUCTION MUST BEAR THEIR NAME AS THE ARCHITECTURAL FIRM.

DRAWING:
EAST & WEST PARTIAL ELEVATIONS
PROJECT:
PAN AM POOL BLDG ENVELOPE RETROFIT PHASE 2
25 Poseidon Bay, Winnipeg, Manitoba

Neil Cooper Architect Inc.
10-395 Berry Street, Winnipeg, Manitoba R3J 1N6

Tuplin Group Inc.
Unit L 301 Weston Street, Winnipeg, Manitoba R3E 3H4

DRAWN BY: AL	CHECKED BY:	SHEET NO: A3.2R-1	REV NO:
DATE: JUNE 01, 2009			
SCALE: As Noted			

FILE: 08062\CONT.DOC\CONT.DWGS\ARCH\PHASE 2\A3.1