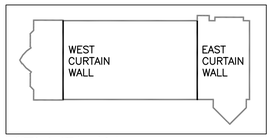

KEY PLAN
SCALE: NTS

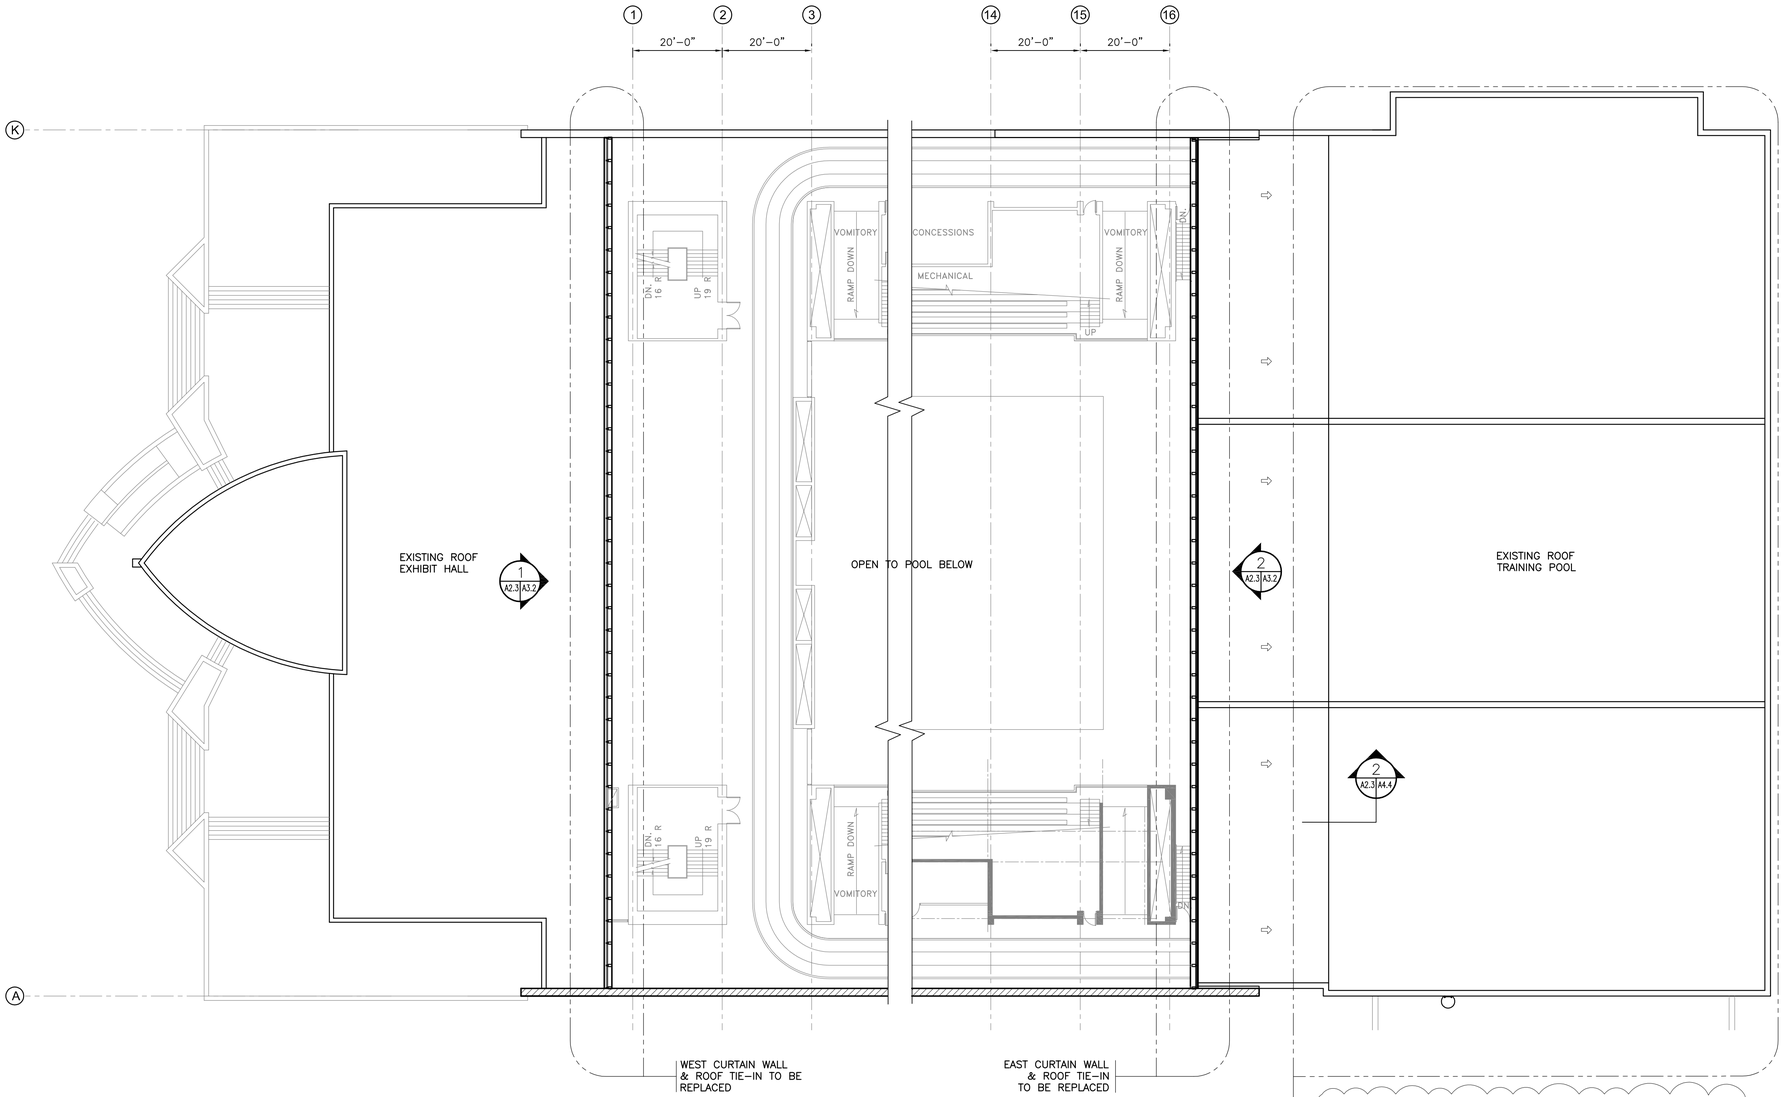

1 A2.3 EAST & WEST LOWER ROOF PLAN
SCALE: 1/16"=1'-0"

ROOF REPAIR WORKS:
- ROOFING SYSTEM REPAIRS-SEE DETAIL-2/A4.4
PARAPET REPAIR WORKS:
-REMOVE PARAPET COPING FLASHING
-PROVIDE NEW SP MEMBRANE FLASHING & BUTYL CAULK & SEAL
-RE-INSTALL THE COPING FLASHING

01

REV	DESCRIPTION	DATE	BY
1	ISSUED FOR ADDENDUM 2	MAR 25, 2010	AL
0	ISSUED FOR TENDER	MAR 2, 2010	AL

SEAL: PROVINCE OF MANITOBA — NEIL COOPER — MAR 2, 2010 — REGISTERED ARCHITECT

SEAL: PROVINCE OF MANITOBA — NEIL COOPER ARCHITECT INC. — MAR 2, 2010 — No.090 — APPROVED ARCHITECTURAL CORPORATION

THIS DRAWING MUST NOT BE SCALED.

THE GENERAL CONTRACTOR SHALL VERIFY ALL DIMENSIONS, DATUMS AND LEVELS PRIOR TO COMMENCEMENT OF WORK AND IS HELD RESPONSIBLE FOR REPORTING ANY DISCREPANCY OR OMISSION TO NEIL COOPER ARCHITECT INC IMMEDIATELY.

THIS DRAWING IS THE EXCLUSIVE PROPERTY OF NEIL COOPER ARCHITECT INC AND CAN BE REPRODUCED ONLY WITH THE PERMISSION OF NEIL COOPER ARCHITECT INC, IN WHICH CASE THE REPRODUCTION MUST BEAR THEIR NAME AS THE ARCHITECTURAL FIRM.

DRAWING:

EAST & WEST LOWER ROOF PARTIAL PLAN

PROJECT:

PAN AM POOL BLDG ENVELOPE RETROFIT PHASE 2

25 Poseidon Bay, Winnipeg, Manitoba

Neil Cooper Architect Inc.
10-395 Berry Street, Winnipeg, Manitoba R3J 1N6

Tuplin Group Inc.
Unit L 301 Weston Street, Winnipeg, Manitoba R3E 3H4

DRAWN BY:	CHECKED BY:	SHEET NO:	REV NO:
AL		A2.3	R-1

DATE: JUNE 01, 2009
SCALE: As Noted
FILE: 08062\CONT DOC\CONT DWGS\ARCH\PHASE 2\A2.1