It is the stand-alone, water process building.

The Major occupancy Classifications: Group F, Division 3 Building Area: 38 sq.meters Building Height: 1-storey Number of Streets: 1 Building is Sprinklered: No

Design Occupant Load: 1-2 infrequent Section 3.2 Building Fire Safety Building Size and Construction Relative to Occupancy:
Construction Article: The building would be regulated under 3.2.2.80.,

Group F, Division 3, One Storey Non-combustible or Combustible: The building may be Non-combustible or Heavy Timber Floor Assemblies: No ratings required Roof assemblies: No ratings reqired Suppoting Elements: No ratings required

Section 3.2.3 Spatial Separation

North: Area: 26 sq. meters; LD 100+ M, 100% openings allowed; None Req'd South: Area: 26 sq. meters; LD 7.62 M, 1.2% openings allowed; None Req'd

East: Area: 21 sq. meters; LD 100+ M, 100% openings allowed; 5.29 sq. meters provided West: Area: 21 sq. metes; LD 100+ M, 100% openings allowed; None Req'd Section 3.2.4 Fire Alarm: A fire alarm system is not required.

Section 3.2.5 Provisions for Firefighting: Access for Fire Department Vehicles: Yes Hydrants Location: conforming situation Sprinkler or Standpipe: Not required


Section 3.2.7 Emergency Lighting: Emergency lighting is required.


Section 3.4 Exits One exit required: 1 exit provided. Exit capacity required: 6.1mm x 4 persons = 24mm exit width required: 2488mm provided. Exit signage is required.

Section 3.7 Washrooms:

Not Required

Section 3.8 Barrier-Free design: Not Required, Industrial Occupancy

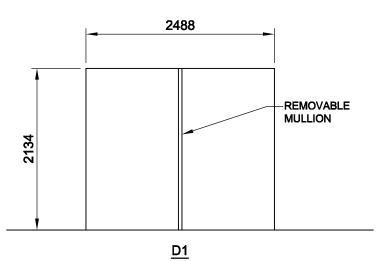

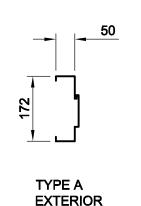



DOOR TYPES


FRAME TYPES





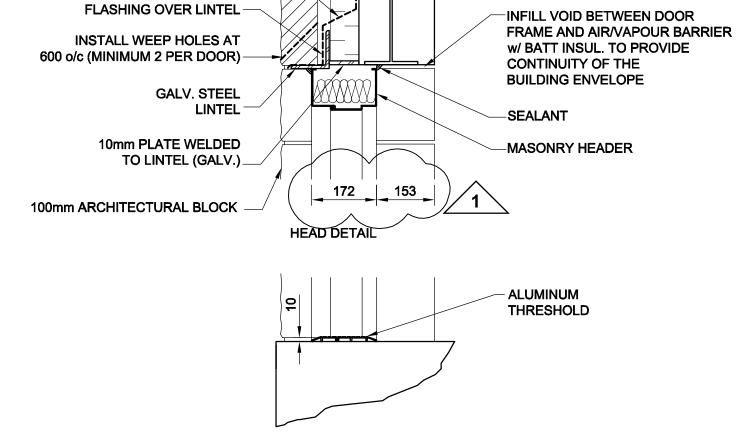


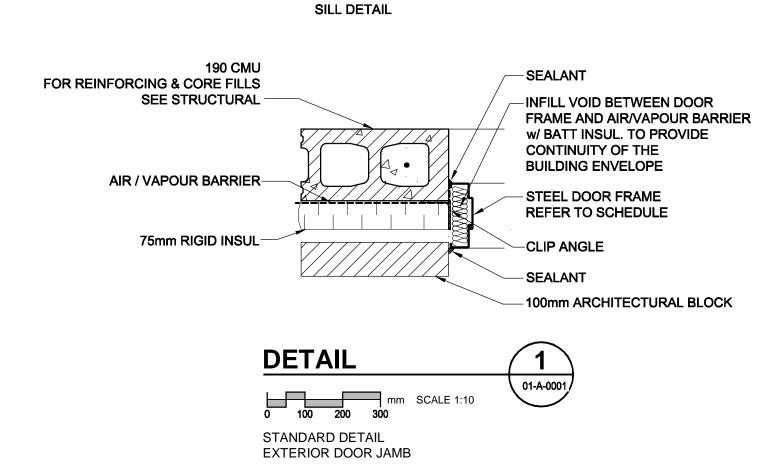

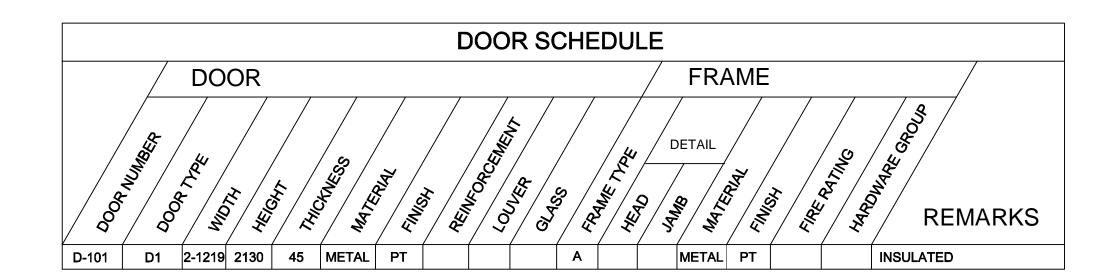

TA 314 114x100 NRP STANLEY C32D S.S. VON DURPIN 626 CA W24S - 900mm KN CROWDER CA CT11 - 900mm KN CROWDER 689

ROOM FINISH SCHEDULE														
	FLOOR			WALLS								CEILING		
ROOM NAME				NORTH		EAST		SOUTH		WEST		OLILING		REMARKS
	MAT.	FINISH	BASE	MAT.	FINISH	MAT.	FINISH	MAT.	FINISH	MAT.	FINISH	MAT.	FINISH	
100 - ACCESS ROOM	CONC.	SEALER		СМИ	PT	CMU	PT	СМИ	PT	СМИ	PT	METAL	PRE-FIN	
CMU = CONCRETE MASONRY UNIT	CONC = C	ONCRETE	PT =	PAINT										

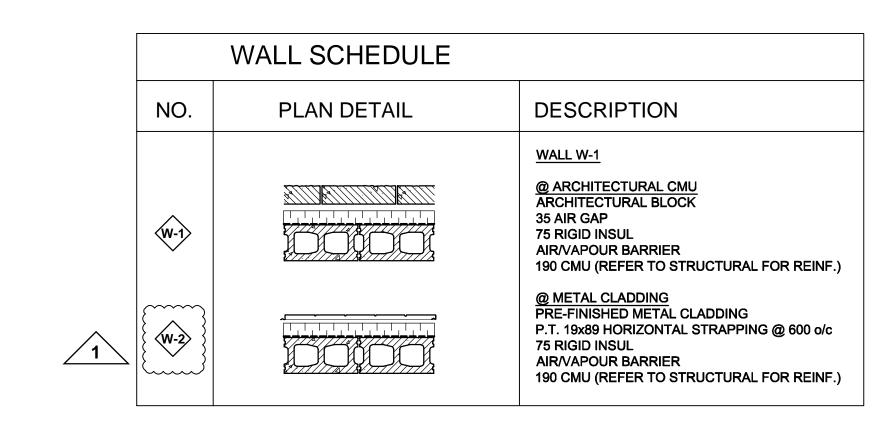

BID OPPORTUNITY NO. 16-2010

	LOCATION APPROVED UNDERGROUND STRUCTURES					A=C0	not be used, repro	duced or relied upon by I and its client, as requir		PROFESSIONAL'S SEAL	
SUPR. U/G STRUCTURES DATE COMMITTEE	COMMITTEE					AECO	drawing without A	bility whatsoever, to any ECOM's express written locument. All measurem	party that modifies this	Revision '0' Issued for Construction	Wi
	NOTE: LOCATION OF UNDERGROUND STRUCTURES AS SHOWN ARE BASED ON THE BEST					DESIGNED BY	KK/GGP	CHECKED BY	GGP	WAS SEALED BY NEIL COOPER	
	INFORMATION AVAILABLE. BUT NO GUARANTEE IS GIVEN THAT ALL EXISTING UTILITIES ARE SHOWN OR THAT THE GIVEN					DRAWN BY	KK	APPROVED BY	Bryan Weber	AND DATED Feb 10/10	
LOCATIONS AF	LOCATIONS ARE EXACT. CONFIRMATION OF					HOR. SCALE	AS SHOWN	RELEASED FO			
	EXISTENCE AND EXACT LOCATION OF ALL SERVICES MUST BE OBTAINED FROM THE		ISSUED FOR ADDENDUM 1	10/02/26	KK	VERT. SCALE	-	CONSTRUCTIO	K.Z.	CONSULTANT DRAWING NO.	
INDIVIDUAL UTILITIES BEFORE PROCEEDING WITH CONSTRUCTION.	INDIVIDUAL UTILITIES BEFORE PROCEEDING	100	ISSUED FOR CONSTRUCTION	10/02/08	KK	l	10/02/00			D265-250-00 01-A-0001 RX.dwg	
	WITH CONSTRUCTION.	NO.	REVISIONS	YY/MM/DD	BY	DATE	10/02/09	DATE	Feb 9/10		



THE CITY OF WINNIPEG **WATER AND WASTE DEPARTMENT**

BRANCH I AQUEDUCT VALVE CHAMBER AT McPHILLIPS STREET **PUMPING STATION ARCHITECTURAL**

GENERAL NOTES

CITY DRAWING NUMBER D-11918