
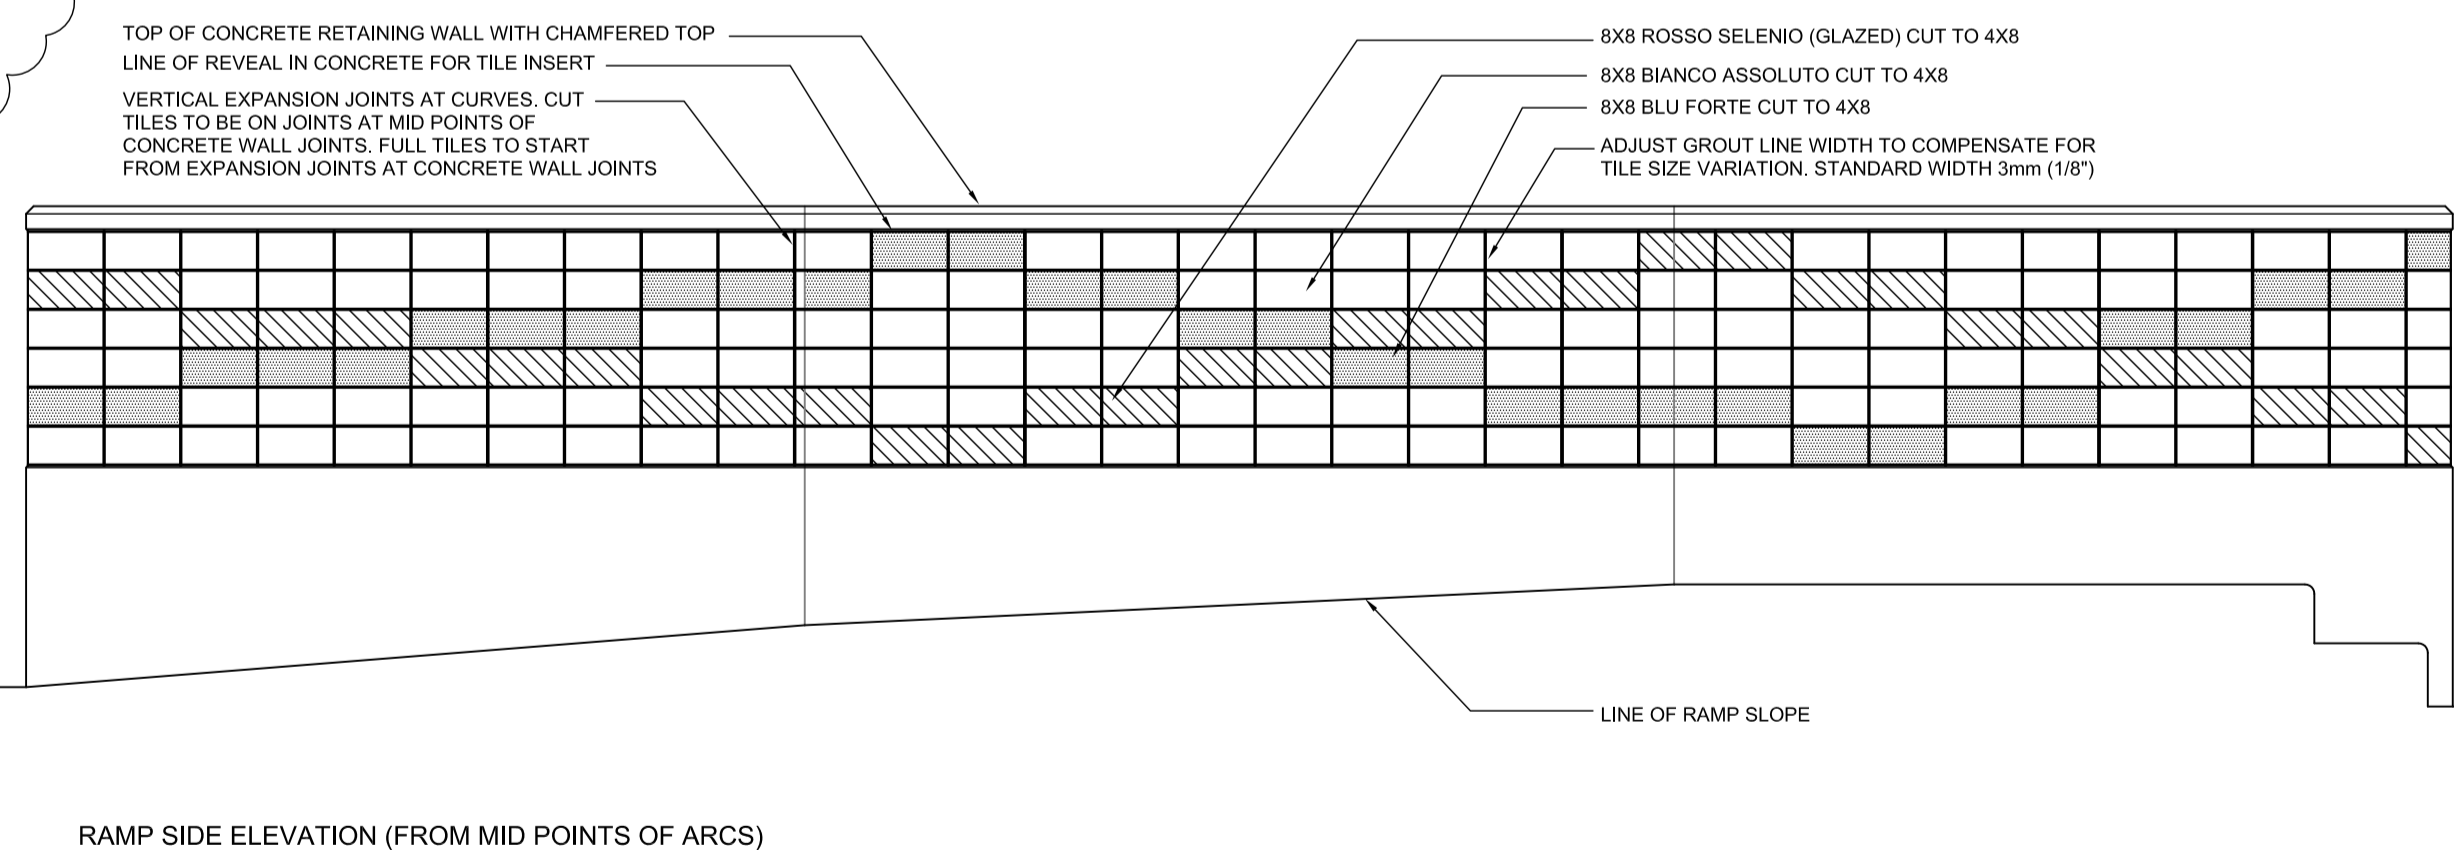


WEST SIDE LANDSCAPE GRADING

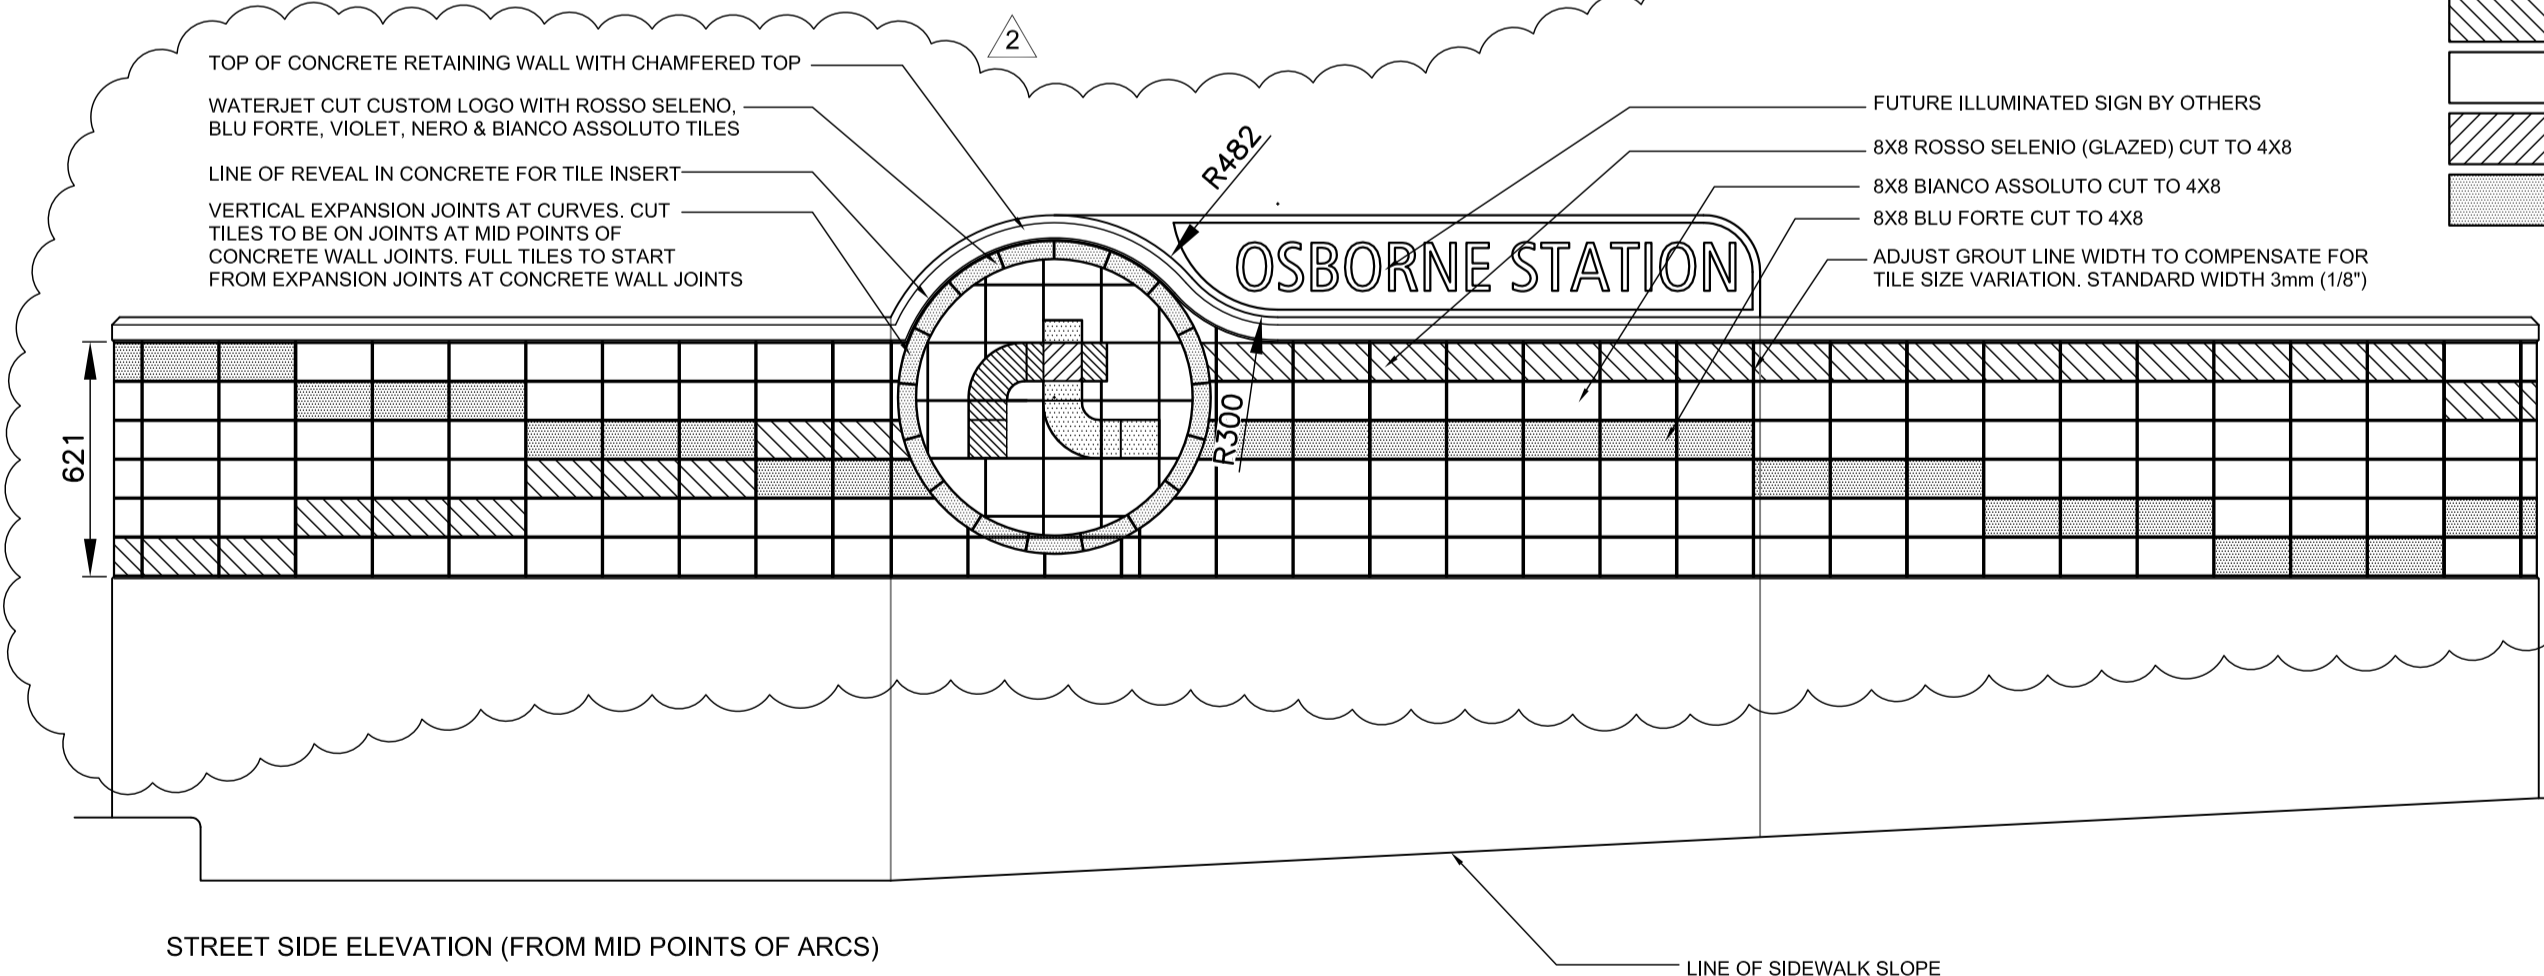

TILE LAYOUT OF PLANTER - FLATTENED ELEVATION
SCALE 1:75

LEGEND	
(232.688) ENGINEERS PROPOSED GRADES (REFER TO CIVIL DRAWING)	TC TOP OF CURB
EXISTING GRADE	BC BOTTOM OF CURB
+ (233.561) PROPOSED GRADE	TW TOP OF WALL
	BW BOTTOM OF WALL
	TS TOP OF STAIRS
	BS BOTTOM OF STAIRS

	BLU FORTE
	ROSSO SELENIO (GLAZED)
	BIANCO ASSOLUTO
	VIOLET
	NERO

LOCATION UNDERGROUND STRUCTURES	APPROVED STRUCTURES	B.M. ELEV.	BM ELEV.
ORIGINAL SIGNED BY X	X		
SUPV. U/G STRUCTURES COMMITTEE	DATE		

NOTE:
LOCATION OF UNDERGROUND STRUCTURES AS SHOWN ARE BASED ON THE BEST INFORMATION AVAILABLE BUT NO GUARANTEE IS GIVEN THAT ALL EXISTING UTILITIES ARE SHOWN OR THAT THE GIVEN LOCATIONS ARE EXACT. CONFIRMATION OF EXISTENCE AND EXACT LOCATION OF ALL SERVICES MUST BE OBTAINED FROM THE INDIVIDUAL UTILITIES BEFORE PROCEEDING WITH CONSTRUCTION.

NO.	REVISIONS	DATE	BY	DATE
2	ISSUED FOR ADDENDUM #2	10/06/11	JW	
1	ISSUED FOR TENDER	10/05/14	JW	

DESIGNED BY	SR/JW
DRAWN BY	JW/TM
CHECKED BY	JW/SR
APPROVED BY	-
HOR. SCALE	1:100
VERTICAL	
DATE	2010-05-07

McGOWAN-RUSSELL
DILLON CONSULTING

RELEASED FOR CONSTRUCTION
ORIGINAL SIGNED BY RANDY FINGAS
DATE: 2010/05/14

LANDSCAPE ARCHITECT'S SEAL
ORIGINAL SIGNED BY JACKIE WILKIE
JACQUELINE L. WILKIE
member no. 75

CONSULTANT PROJECT NO.
08-028

THE CITY OF WINNIPEG
TRANSIT DEPARTMENT

Winnipeg

SOUTHWEST RAPID TRANSIT CORRIDOR - STAGE 1
OSBORNE STATION AND ASSOCIATED WORKS

LANDSCAPE WORKS
WEST SIDE LANDSCAPE GRADING

CITY DRAWING NUMBER
B237-10-115

SHEET OF
115 OF 121

CONSULTANT DRAWING NUMBER
C5-L-5004-T-R1