



X:\08-028\_Southwestern BRT Corridor\dwg\2010\osborne\_station\wks\_dwg\DETAIL SHEET 2010-06-08.dwg

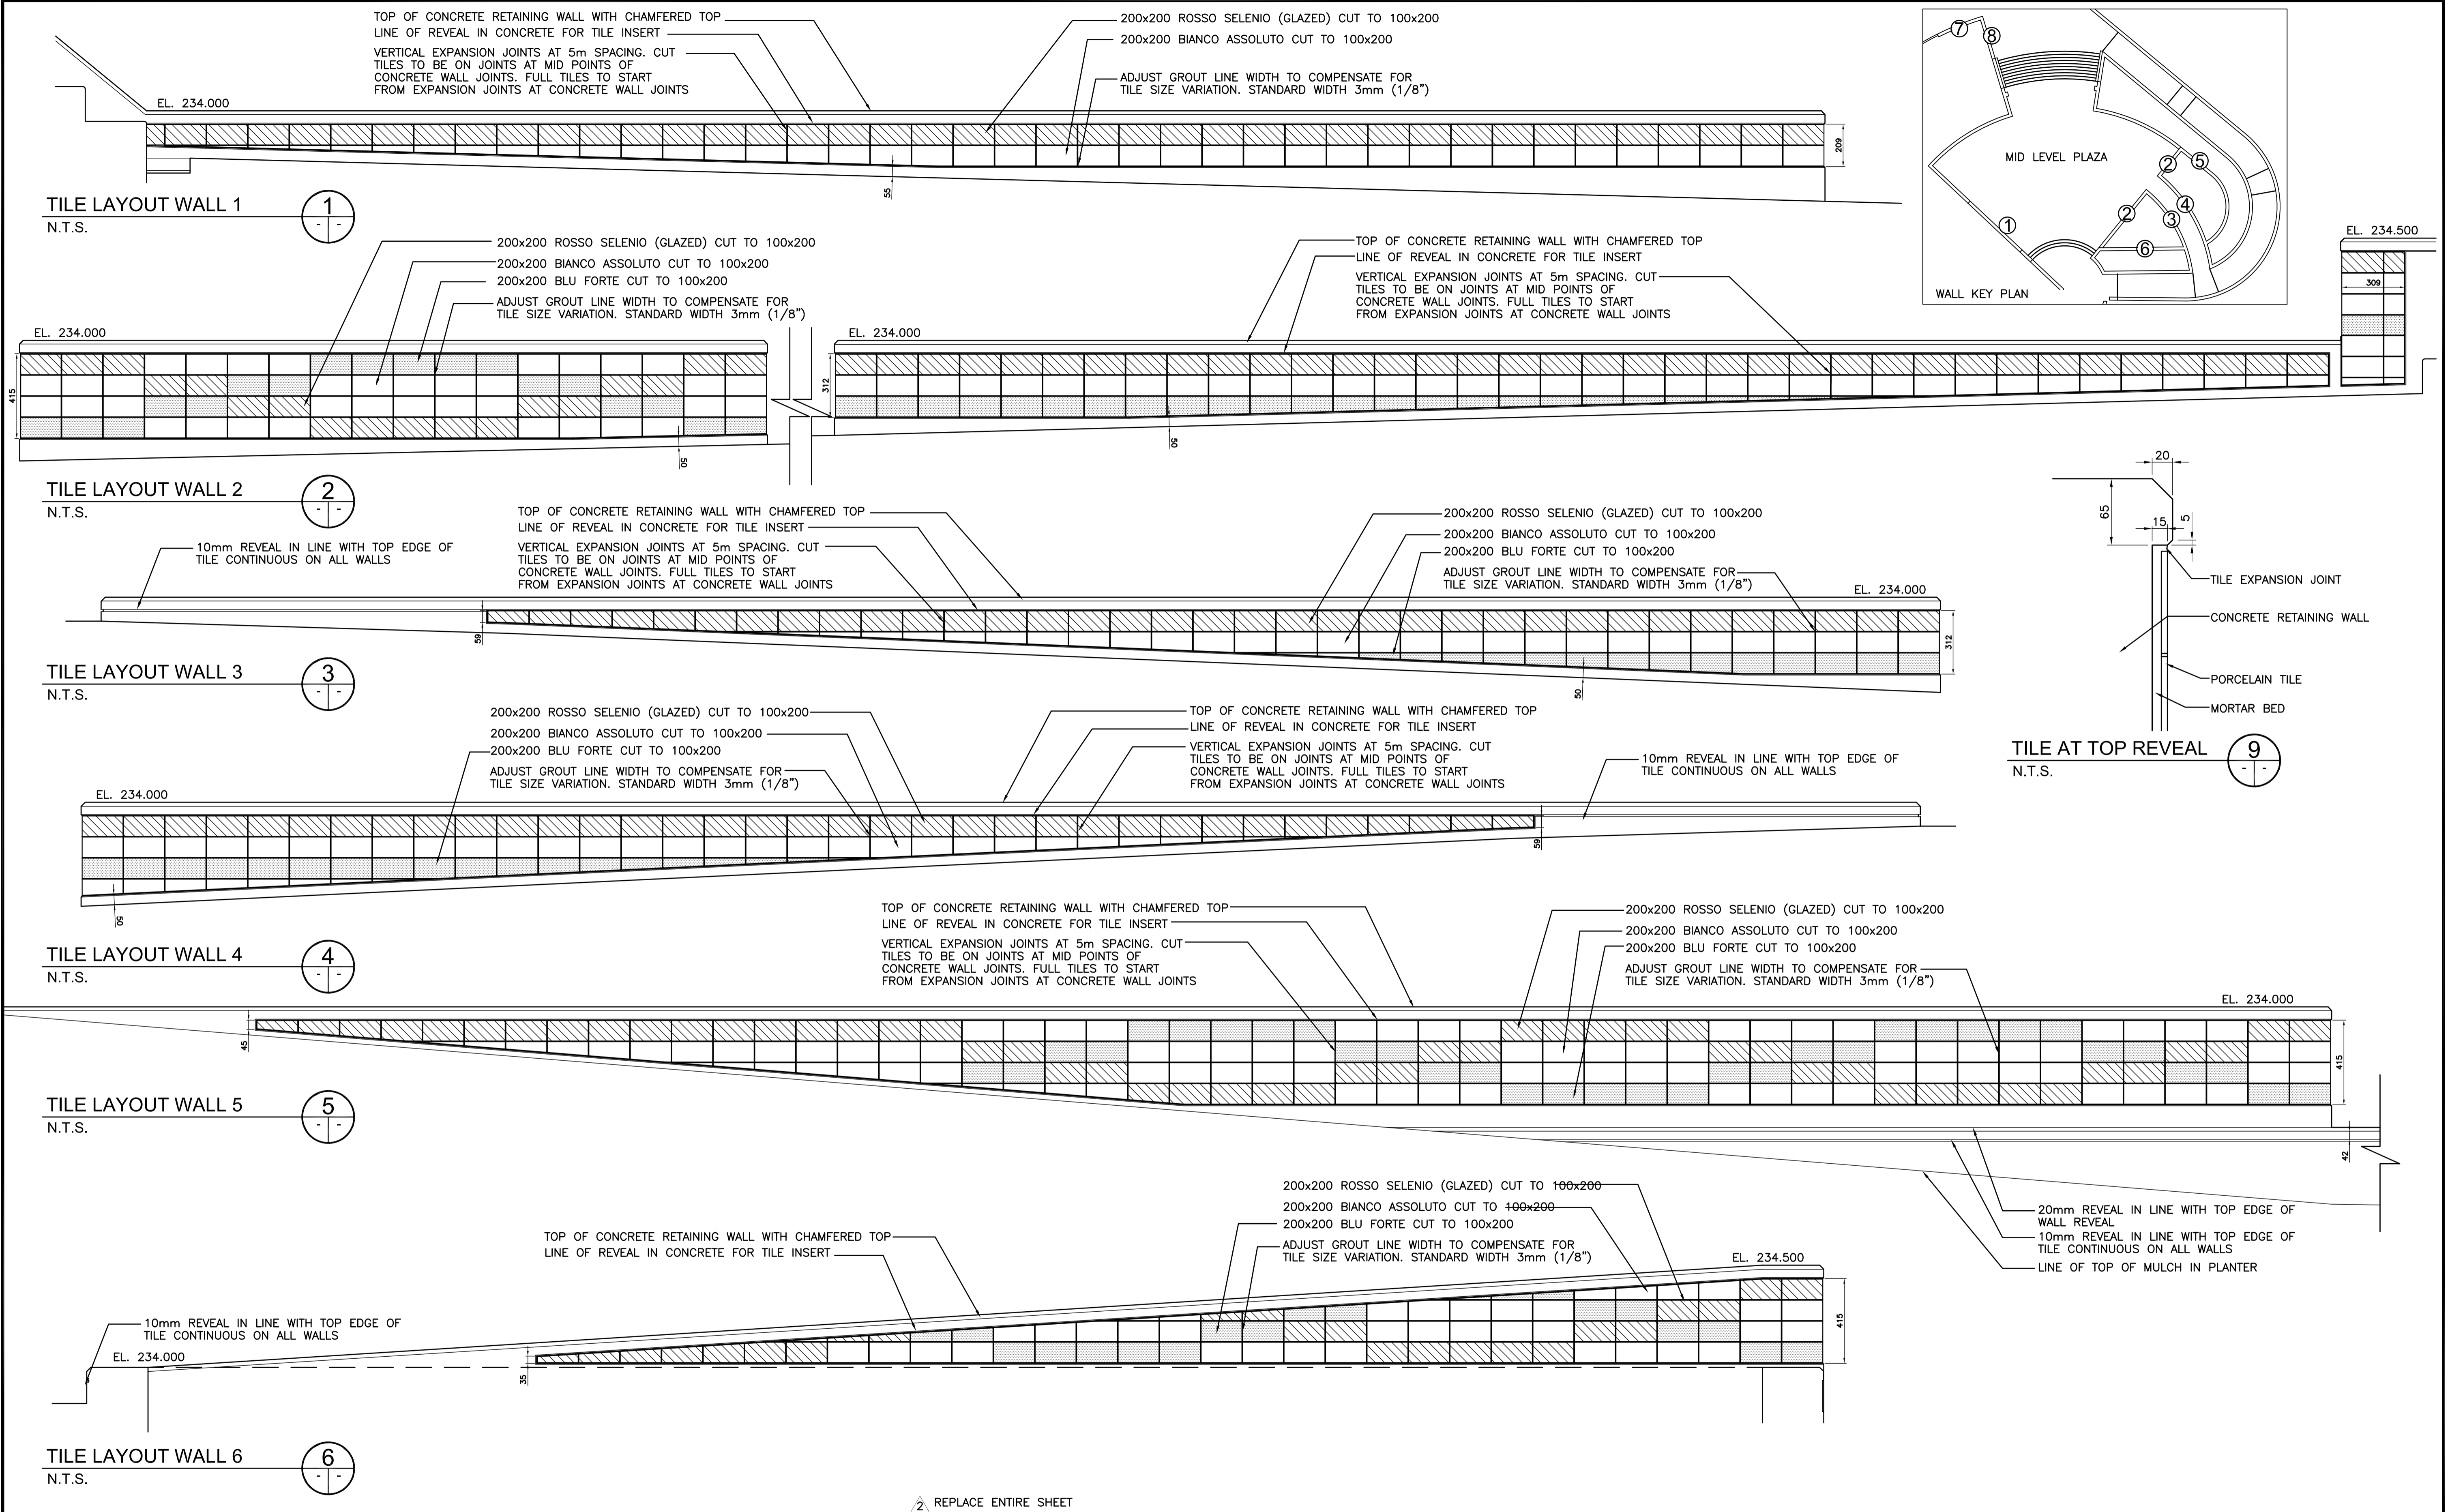

REPLACE ENTIRE SHEET

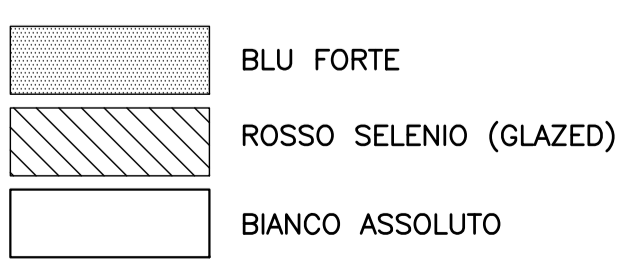

<b>LOCATION UNDERGROUND STRUCTURES</b> ORIGINAL SIGNED BY: X SUPV. U/G STRUCTURES COMMITTEE: DATE:		<b>APPROVED</b> ORIGINAL SIGNED BY: X DATE:		B.M. ELEV. B.M. ELEV.	DESIGNED BY: SR/JW DRAWN BY: JW/TM CHECKED BY: JW/SR APPROVED BY:	 <b>DILLON CONSULTING</b>	LANDSCAPE ARCHITECT'S SEAL ORIGINAL SIGNED BY: JACKIE WILKIE JACQUELINE WILKIE member no. 75	 <b>THE CITY OF WINNIPEG</b> TRANSIT DEPARTMENT	SOUTHWEST RAPID TRANSIT CORRIDOR - STAGE 1 OSBORNE STATION & ASSOCIATED WORKS	CITY DRAWING NUMBER: B237-10-121 SHEET OF: 121 OF 121
<b>NOTE:</b> LOCATION OF UNDERGROUND STRUCTURES AS SHOWN ARE BASED ON THE BEST INFORMATION AVAILABLE BUT NO GUARANTEE IS GIVEN THAT ALL EXISTING UTILITIES ARE SHOWN OR THAT THE GIVEN LOCATIONS ARE EXACT. CONFIRMATION OF EXISTENCE AND EXACT LOCATION OF ALL SERVICES MUST BE OBTAINED FROM THE INDIVIDUAL UTILITIES BEFORE PROCEEDING WITH CONSTRUCTION.		2 ISSUED FOR ADDENDUM #2 1 ISSUED FOR TENDER	10/06/11 10/05/14	JW JW	AS NOTED VERTICAL	RELEASED FOR CONSTRUCTION ORIGINAL SIGNED BY: RANDY FINGAS DATE: 2010/05/14	CONSULTANT PROJECT NO.: 08-028	<b>LANDSCAPE DETAILS</b>	CONSULTANT DRAWING NUMBER: C5-L-5010-T-R1	