



**EAST SIDE UPPER PLAZA**

SCALE 1:30

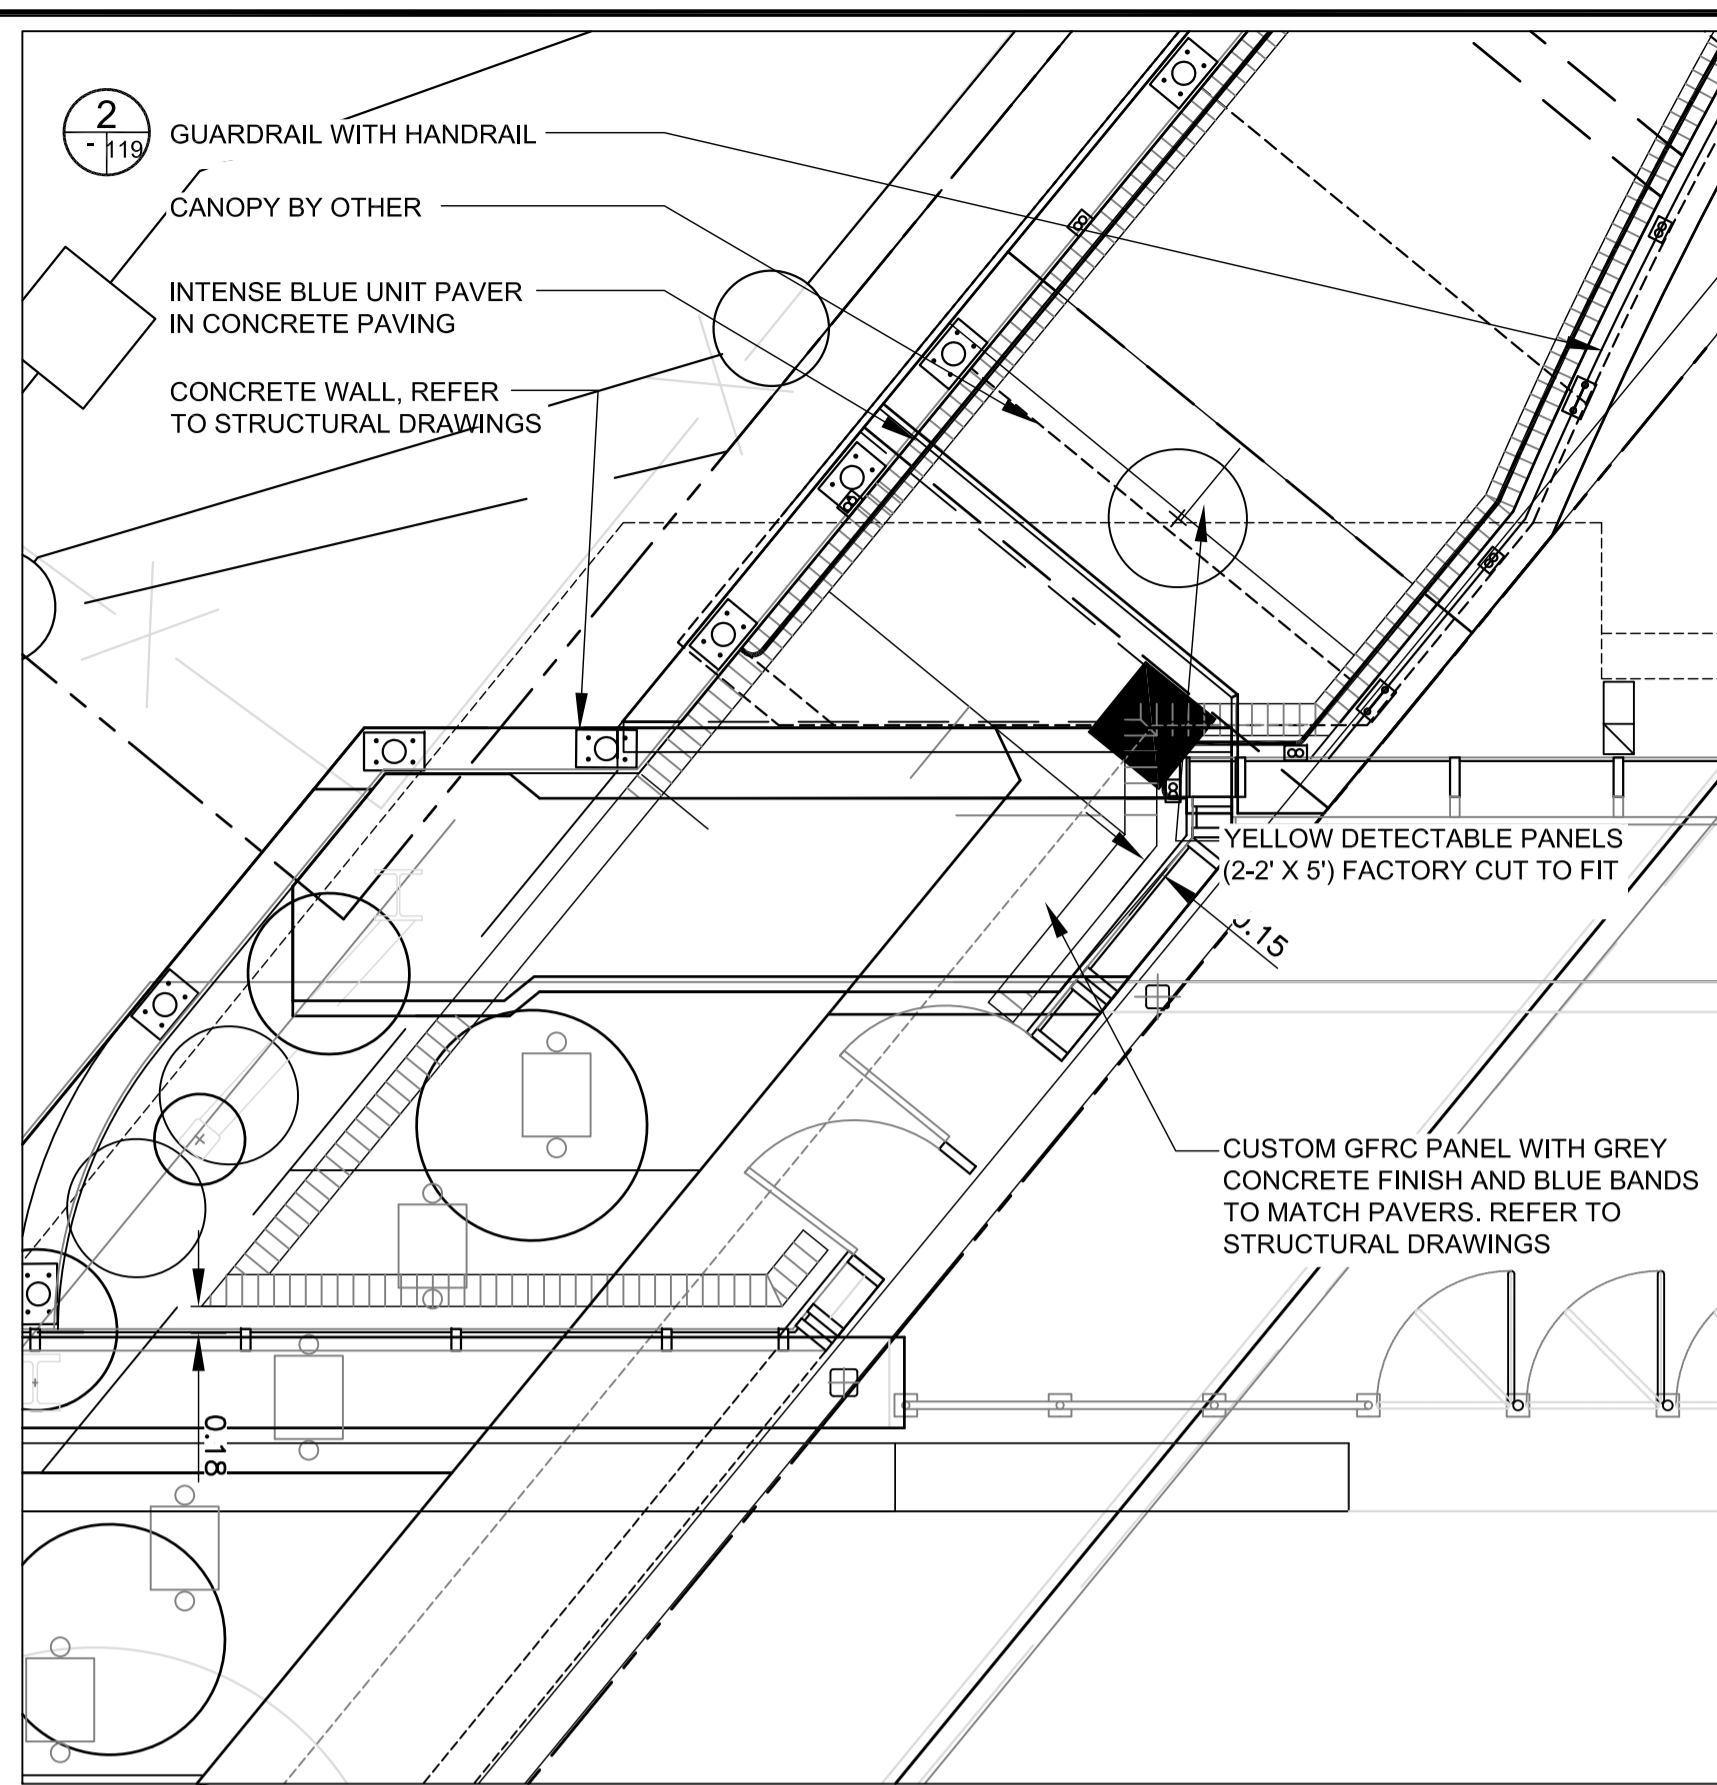


**WEST SIDE UPPER PLAZA**

SCALE 1:30

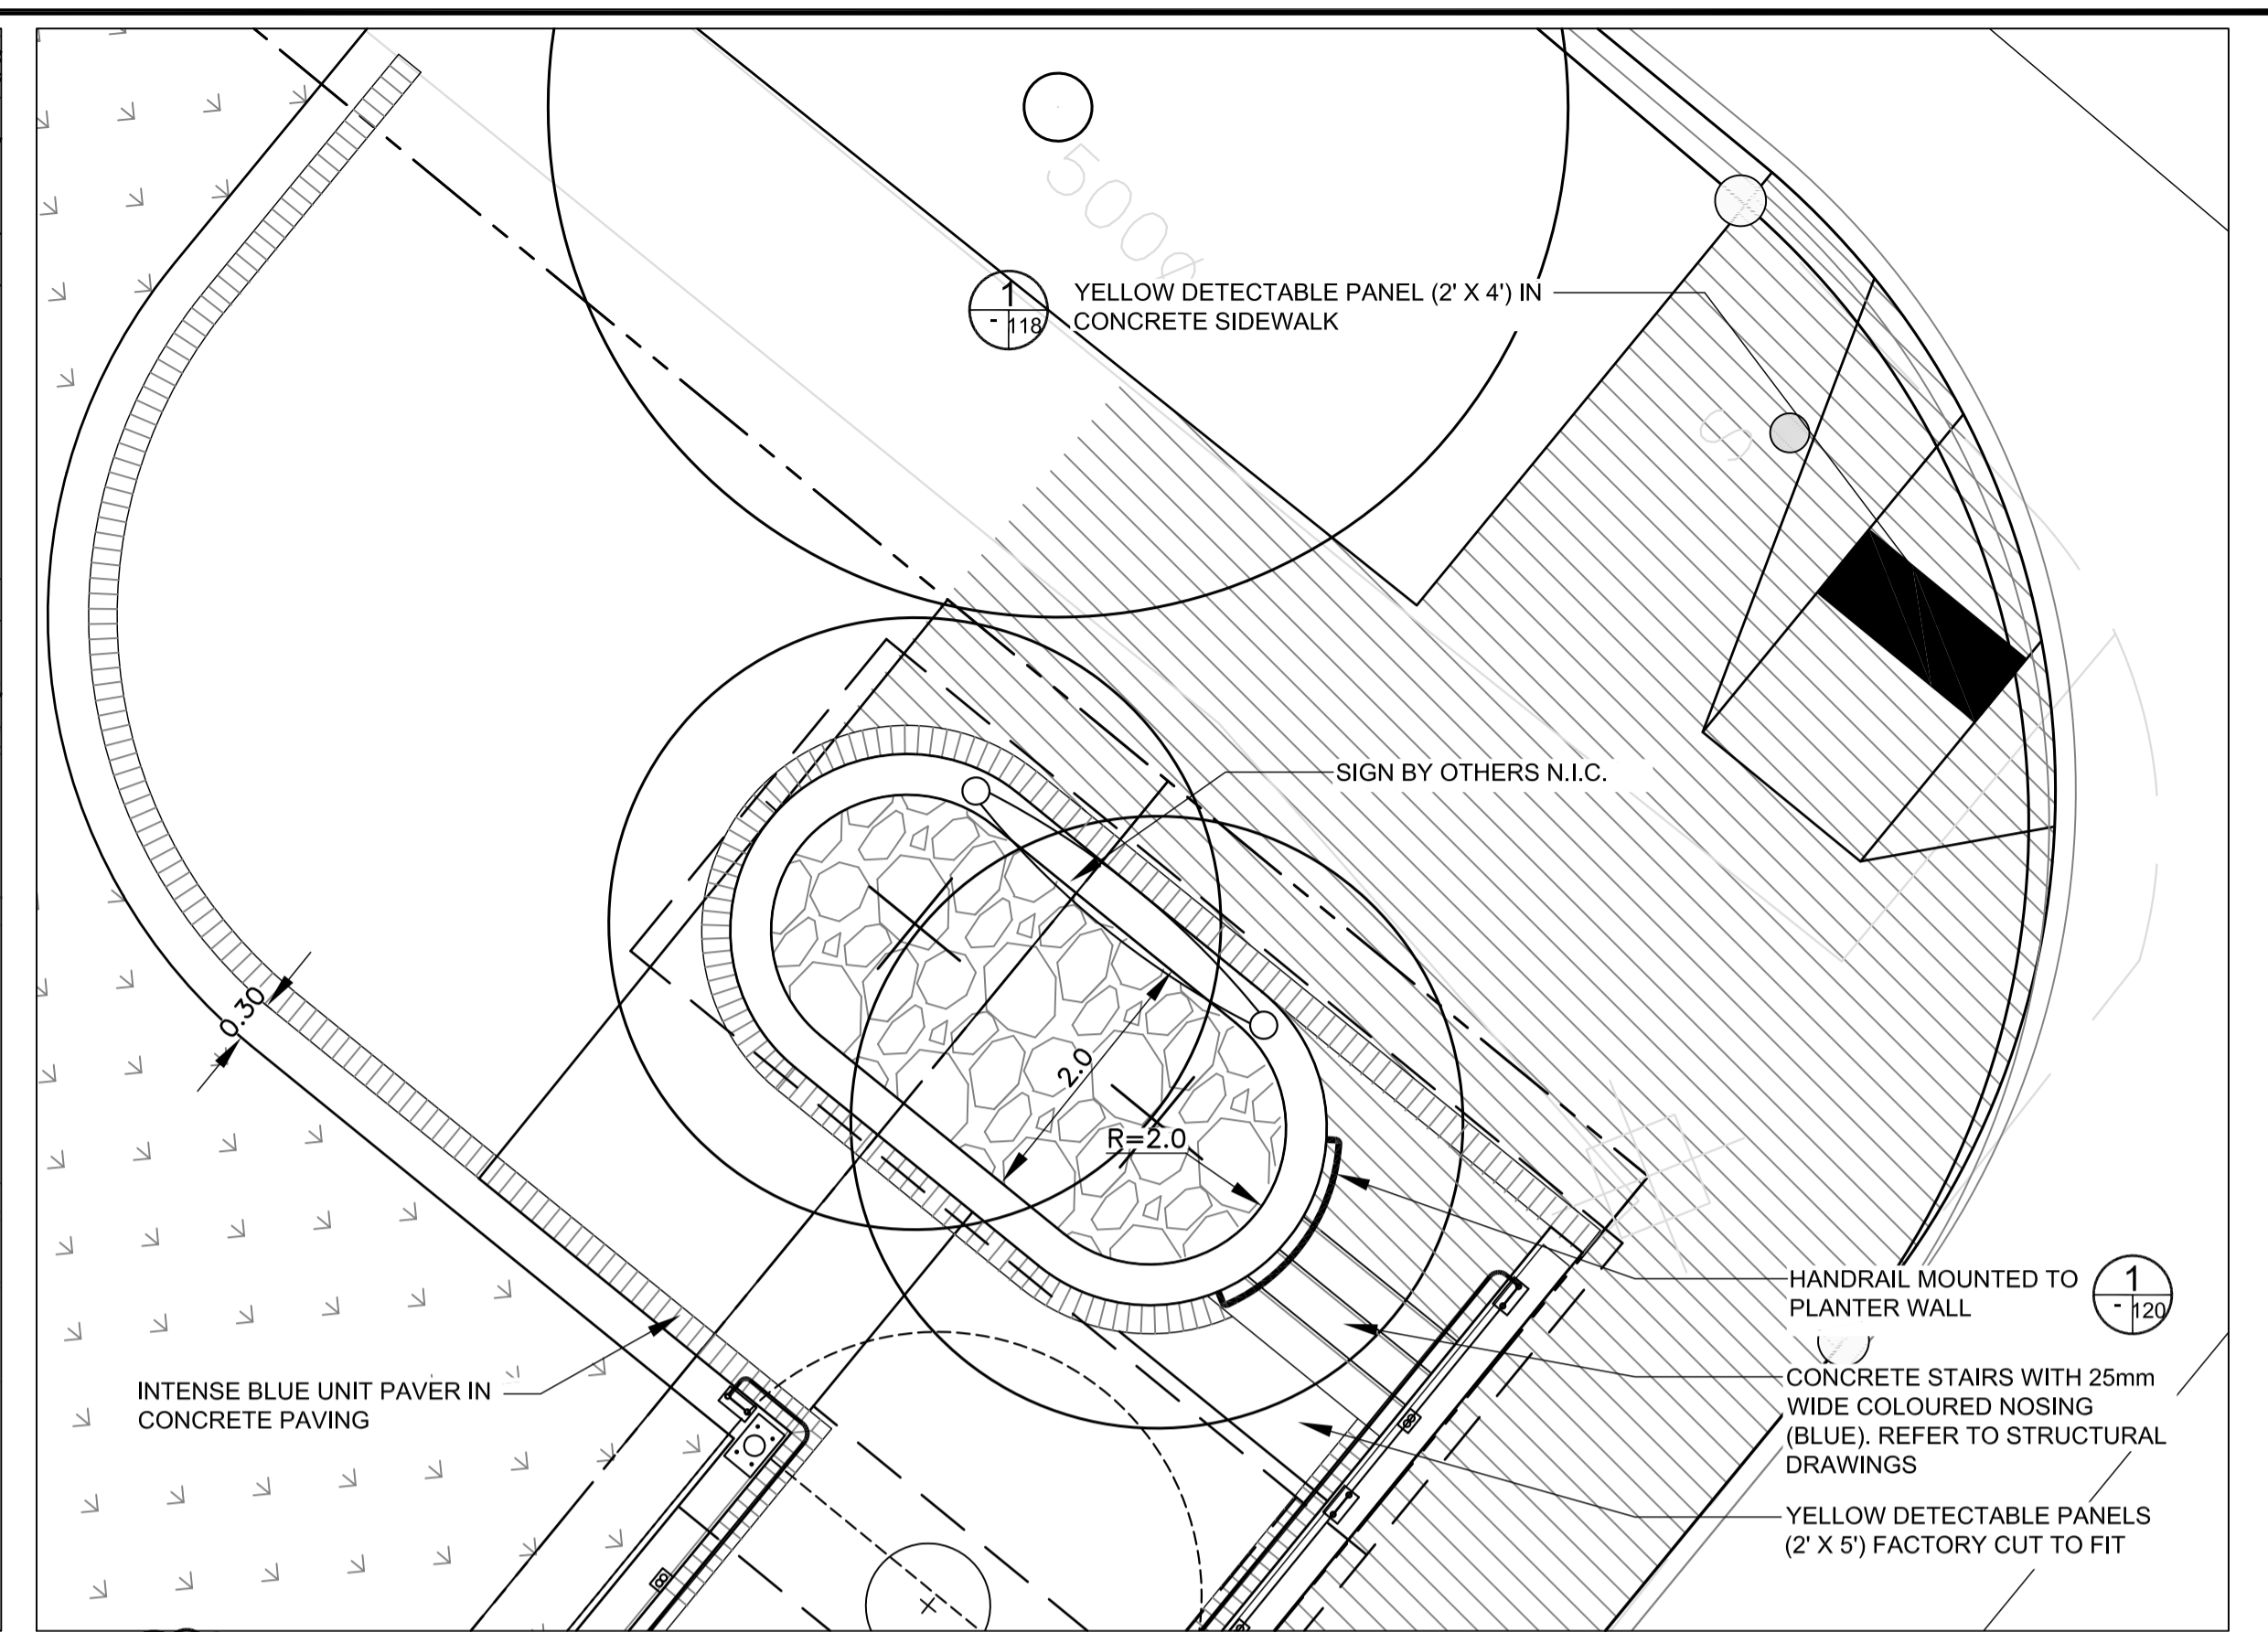


**WEST SIDE LOWER PLAZA**

SCALE 1:30

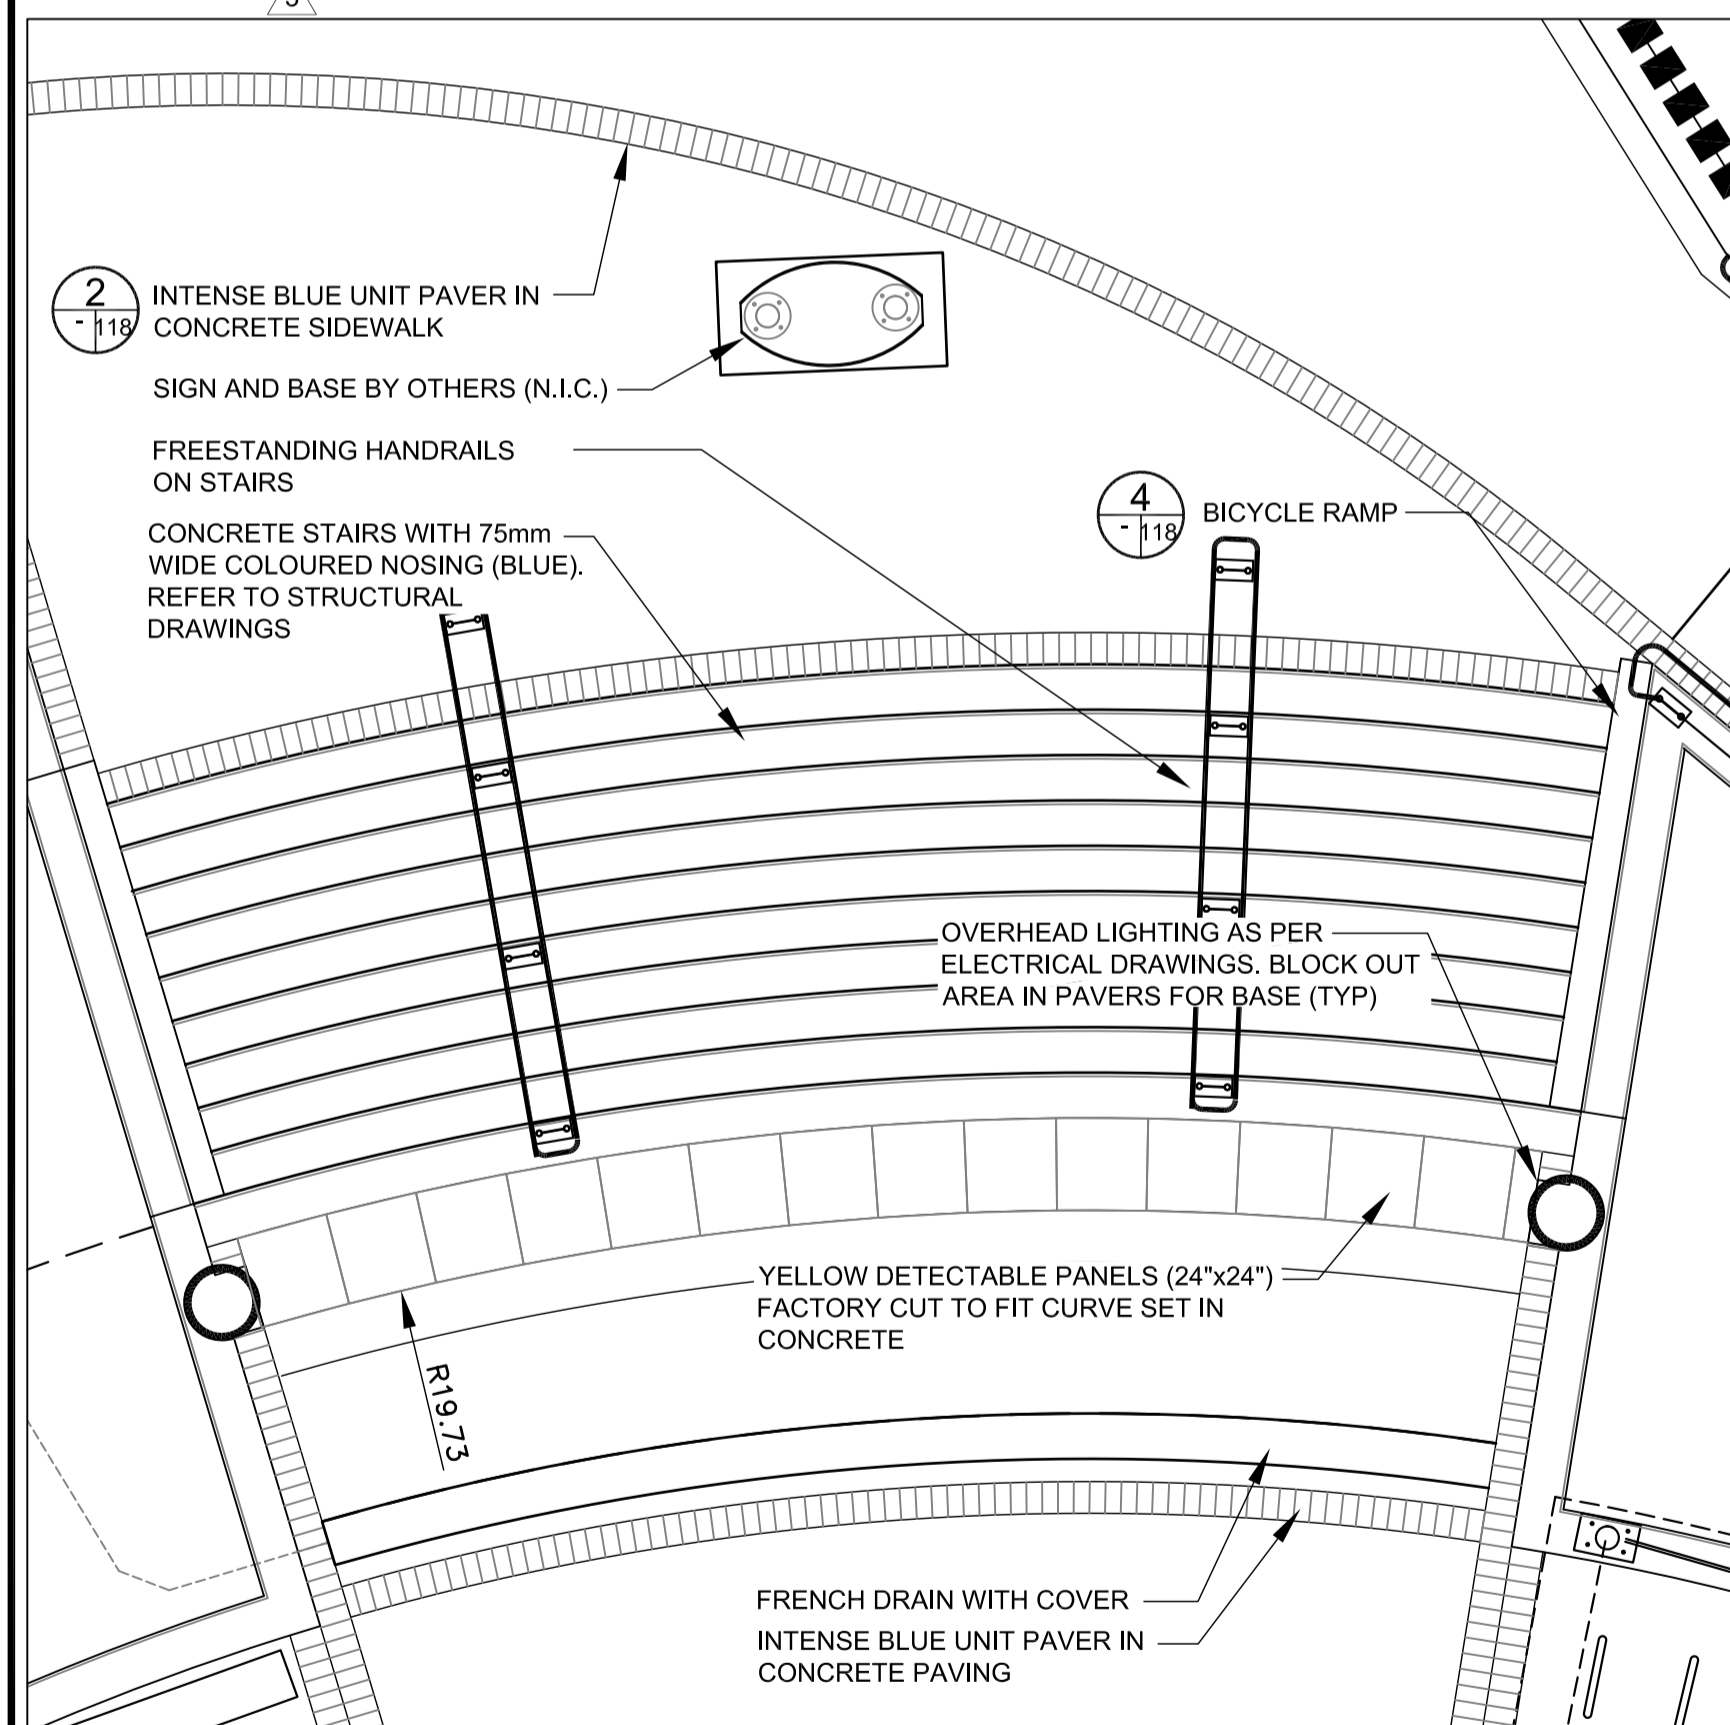


**PAVING PATTERN DETAIL MID PLAZA**

SCALE 1:50

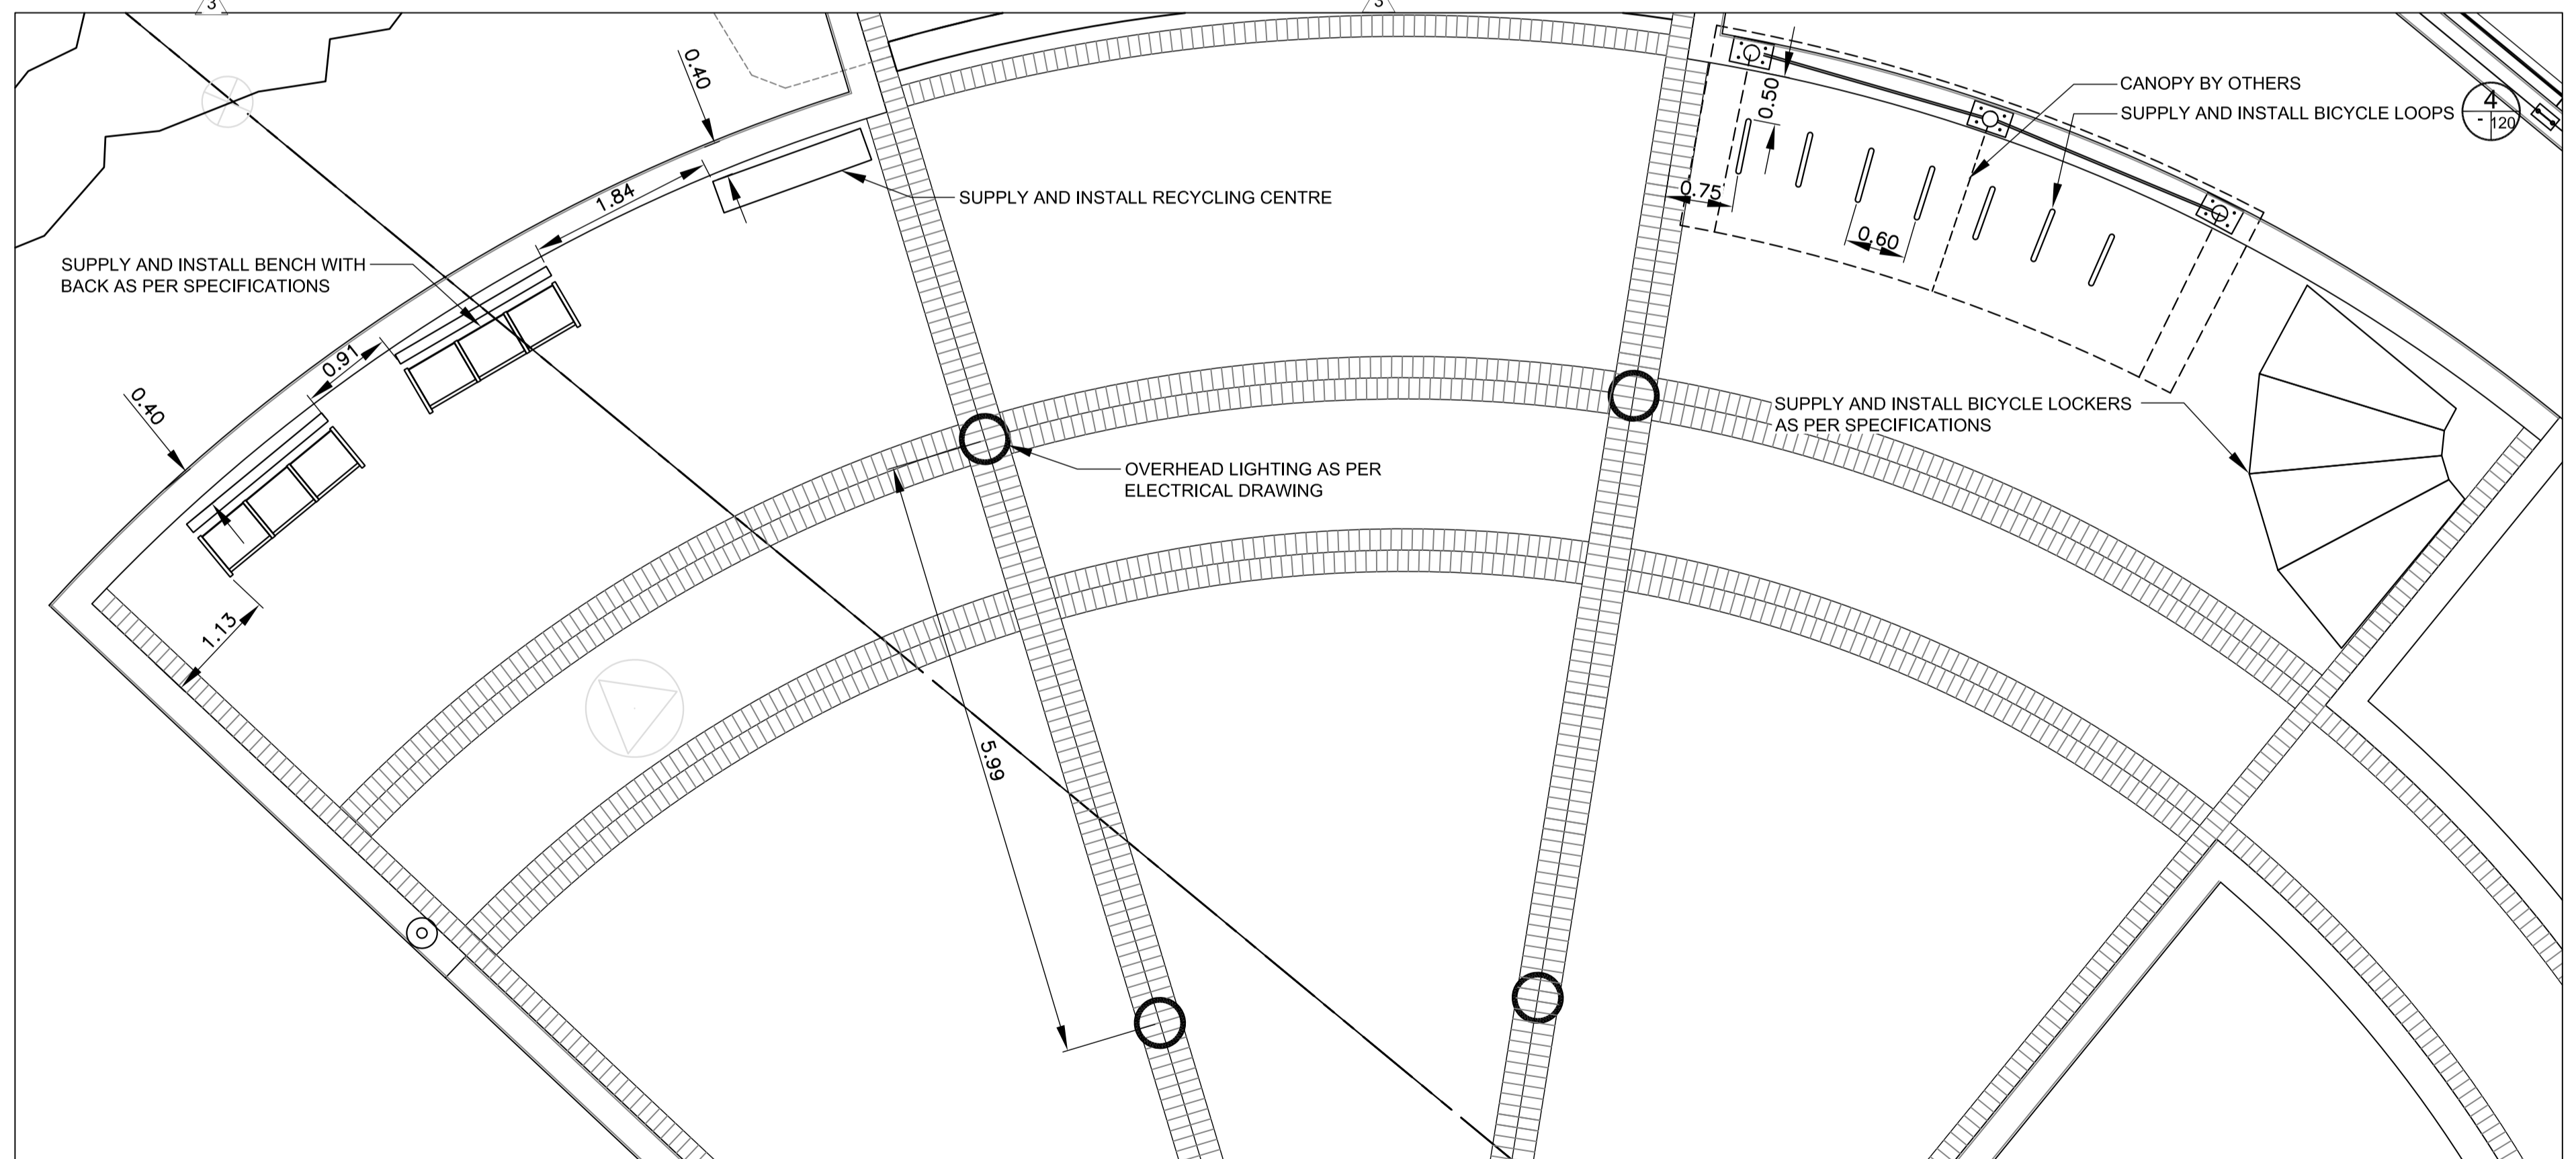

**SITE FURNITURE LAYOUT MID PLAZA**

SCALE 1:50

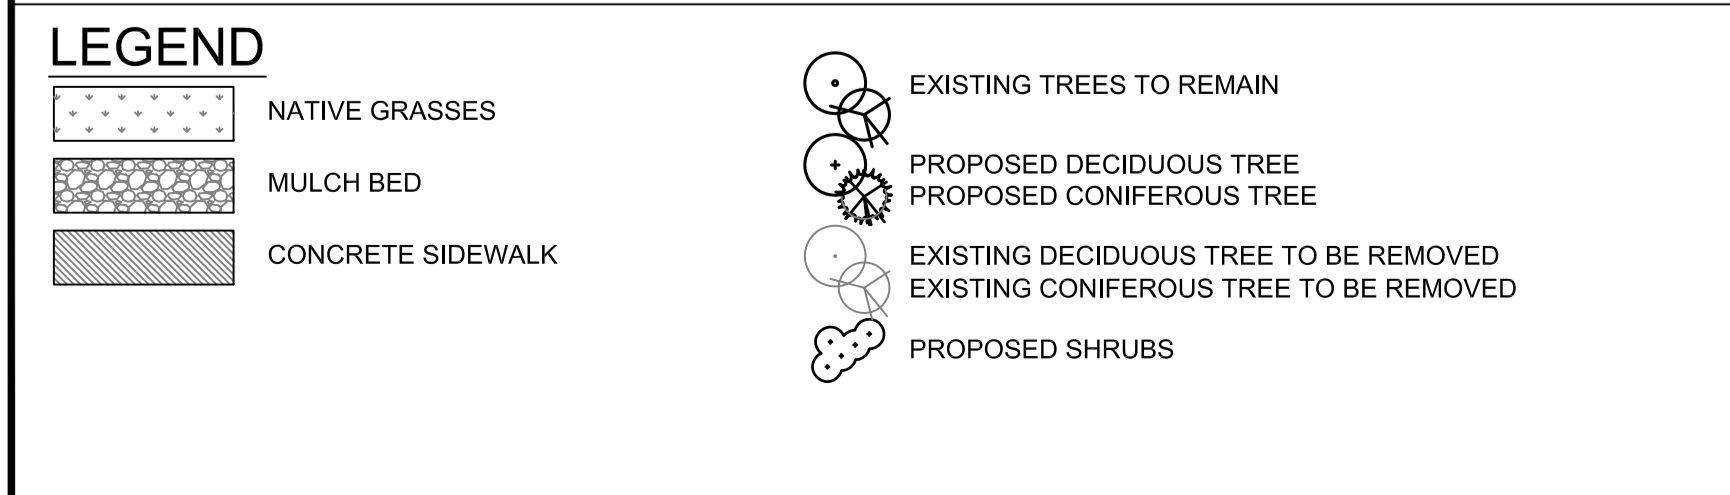

**PLANT KEY**

QUANTITY

PLANT KEY

**LOCATION APPROVED UNDERGROUND STRUCTURES**

ORIGINAL SIGNED BY \_\_\_\_\_ DATE \_\_\_\_\_

SUPV. U/G STRUCTURES COMMITTEE

NOTE: LOCATION OF UNDERGROUND STRUCTURES AS SHOWN ARE BASED ON THE BEST INFORMATION AVAILABLE. BUT NO GUARANTEE IS GIVEN THAT ALL EXISTING UTILITIES ARE SHOWN OR THAT THE GIVEN LOCATIONS ARE EXACT. CONFIRMATION OF EXISTENCE AND EXACT LOCATION OF ALL SERVICES MUST BE OBTAINED FROM THE INDIVIDUAL UTILITIES BEFORE PROCEEDING WITH CONSTRUCTION.

NO.	REVISIONS	DATE	BY
3	ISSUED FOR ADDENDUM #3	10/06/23	JW
2	ISSUED FOR ADDENDUM #2	10/06/11	JW
1	ISSUED FOR TENDER	10/05/14	JW

B.M. ELEV.	BM ELEV

DESIGNED BY SR/JW

DRAWN BY JW/TM

CHECKED BY JW/SR

APPROVED BY \_\_\_\_\_

HOR. SCALE 1:100

VERTICAL

DATE 2010-05-07

DESIGNED BY SR/JW

DRAWN BY JW/TM

CHECKED BY JW/SR

APPROVED BY \_\_\_\_\_

HOR. SCALE 1:100

VERTICAL

DATE 2010-05-07

RELEASED FOR CONSTRUCTION ORIGINAL SIGNED BY RANDY ENGAS. DATE: 2010/05/14

LANDSCAPE ARCHITECT'S SEAL

ORIGINAL SIGNED BY JACKIE WILKIE

JACQUELINE L. WILKIE member no. 75

CONSULTANT PROJECT NO. 08-028

**THE CITY OF WINNIPEG**  
TRANSIT DEPARTMENT

Winnipeg

SOUTHWEST RAPID TRANSIT CORRIDOR - STAGE 1  
OSBORNE STATION AND ASSOCIATED WORKS

LANDSCAPE WORKS  
ENLARGEMENTS

CITY DRAWING NUMBER B237-10-116

SHEET 116 OF 121

CONSULTANT DRAWING NUMBER C5-L-5005-T

X:\08-028 Southwestern BRT Corridor\dwg\2010\osborne station\wkg.dwg Osborn LANDSCAPE PLAN 2010-06-06-02.dwg