

**AECOM**  
 Certificate of Authorization  
 AECOM Canada Ltd.  
 No. 4671 Date: *June 21/20*  
 BID OPPORTUNITY NO. 307-2010

**METRIC**  
 WHOLE NUMBERS INDICATE MILLIMETRES  
 DECIMALIZED NUMBERS INDICATE METRES

	GAS		MANHOLE
	MTS		CATCH BASIN / CATCH PIT
	HYDRO		CURB INLET WITH BOX
	CATV/FO		TREE
	TRAFFIC SIGNALS/PIT		TEST HOLE
	LAND DRAINAGE SEWER		PROPERTY LINE
	SANITARY/COMBINED SEWER		SURVEY BAR
	SSP/DCP		FENCE
	WATERMAIN		BOC/EOPAVT
	SUBDRAIN		ELEVATION (33.100)
	DITCH		TRAFFIC SIGN
	EXISTING		LEGEND - PLAN
	NEW		LEGEND - PLAN
	EXISTING		LEGEND - PLAN
	NEW		LEGEND - PLAN
	EXISTING		LEGEND - PLAN
	NEW		LEGEND - PLAN

	CONCRETE PAVEMENT
	ASPHALT PAVEMENT
	CONC. SIDEWALK/MEDIAN
	PAVING STONE
	GRAVEL
	RAMP CURB
	PLANING/REMOVAL

**LOCATION APPROVED**  
 UNDERGROUND STRUCTURES

BM -  
 ELEV -


1 REVIS - INTERSECTION REALIGNMENT 10/06/21 KLC  
 0 NO LONGER IN CONTRACT  
 0 ISSUED FOR CONSTRUCTION 10/06/09 KLC

NO. REVISIONS YYMMDD BY

DESIGNED BY	JGK/GFN	CHECKED BY	JC
DRAWN BY	KLC	APPROVED BY	TGS
HOR. SCALE	1:250	RELEASED FOR CONSTRUCTION	
VERT. SCALE	1:10	ORIGINAL SIGNED BY: B.M. WOROBY	
DATE	10/06/09	DATE	JUNE 8, 2010

**AECOM**

This drawing has been prepared for the use of AECOM's client and may not be used, reproduced or relied upon by third parties, except as agreed by AECOM and its client, as required by law or for use by governmental reviewing agencies. AECOM accepts no responsibility, and denies any liability whatsoever, to any party that modifies this drawing without AECOM's express written consent. Do not scale this document. All measurements must be obtained from stated dimensions.

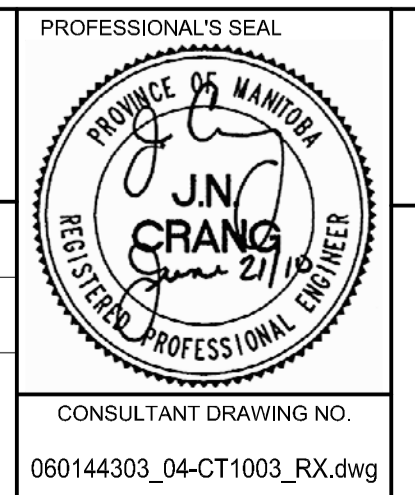

**THE CITY OF WINNIPEG**  
 PUBLIC WORKS DEPARTMENT  
 ENGINEERING DIVISION

2010 ACTIVE TRANSPORTATION/ INFRASTRUCTURE STIMULUS PROGRAM

**HARROW STREET**  
**EBBY AVENUE TO**  
**HARROW STREET E**  
 PARKING LANE, INTERSECTION REALIGNMENT

CITY DRAWING NUMBER W-377-13  
 SHEET 13 OF 22  
 DRAWING No. 13  
 REV 1