
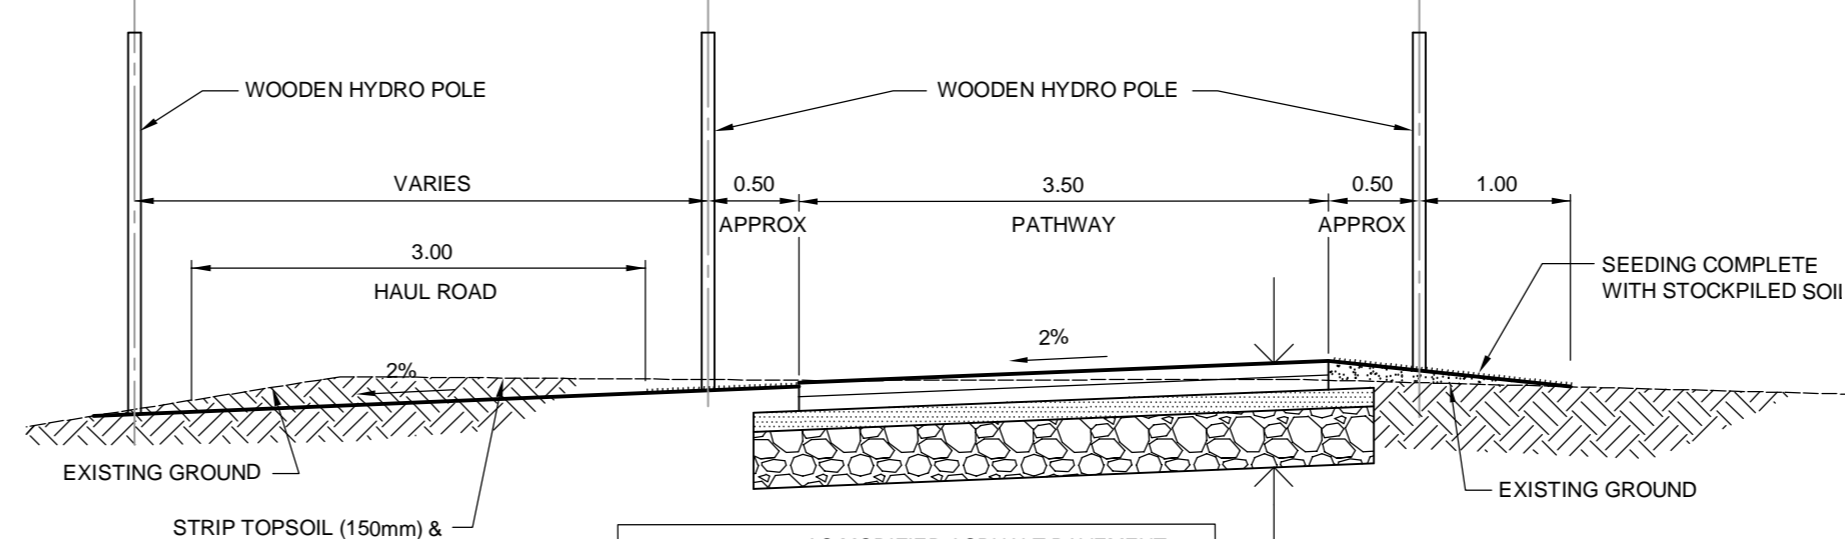


FOR CONSTRUCTION DETAILS WEST OF STA 4+000.00 SEE DRAWING C1009

FOR CONSTRUCTION DETAILS OF THE PATHWAY THROUGH ROTARY HERITAGE PARK SEE DRAWINGS C1028 - C1029

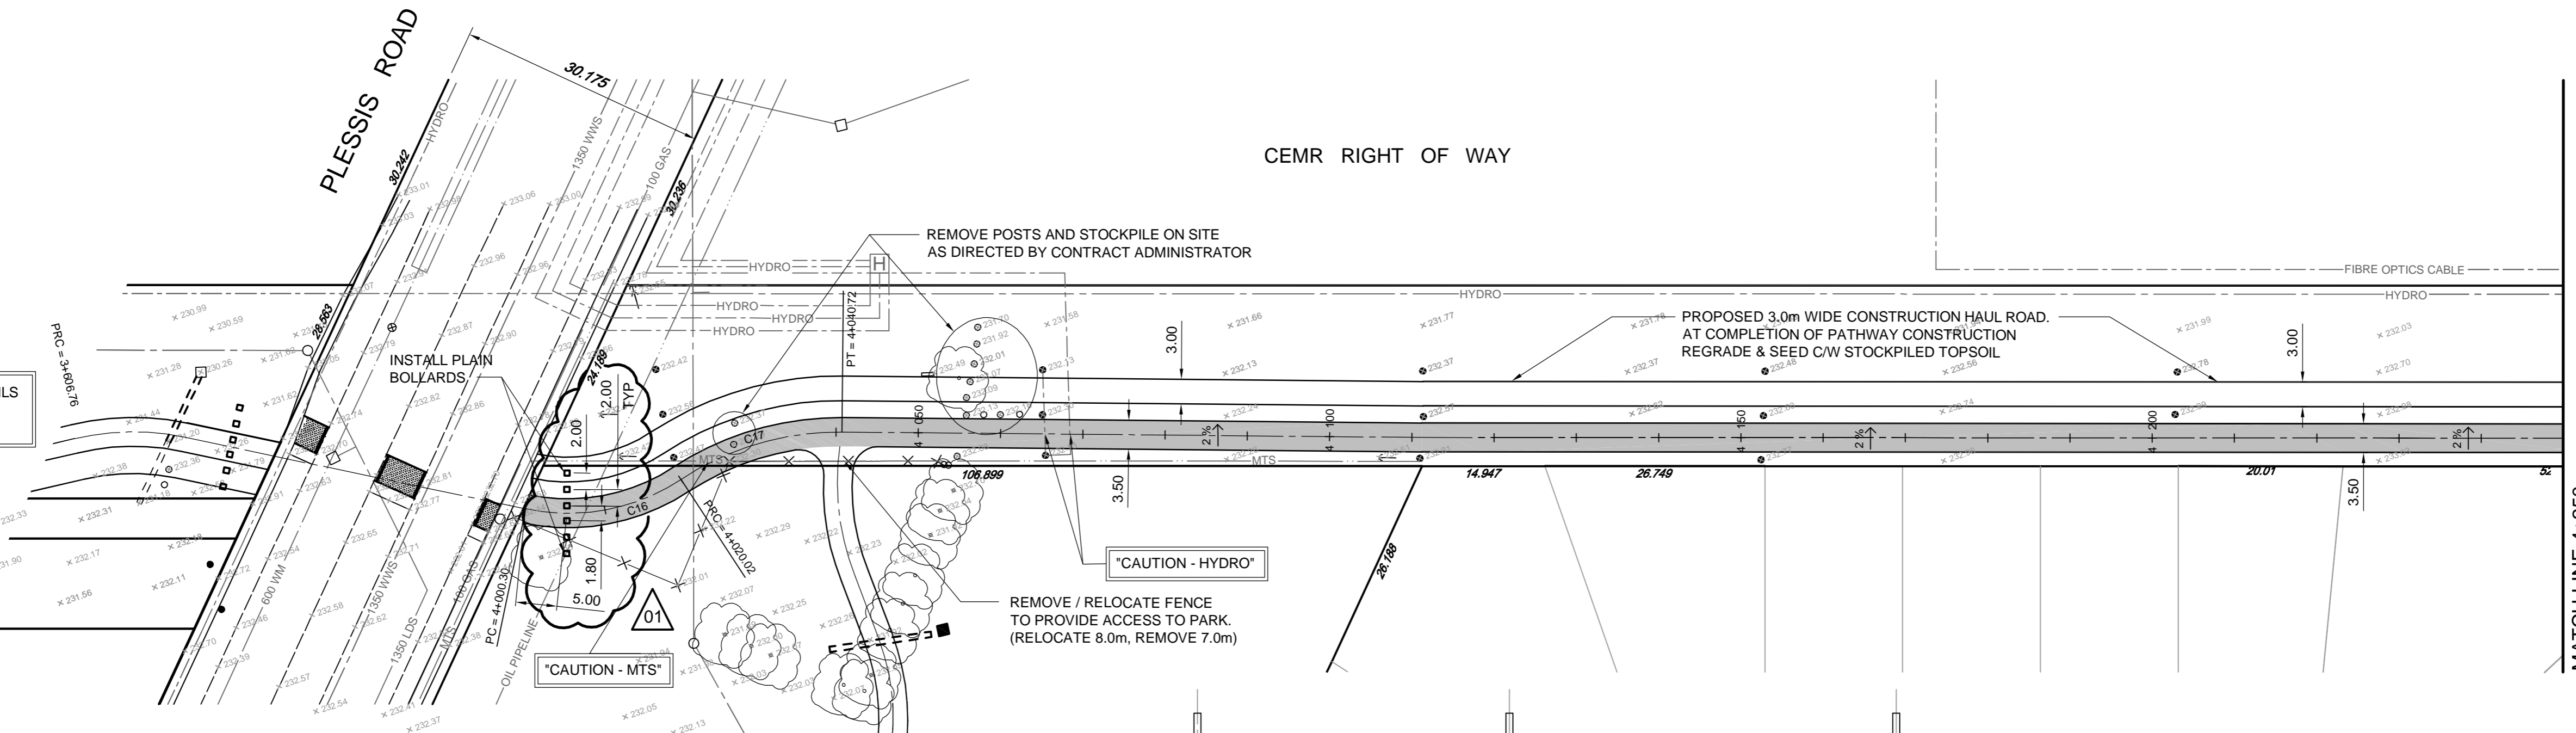


CURVE	RADIUS	TANGENT	DELTA	LENGTH
C16	25.00	10.41	45°12'04"	19.72
C17	35.00	10.66	33°53'16"	20.70

1
TYPICAL PATH SECTION
HOR 1:50, VER 1:20

APEGM
Certificate of Authorization
Wardrop Engineering Inc.
No. 195 Expiry: April 30, 2011

No.	NAD 83 Grid Coordinate		Description
	Northing	Easting	
CP1	5528842.152	639868.658	IRON BAR
CP2	5529368.017	641068.147	IRON BAR
CP3	5530344.824	643436.566	IRON BAR
CP4	5530372.228	643436.161	IRON BAR
CP5	5530394.867	646173.994	IRON BAR

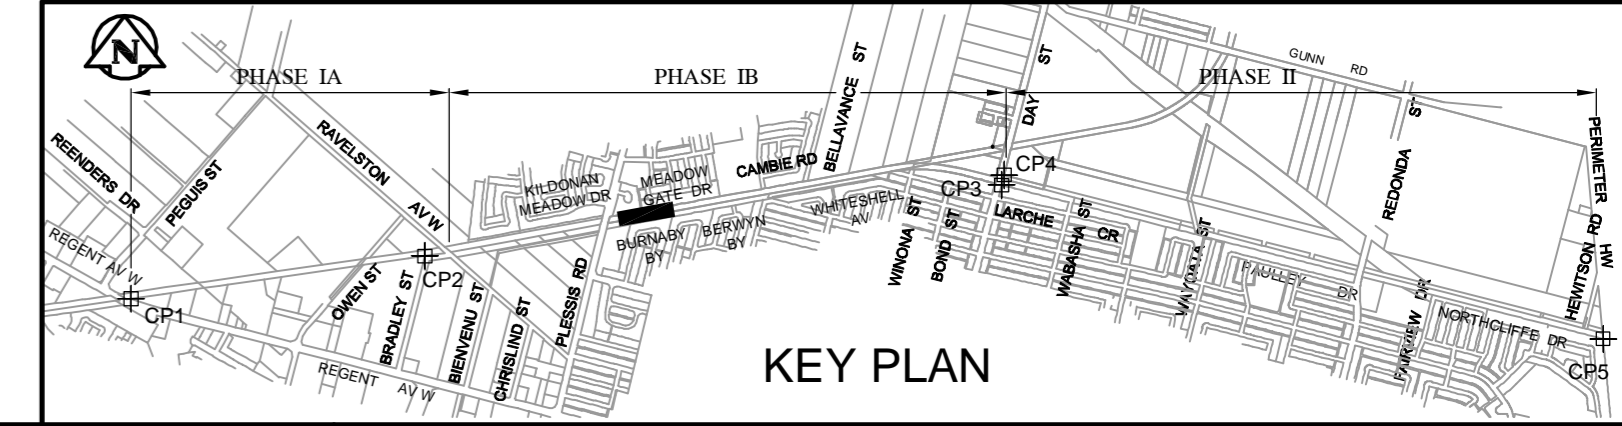

EXISTING	LEGEND-PLAN	PROPOSED	EXISTING	LEGEND-PLAN	PROPOSED	EXISTING	LEGEND-PLAN	PROPOSED
150 WM	WATERMAIN	150 WM	SWALE	TRAFFIC SIGNAL	B.M. ELEV.	400 FM	FEEDERMAIN	400 FM
300 LDS	LAND DRAINAGE SEWER	300 LDS	MANHOLE	GAS	LOCATION APPROVED UNDERGROUND STRUCTURES	300 LDS	LAND DRAINAGE SEWER	300 LDS
250 WWS	WASTEWATER SEWER	250 WWS	CATCHBASIN	HYDRO	DATE	250 WWS	WASTEWATER SEWER	250 WWS
300 CS	COMBINED SEWER	300 CS	HYDRO BOX	MTS	SUPV. U/G STRUCTURES COMMITTEE	200 FCM	FORCEMAIN	200 FCM
200 FCM	FORCEMAIN	200 FCM	HYDRO POLE	SPRINKLER	NOTE:	200 FCM	FORCEMAIN	200 FCM
+	JUNCTIONS	+	LIGHT STANDARD	ELEVATION	LOCATION OF UNDERGROUND STRUCTURES AS SHOWN ARE BASED ON THE BEST INFORMATION AVAILABLE. BUT NO GUARANTEE IS GIVEN THAT ALL EXISTING UTILITIES ARE SHOWN OR THAT THE GIVEN LOCATIONS ARE EXACT. CONFIRMATION OF EXISTENCE AND EXACT LOCATION OF ALL SERVICES MUST BE OBTAINED FROM THE INDIVIDUAL UTILITIES BEFORE PROCEEDING WITH CONSTRUCTION.	+	JUNCTIONS	+
+	HYDRANT	+	ANCHOR	SEWALK		+	HYDRANT	+
+	VALVE	+	TREE	CURB		+	VALVE	+
+	CURB STOP	+	SURVEY BAR	ASPHALT		+	CURB STOP	+
	LEGEND-PLAN	PROPOSED	SIGNAL CONTROLLER	CONCRETE			LEGEND-PLAN	PROPOSED

NO.	REVISIONS	DATE	BY
01	ISSUED FOR ADDENDUM No. 1	10.07.21	DAL
00	ISSUED FOR TENDER	10.07.13	DAL
A	ISSUED FOR APPROVAL	10.07.13	DAL

DESIGNED BY	TF	CHECKED BY
DRAWN BY	NL	APPROVED BY
HOR. SCALE:	1 : 500	RELEASED FOR CONSTRUCTION
VERTICAL:	1 : 20	

WARDROP A TETRA TECH COMPANY
PEOPLE. PASSION. PERFORMANCE. TRUSTED GLOBALLY.

PRELIMINARY DRAWING
NOT TO BE USED FOR CONSTRUCTION

CONSULTANT DRAWING NO. 100070100-DWG-C1010-01

THE CITY OF WINNIPEG
PUBLIC WORKS DEPARTMENT
ENGINEERING DIVISION

2010 ACTIVE TRANSPORTATION / INFRASTRUCTURE STIMULUS PROGRAM

TRANSCONA TRAIL MULTI USE PATHWAY
PLESSIS ROAD TO
250m EAST OF PLESSIS ROAD

CITY DRAWING NUMBER
SHEET 10 OF 31
C1010