
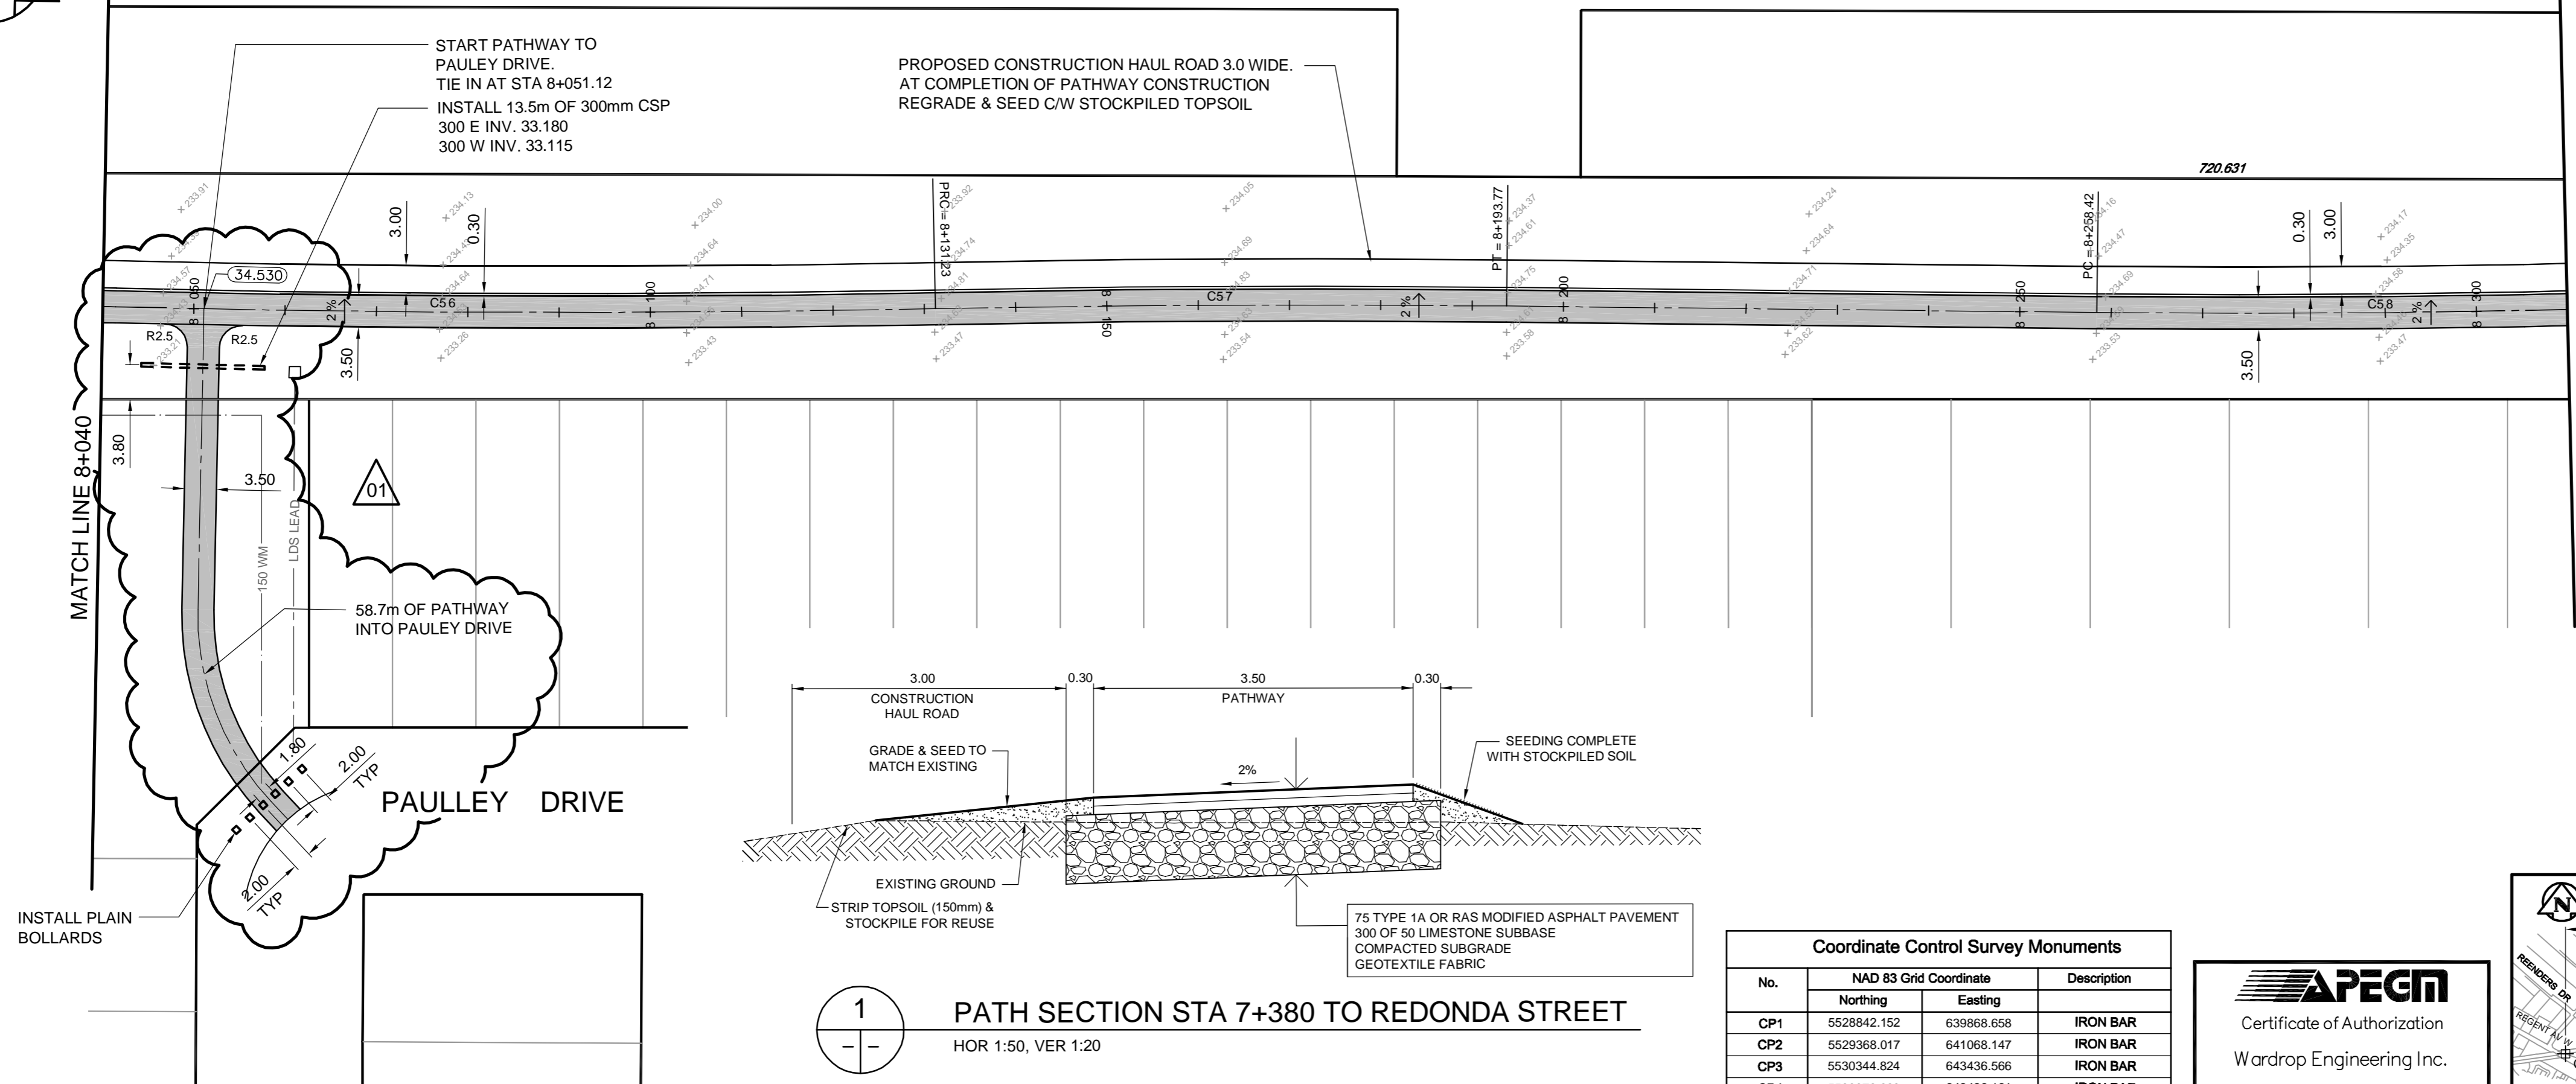


CIRCULAR CURVE DATA				
CURVE	RADIUS	TANGENT	DELTA	LENGTH
C56	2001.00	53.87	3°05'03"	107.71
C57	1999.00	31.27	1°47'33"	62.54
C58	1501.00	31.20	2°22'54"	62.40


Path Coordinates		
Description	Northing	Easting
PRC = 8+131.23	5530376.7884	644560.6732
PT = 8+193.77	5530378.2993	644623.1907
PC = 8+258.42	5530378.8708	644687.8434

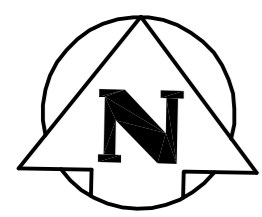

1 PATH SECTION STA 7+380 TO REDONDA STREET
HOR 1:50, VER 1:20

Coordinate Control Survey Monuments			
No.	NAD 83 Grid Coordinate	Description	
	Northing	Easting	
CP2	5529368.017	641068.147	IRON BAR
CP3	5530344.824	643436.566	IRON BAR
CP4	5530372.228	643436.161	IRON BAR
CP5	5530394.867	646173.994	IRON BAR

APEGM
Certificate of Authorization
Wardrop Engineering Inc.
No. 195 Expiry: April 30, 2011

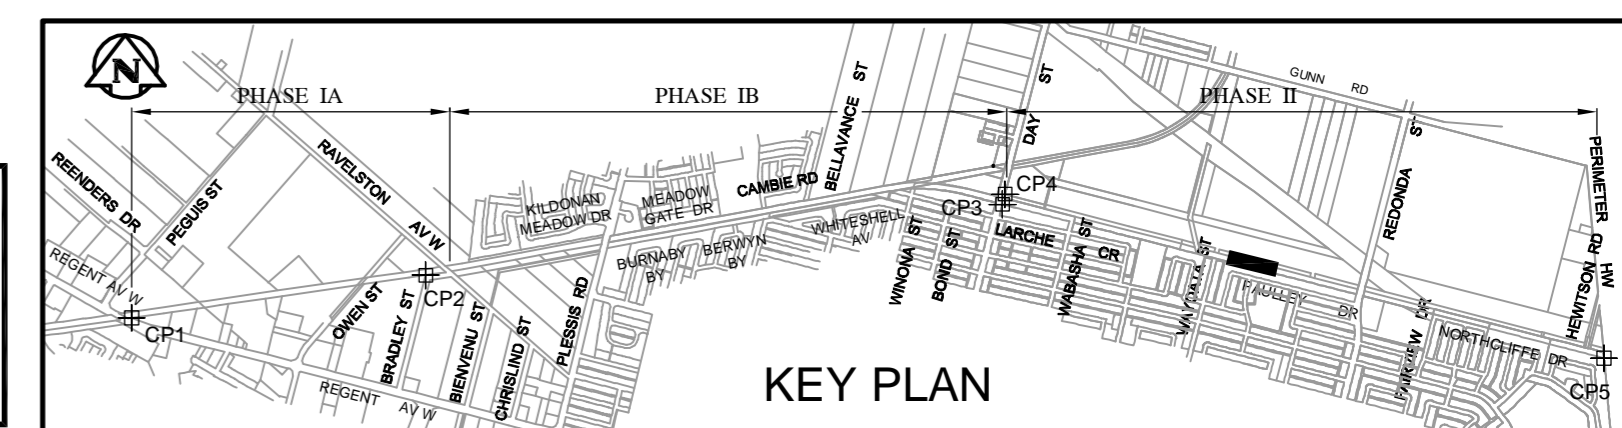

EXISTING	LEGEND-PLAN	PROPOSED	EXISTING	LEGEND-PLAN	PROPOSED	EXISTING	LEGEND-PLAN	PROPOSED
150 WM	WATERMAIN	150 WM	SWALE	TRAFFIC SIGNAL	MANHOLE	400 FM	FEEDERMAIN	400 FM
300 LDS	LAND DRAINAGE SEWER	300 LDS	CATCHBASIN	HYDRO	250 WWS	WASTEWATER SEWER	250 WWS	WASTEWATER SEWER
300 CS	COMBINED SEWER	300 CS	HYDRO POLE	SPRINKLER	200 FCM	FORCEMAIN	200 FCM	FORCEMAIN
200 FCM	JUNCTIONS	200 FCM	LIGHT STANDARD	ELEVATION	HYDRANT	HYDRANT	HYDRANT	HYDRANT
	VALVE	VALVE	ANCHOR	SIDEWALK	CURB STOP	CURB STOP	CURB STOP	CURB STOP
	LEGEND-PLAN	PROPOSED	LEGEND-PLAN	PROPOSED	LEGEND-PLAN	PROPOSED	LEGEND-PLAN	PROPOSED

LOCATION APPROVED UNDERGROUND STRUCTURES
SUPV. U/G STRUCTURES COMMITTEE DATE
NOTE: LOCATION OF UNDERGROUND STRUCTURES AS SHOWN ARE BASED ON THE BEST INFORMATION AVAILABLE. BUT NO GUARANTEE IS GIVEN THAT ALL EXISTING UTILITIES ARE SHOWN OR THAT THE GIVEN LOCATIONS ARE EXACT. CONFIRMATION OF EXISTENCE AND EXACT LOCATION OF ALL SERVICES MUST BE OBTAINED FROM THE INDIVIDUAL UTILITIES BEFORE PROCEEDING WITH CONSTRUCTION.

NO.	REVISIONS	DATE	BY	DATE	BY
01	ISSUED FOR ADDENDUM No. 1	10.07.21	DAL		
00	ISSUED FOR TENDER	10.07.13	DAL		
A	ISSUED FOR APPROVAL	10.07.13	DAL		

WARDROP PEOPLE. PASSION. PERFORMANCE. TRUSTED GLOBALLY.
DESIGNED BY TF CHECKED BY
DRAWN BY NL APPROVED BY
HOR. SCALE: 1 : 500
VERTICAL: 1 : 20
RELEASED FOR CONSTRUCTION

PRELIMINARY DRAWING
NOT TO BE USED FOR CONSTRUCTION
CONSULTANT DRAWING NO. 1000070100-DWG-C1021-01

THE CITY OF WINNIPEG
PUBLIC WORKS DEPARTMENT
ENGINEERING DIVISION
2010 ACTIVE TRANSPORTATION / INFRASTRUCTURE STIMULUS PROGRAM
TRANSCONA TRAIL MULTI USE PATHWAY
56m EAST OF WAYOATA STREET TO STATION 8+310
CITY DRAWING NUMBER 21 OF 31
SHEET 21 OF 31
C1021