REF. or DRAWING No. 2
DETAILS FILE # LD 10313

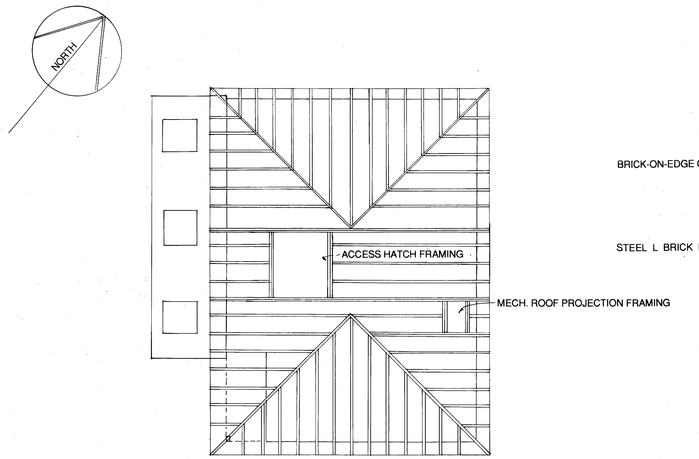

1/3 **ROOF FRAMING PLAN**

SCALE -- 1 : 100

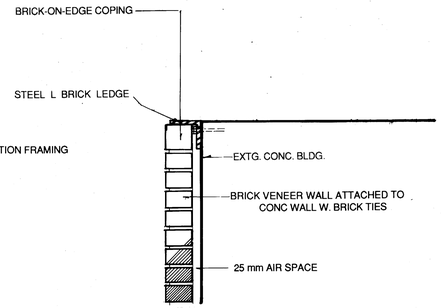

3/3 **SECTION DETAIL : BRICK COPING**

SCALE -- 1 : 10

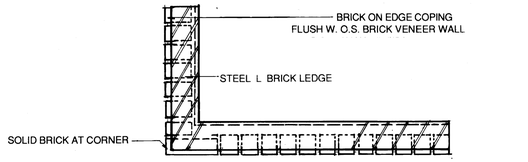

5/3 **PLAN DETAIL : BRICK COPING**

SCALE -- 1 : 10

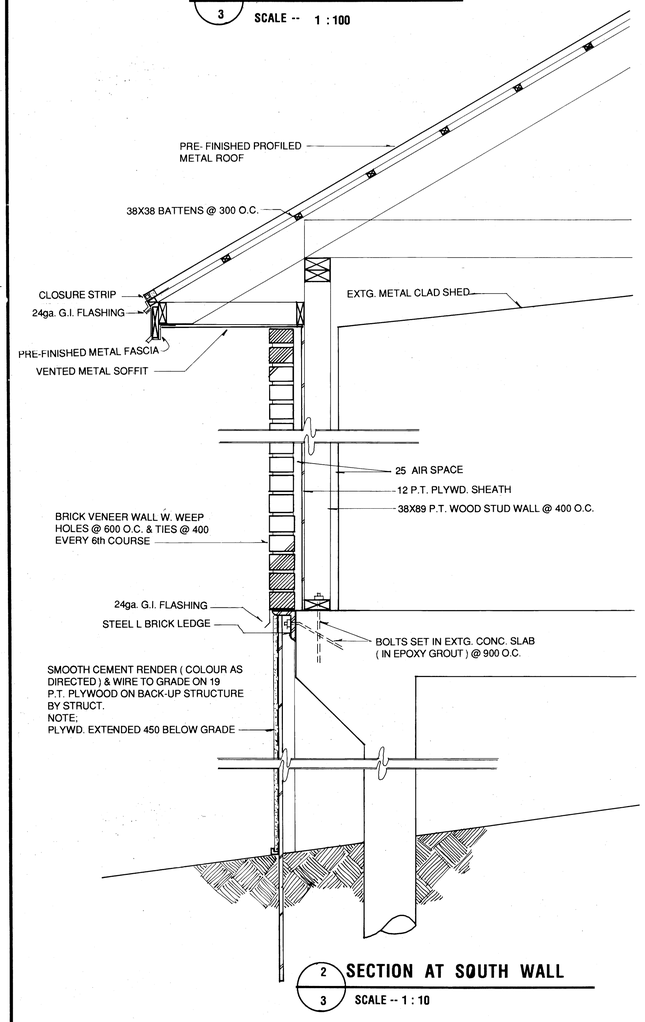

2/3 **SECTION AT SOUTH WALL**

SCALE -- 1 : 10

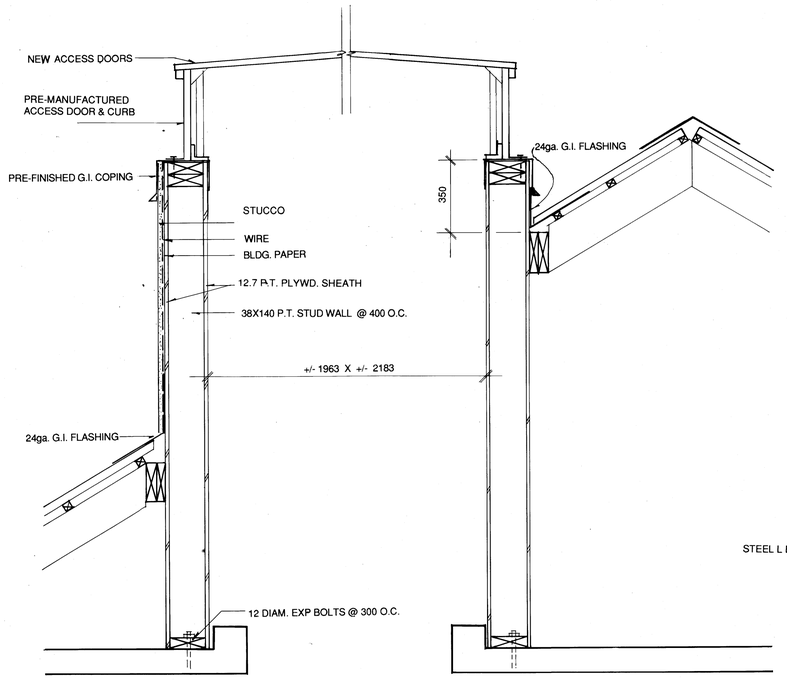

4/3 **DETAIL THROUGH ACCESS HATCH**

SCALE -- 1 : 10

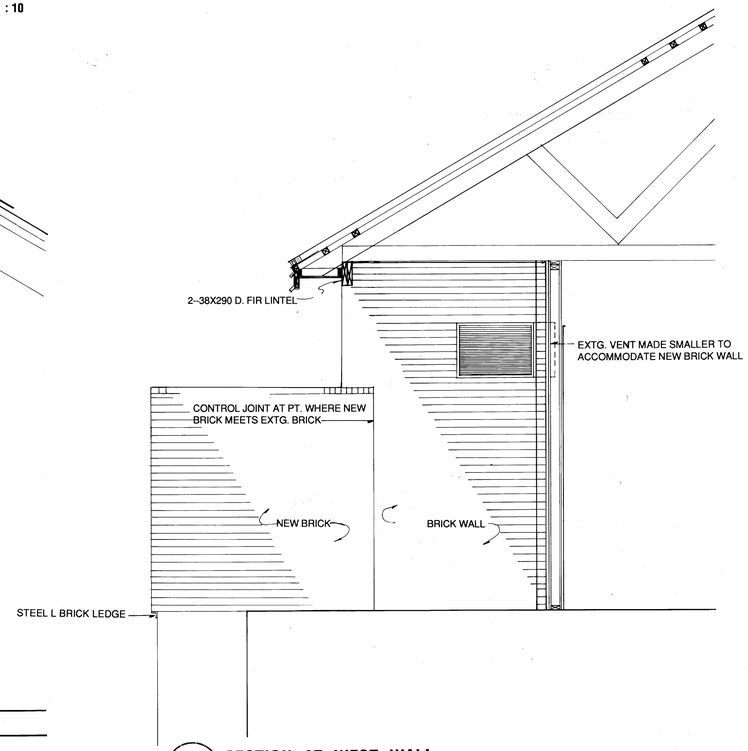

6/3 **SECTION AT WEST WALL**

SCALE -- 1 : 25

B.M. ELEV				LLEWELLIN SIMON ASSOCIATES	ENGINEER'S SEAL	THE CITY OF WINNIPEG
				403-63 Albert St. Winnipeg, MB R3B 1G4 (204) 947-9301		WORKS AND OPERATIONS DIVISION
				LANDSCAPE ARCHITECTURE • URBAN DESIGN • ARCHITECTURE		WATERWORKS, WASTE & DISPOSAL FILE # LD 10313
				DESIGNED BY TPLL / CHECKED BY S. Phelps		COCKBURN ST. PUMPING STATION
				DRAWN BY KR / APPROVED BY S. Phelps		ARCHITECTRAL IMPROVEMENTS & SITE LANDSCAPING
				HOR SCALE AS SHOWN / VERTICAL / RELEASED FOR CONSTRUCTION		CITY DRAWING NUMBER LD - 961
A	AS CONSTRUCTED	10 22 89	G P	DATE FEB. 1989 / DATE FEB 16/89	CONSULTANT DRAWING NO. 8709 – A 3	SHEET 4 OF 8
NO.	REVISIONS	DATE	BY			BUILDING: DETAILS