

**PLANT LIST**

| No.                     | COMMON NAME          | BOTANICAL NAME                    | SIZE / HEIGHT | NOTES     |
|-------------------------|----------------------|-----------------------------------|---------------|-----------|
| <b>DECIDUOUS SHRUBS</b> |                      |                                   |               |           |
| 6                       | Morden Amber Dogwood | <i>Cornus alba</i> 'Morden Amber' | 0.75m ht.     | Container |

SPECIFICATION: All plant material to be supplied and installed in accordance with the latest edition of Landscape Canada's Metric Guide Specifications for Nursery Stock.

NOTE: SEE PLANTING DETAILS, SHEET 01-L-4002

**SEED MIX**

**NORTH SIDE (PALMERSTON AVE.)**

MID AND UPPER BANK SEED MIX by weight 0.5 kg / 100m<sup>2</sup>

|                    |                               |     |
|--------------------|-------------------------------|-----|
| Slender Wheatgrass | <i>Agropyron trachycaulum</i> | 20% |
| Big Bluestem       | <i>Andropogon gerardii</i>    | 30% |
| Canada Wild Rye    | <i>Elymus canadensis</i>      | 10% |
| Switch Grass       | <i>Panicum virgatum</i>       | 20% |
| Green Needlegrass  | <i>Stipa viridula</i>         | 20% |

**ADD TO MID BANK SEED MIX**

|                 |                              |     |
|-----------------|------------------------------|-----|
| Slough Grass    | <i>Beckmannia syzigachne</i> | 10% |
| Fowl Blue Grass | <i>Poa palustris</i>         | 10% |

Sideoats Grama *Bouteloua curtipendula* 0.4 kg / 100m<sup>2</sup>

**SOUTH SIDE (WELLINGTON CRES.)**

MID AND UPPER BANK SEED MIX by weight 0.5 kg / 100m<sup>2</sup>

|                    |                               |     |
|--------------------|-------------------------------|-----|
| Slender Wheatgrass | <i>Agropyron trachycaulum</i> | 20% |
| Big Bluestem       | <i>Andropogon gerardii</i>    | 20% |
| Canada Milkvetch   | <i>Astragalus canadensis</i>  | 10% |
| Fringed Brome      | <i>Bromus ciliatus</i> L.     | 10% |
| Canada Wild Rye    | <i>Elymus canadensis</i>      | 20% |
| Switch Grass       | <i>Panicum virgatum</i>       | 20% |

Sideoats Grama *Bouteloua curtipendula* 0.4 kg / 100m<sup>2</sup>

**LEGEND**

|  |   |
|--|---|
|  | PROPOSED RIP RAP REFER TO GEOTECHNICAL DWGS |
|  | GRAVEL                                      |
|  | SOD   |
|  | UPPER BANK SEEDING                          |
|  | MID BANK SEEDING                            |

SCALE 1:150

NORTH BANK

NOTE: SOD AND SEED EXTENTS ARE APPROXIMATE ONLY. LIMITS WILL BE DETERMINED BY THE CONTRACT ADMINISTRATOR.

| EXISTING | LEGEND - PLAN       | NEW | EXISTING | LEGEND - PLAN       | NEW | EXISTING | LEGEND - PROFILE    | NEW |
|----------|---------------------|-----|----------|---------------------|-----|----------|---------------------|-----|
|          | WATERMAIN           |     |          | CURB STOP           |     |          | WATERMAIN           |     |
|          | HYDRANT             |     |          | REDUCER             |     |          | HYDRANT             |     |
|          | VALVE               |     |          | COUPLING            |     |          | VALVE               |     |
|          | LAND DRAINAGE SEWER |     |          | LAND DRAINAGE SEWER |     |          | LAND DRAINAGE SEWER |     |
|          | WASTE WATER SEWER   |     |          | WASTE WATER SEWER   |     |          | WASTE WATER SEWER   |     |
|          | MANHOLE             |     |          | MTS                 |     |          | MANHOLE             |     |
|          | CATCH BASIN         |     |          | GAS                 |     |          | CATCH BASIN         |     |
|          | CURB INLET          |     |          | TESTHOLE            |     |          | CURB INLET          |     |
|          | CULVERT             |     |          | LAMP STANDARD       |     |          | CULVERT             |     |
|          | PIPE ABANDONMENTS   |     |          | TREE                |     |          | PIPE ABANDONMENTS   |     |
|          | SURVEY BAR          |     |          |                     |     |          | SURVEY BAR          |     |

**LOCATION APPROVED UNDERGROUND STRUCTURES**

SUPR. U/G STRUCTURES DATE COMMITTEE  
NOTE: LOCATION OF UNDERGROUND STRUCTURES AS SHOWN ARE BASED ON THE BEST INFORMATION AVAILABLE. BUT NO GUARANTEE IS GIVEN THAT ALL EXISTING UTILITIES ARE SHOWN OR THAT THE GIVEN LOCATIONS ARE EXACT. CONFIRMATION OF EXISTENCE AND EXACT LOCATION OF ALL SERVICES MUST BE OBTAINED FROM THE INDIVIDUAL UTILITIES BEFORE PROCEEDING WITH CONSTRUCTION.

| NO. | REVISIONS                  | DATE     | BY  |
|-----|----------------------------|----------|-----|
| 1   | REVISED FOR ADDENDUM No. 1 | 11/05/30 | LJV |
| 0   | ISSUED FOR CONSTRUCTION    | 11/05/09 | LJV |

|              |                     |                           |
|--------------|---------------------|---------------------------|
| <b>AECOM</b> | DESIGNED BY LJV     | CHECKED BY Don Hester     |
|              | DRAWN BY WJD/LJV    | APPROVED BY Andy Nagy     |
|              | HOR. SCALE AS NOTED | RELEASED FOR CONSTRUCTION |
|              | VERT. SCALE NA      | DATE                      |


PROFESSIONAL'S SEAL  
Revision 1  
Revised For Addendum No. 1  
Signed & Sealed By:  
L. JOY VIBERG  
member no. 125  
11/05/30  
CONSULTANT DRAWING NO.  
D265-230-02\_01-L-1002\_RX.dwg

**THE CITY OF WINNIPEG WATER AND WASTE DEPARTMENT**

**REHABILITATION / REPLACEMENT OF THE MID TOWN FEEDERMAIN AT THE ASSINIBOINE RIVER**

LANDSCAPE REVEGETATION PLAN NORTH BANK

SHEET 17 OF 18  
CITY DRAWING NUMBER  
D-12243

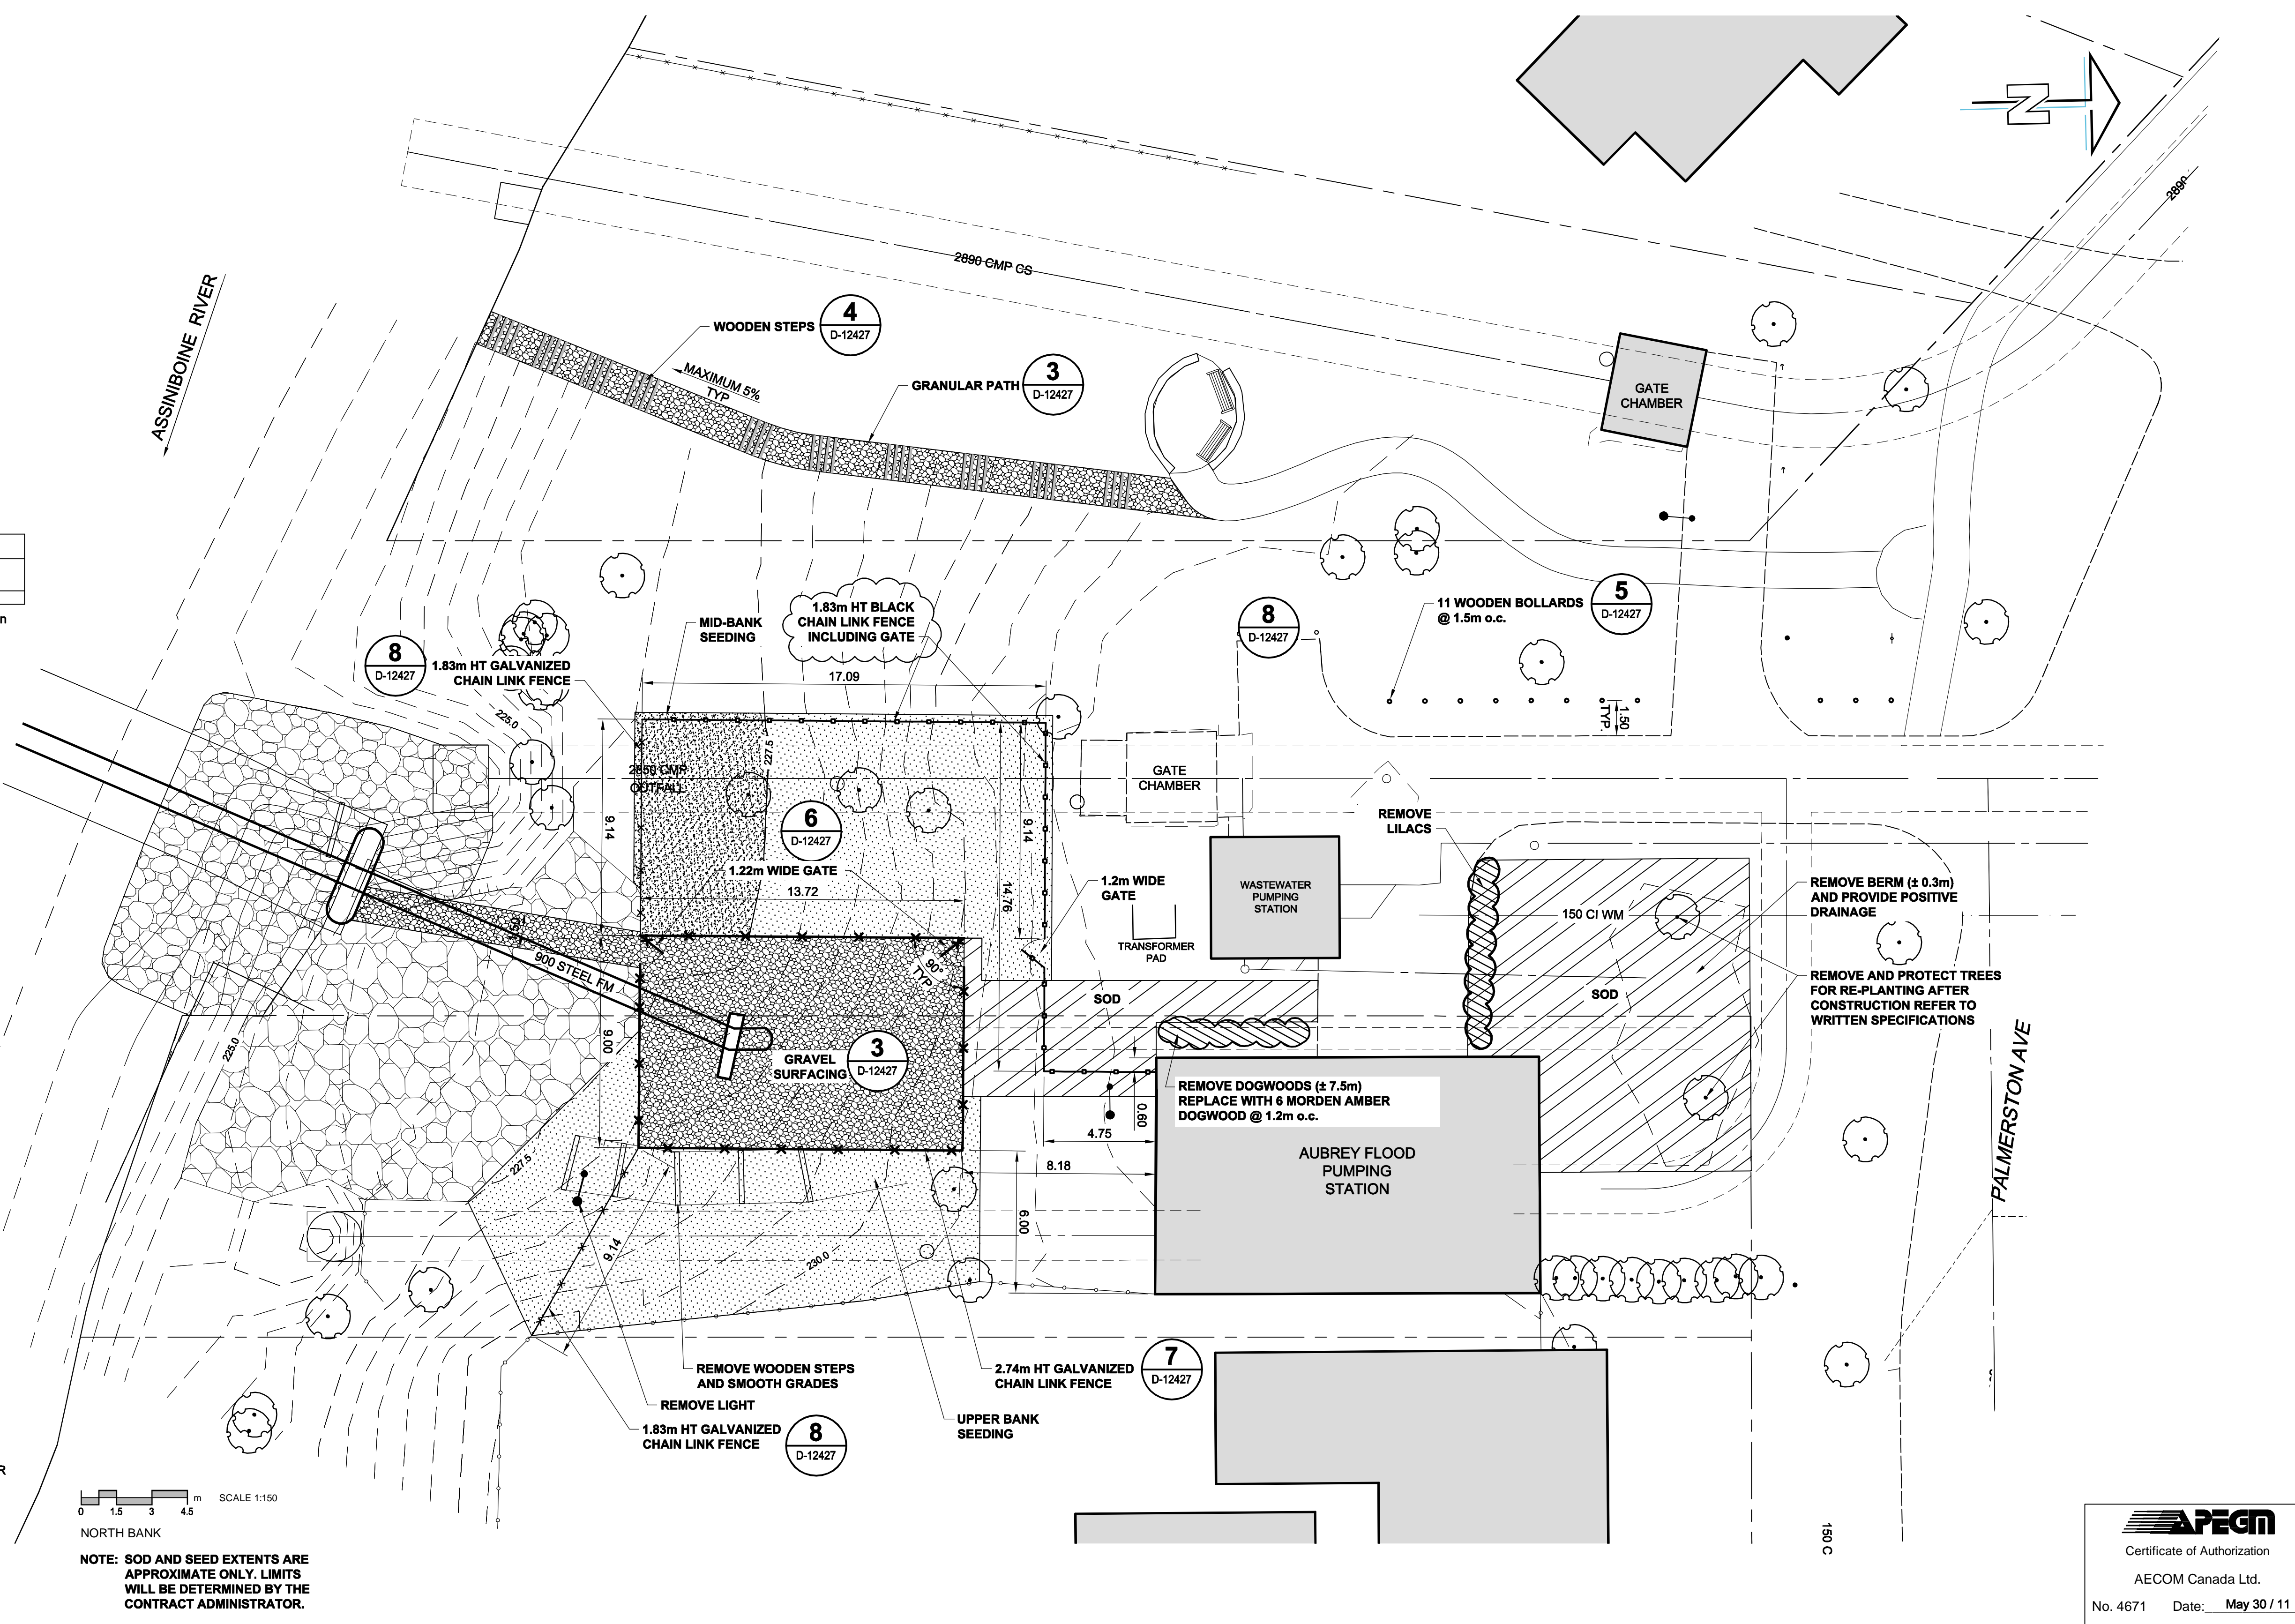

**AECOM**  
Certificate of Authorization  
AECOM Canada Ltd.  
No. 4671 Date: May 30 / 11  
BID OPPORTUNITY NO. 854-2010