


**PRELIMINARY**  
**Not For Construction**

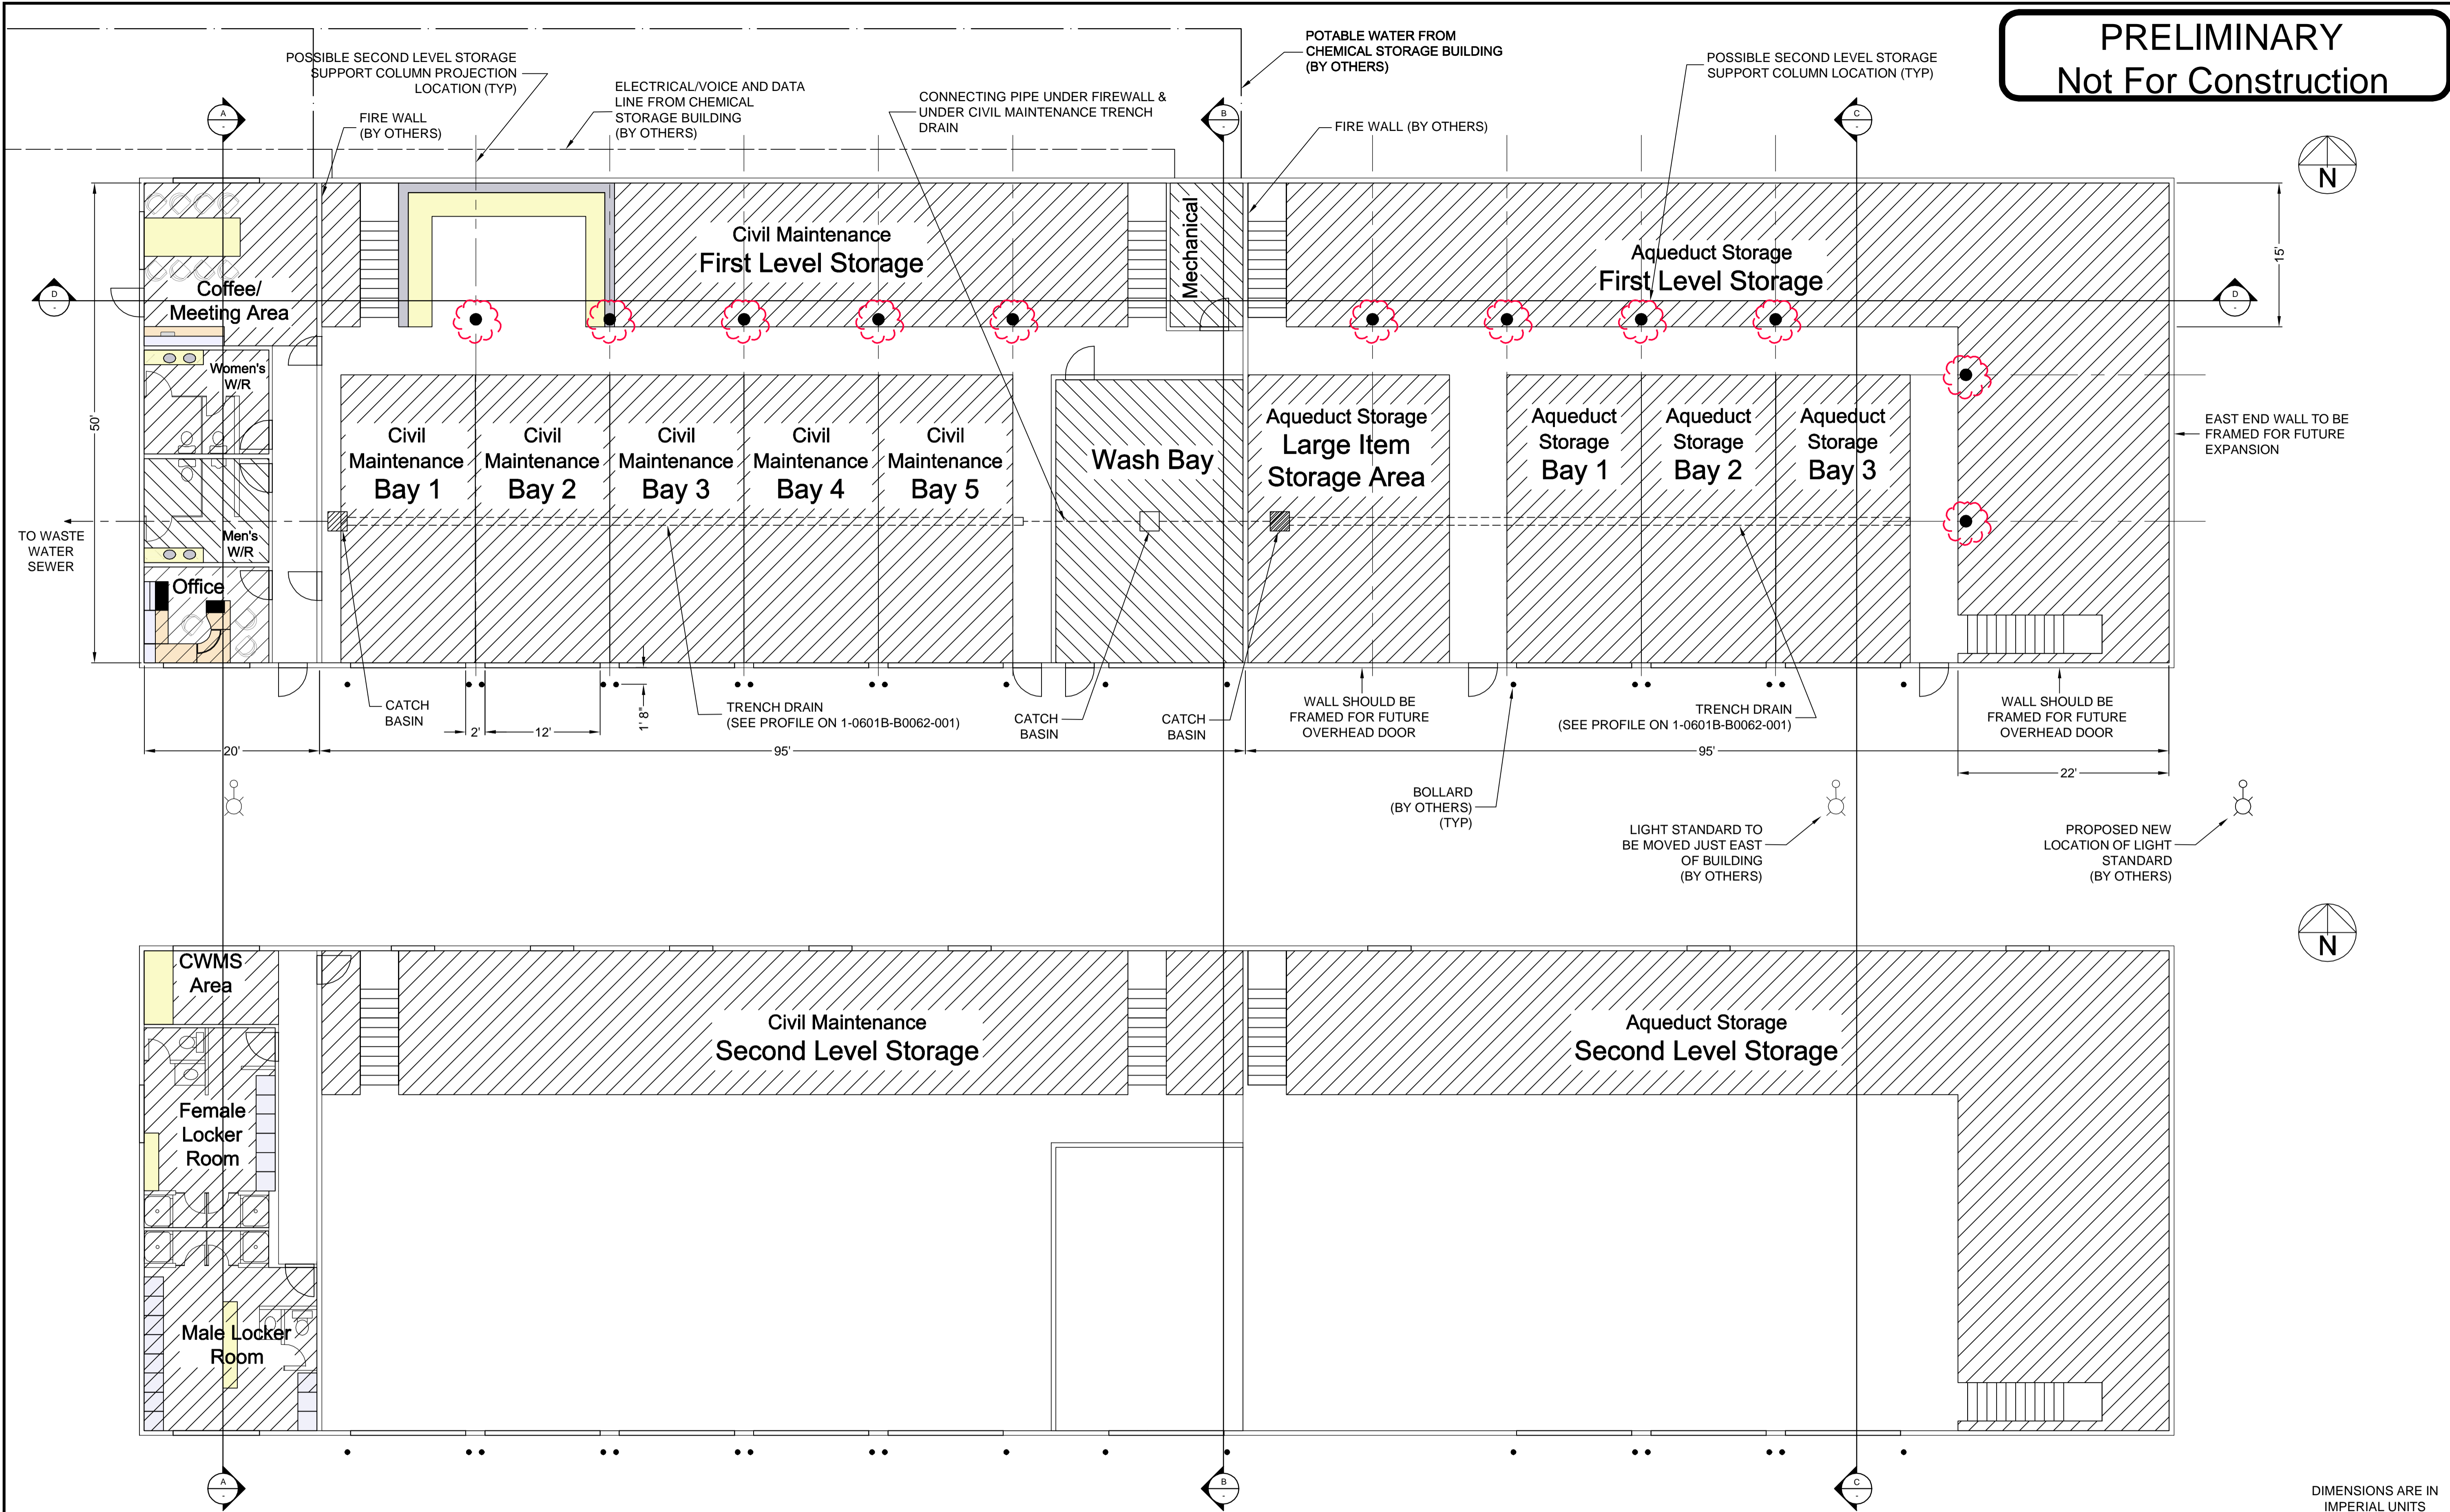

150 mm W.M.	WATERMAIN	150 mm W.M.	HYDRO	300mm L.D.S.	LAND DRAINAGE SEWER	250mm W.W.S.	WASTEWATER SEWER	250mm W.W.S.	MANHOLE	232.750	ELEVATION	TREE	ANODE	CONCRETE SIDEWALK	FENCE		

B.M. ELEV.	DESIGNED BY	AMC	CHECKED BY	AMC/CJH	SCALE:	RELEASED FOR CONSTRUCTION BY:
1	ADDED POSSIBLE SUPPORT COLUMN LOCATIONS	11.10.25	CJH			
NO.	REVISIONS	DATE	BY	DATE	DATE	DATE

ENGINEER'S SEAL

**THE CITY OF WINNIPEG**  
WATER AND WASTE DEPARTMENT  
ENGINEERING DIVISION

WINNIPEG DRINKING WATER TREATMENT PLANT

CITY FILE NUMBER

SHEET 2 OF 4

CIVIL MAINTENANCE/AQUEDUCT STORAGE BUILDING

PLAN VIEW

CITY DRAWING NUMBER 1-0601B-B0061-001

DIMENSIONS ARE IN IMPERIAL UNITS