



Wood Fibre Safety Surfacing Drainage Diagram

SCD
650a-R1

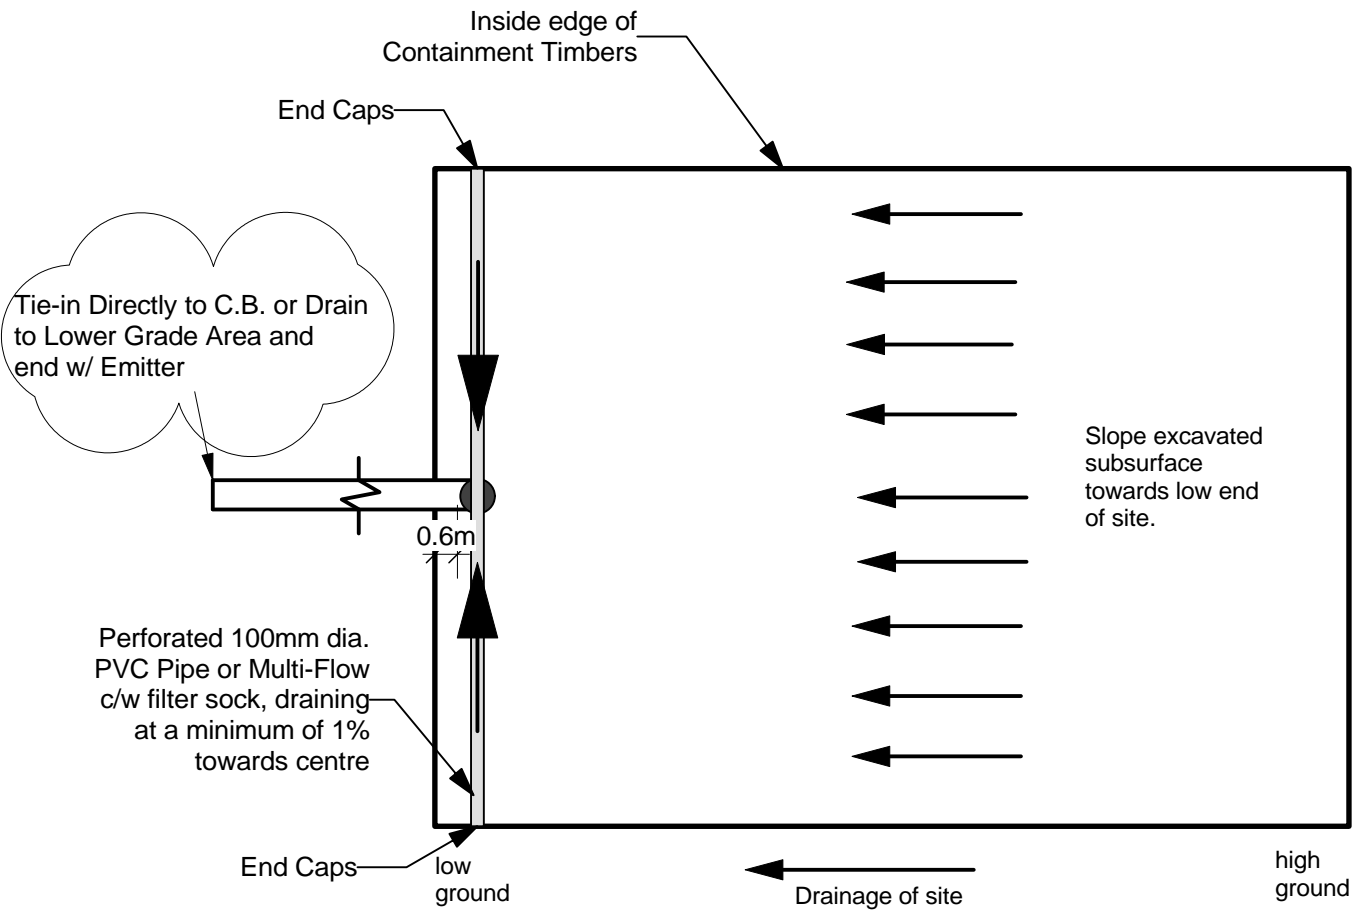

Plan
NTS

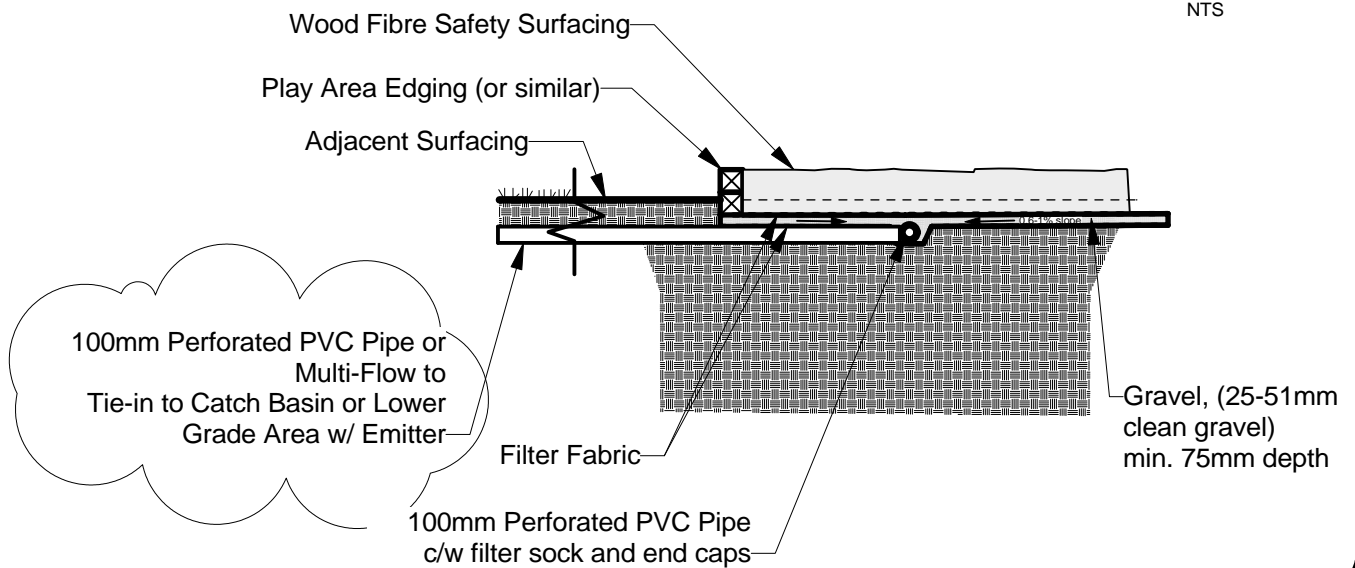

Section
NTS

Drawn By: SP
Date: Jan 2009

THE CITY OF WINNIPEG
Planning, Property and Development Department
Planning and Land Use Division
Unit 15 - 10 Fort Street, Winnipeg, MB, R3C 4X5

