


THIS DRAWING MUST NOT BE SCALED.  
 THE GENERAL CONTRACTOR SHALL VERIFY ALL DIMENSIONS, DATUMS, AND LEVELS PRIOR TO COMMENCEMENT OF WORK. ALL ERRORS AND OMISSIONS TO BE REPORTED TO NUMBER TEN ARCHITECTURAL GROUP BEFORE PROCEEDING.  
 VARIATIONS AND MODIFICATIONS TO WORK SHOWN ON THESE DRAWINGS SHALL NOT BE CARRIED OUT WITHOUT WRITTEN PERMISSION OF NUMBER TEN ARCHITECTURAL GROUP.  
 THIS DRAWING IS THE EXCLUSIVE PROPERTY OF NUMBER TEN ARCHITECTURAL GROUP AND THE COPYRIGHT IN THE SAME BEING RESERVED TO THEM. IT MAY BE REPRODUCED ONLY WITH THE PERMISSION OF NUMBER TEN ARCHITECTURAL GROUP, IN WHICH CASE THE REPRODUCTION MUST BEAR THEIR NAME.

REVISED/	ISSUED/	PLOTTED	DATE
▲	ADDENDA	REVISION	8 MARCH 2012

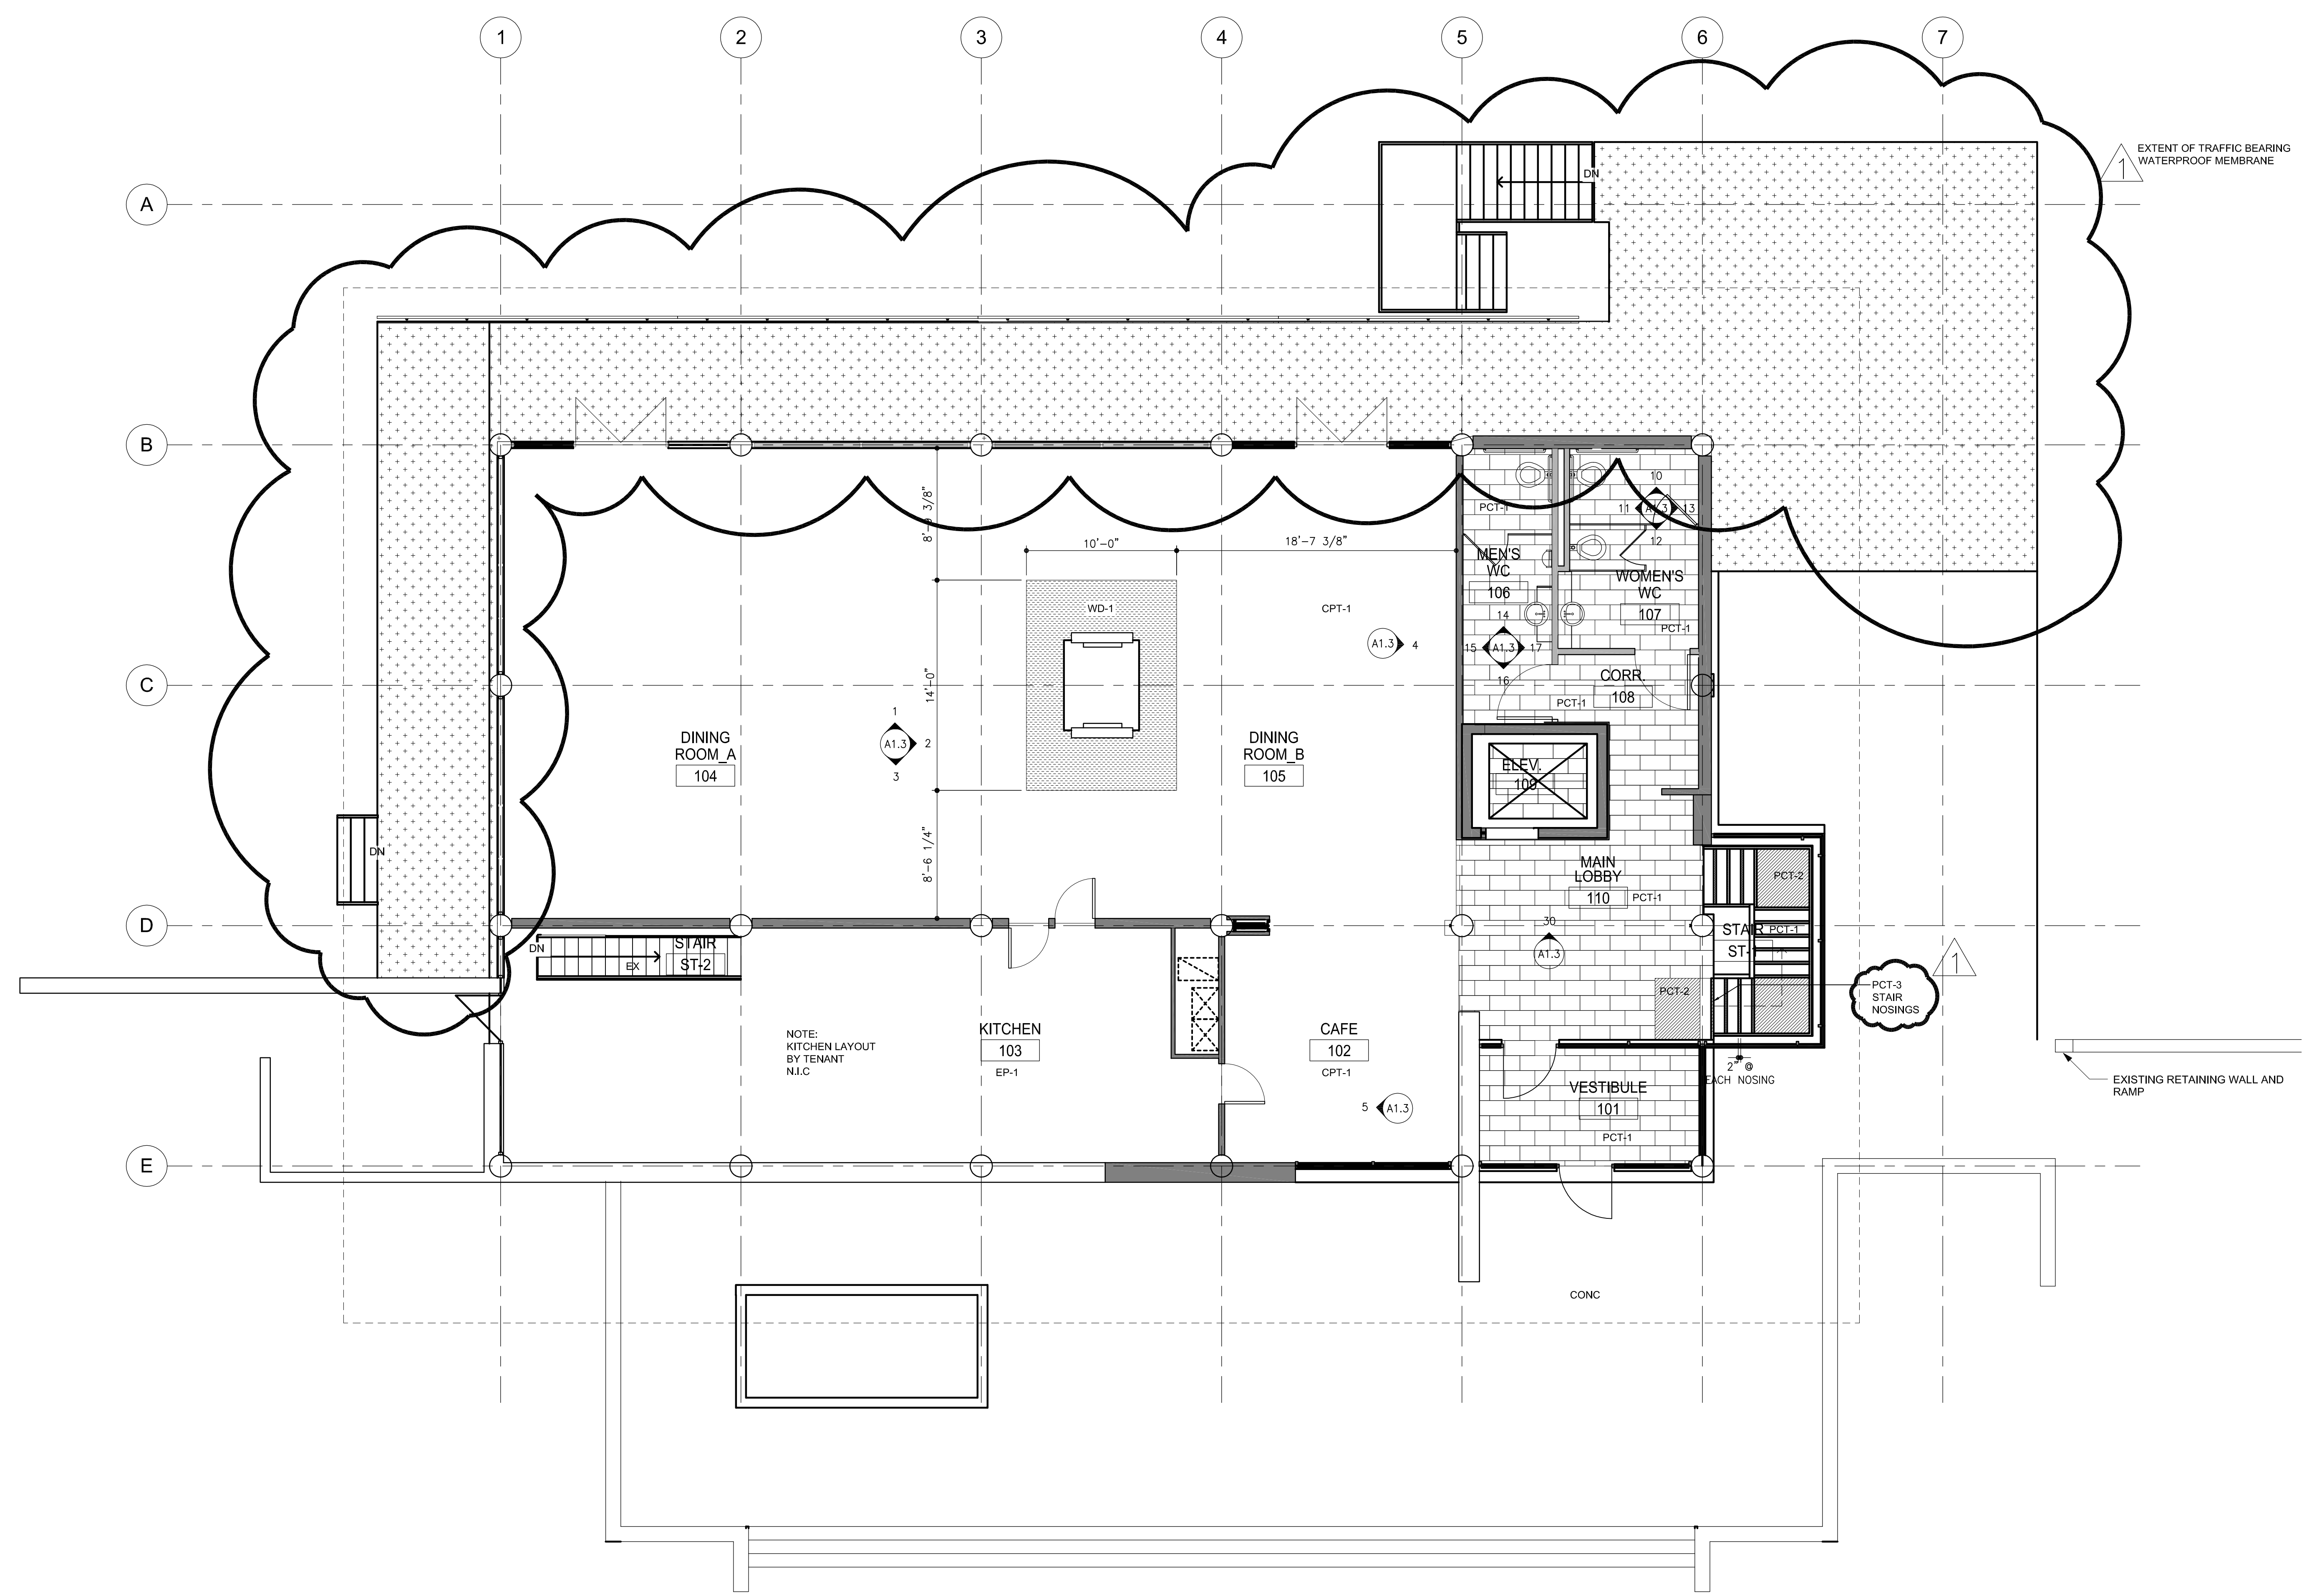

**numberTEN**  
 architectural group  
 winnipeg MB regina SK victoria BC  
 204 942.0981 306 721.1501 250 360.2106  
 architecture • interior design • graphic design

**PEGUIS PAVILION**  
 UPGRADES AND ADDITION  
 KILDONAN PARK  
 project  
 MAIN FLOOR PLAN  
 FLOOR FINISHES  
 sheet title  
 consultant

seal  
 drawn by: KDS  
 checked by: RB  
 project no. 2011026  
 scale: 3/16"=1'-0"  
 date: 23 NOV 11  
 sheet no. **A1.6**