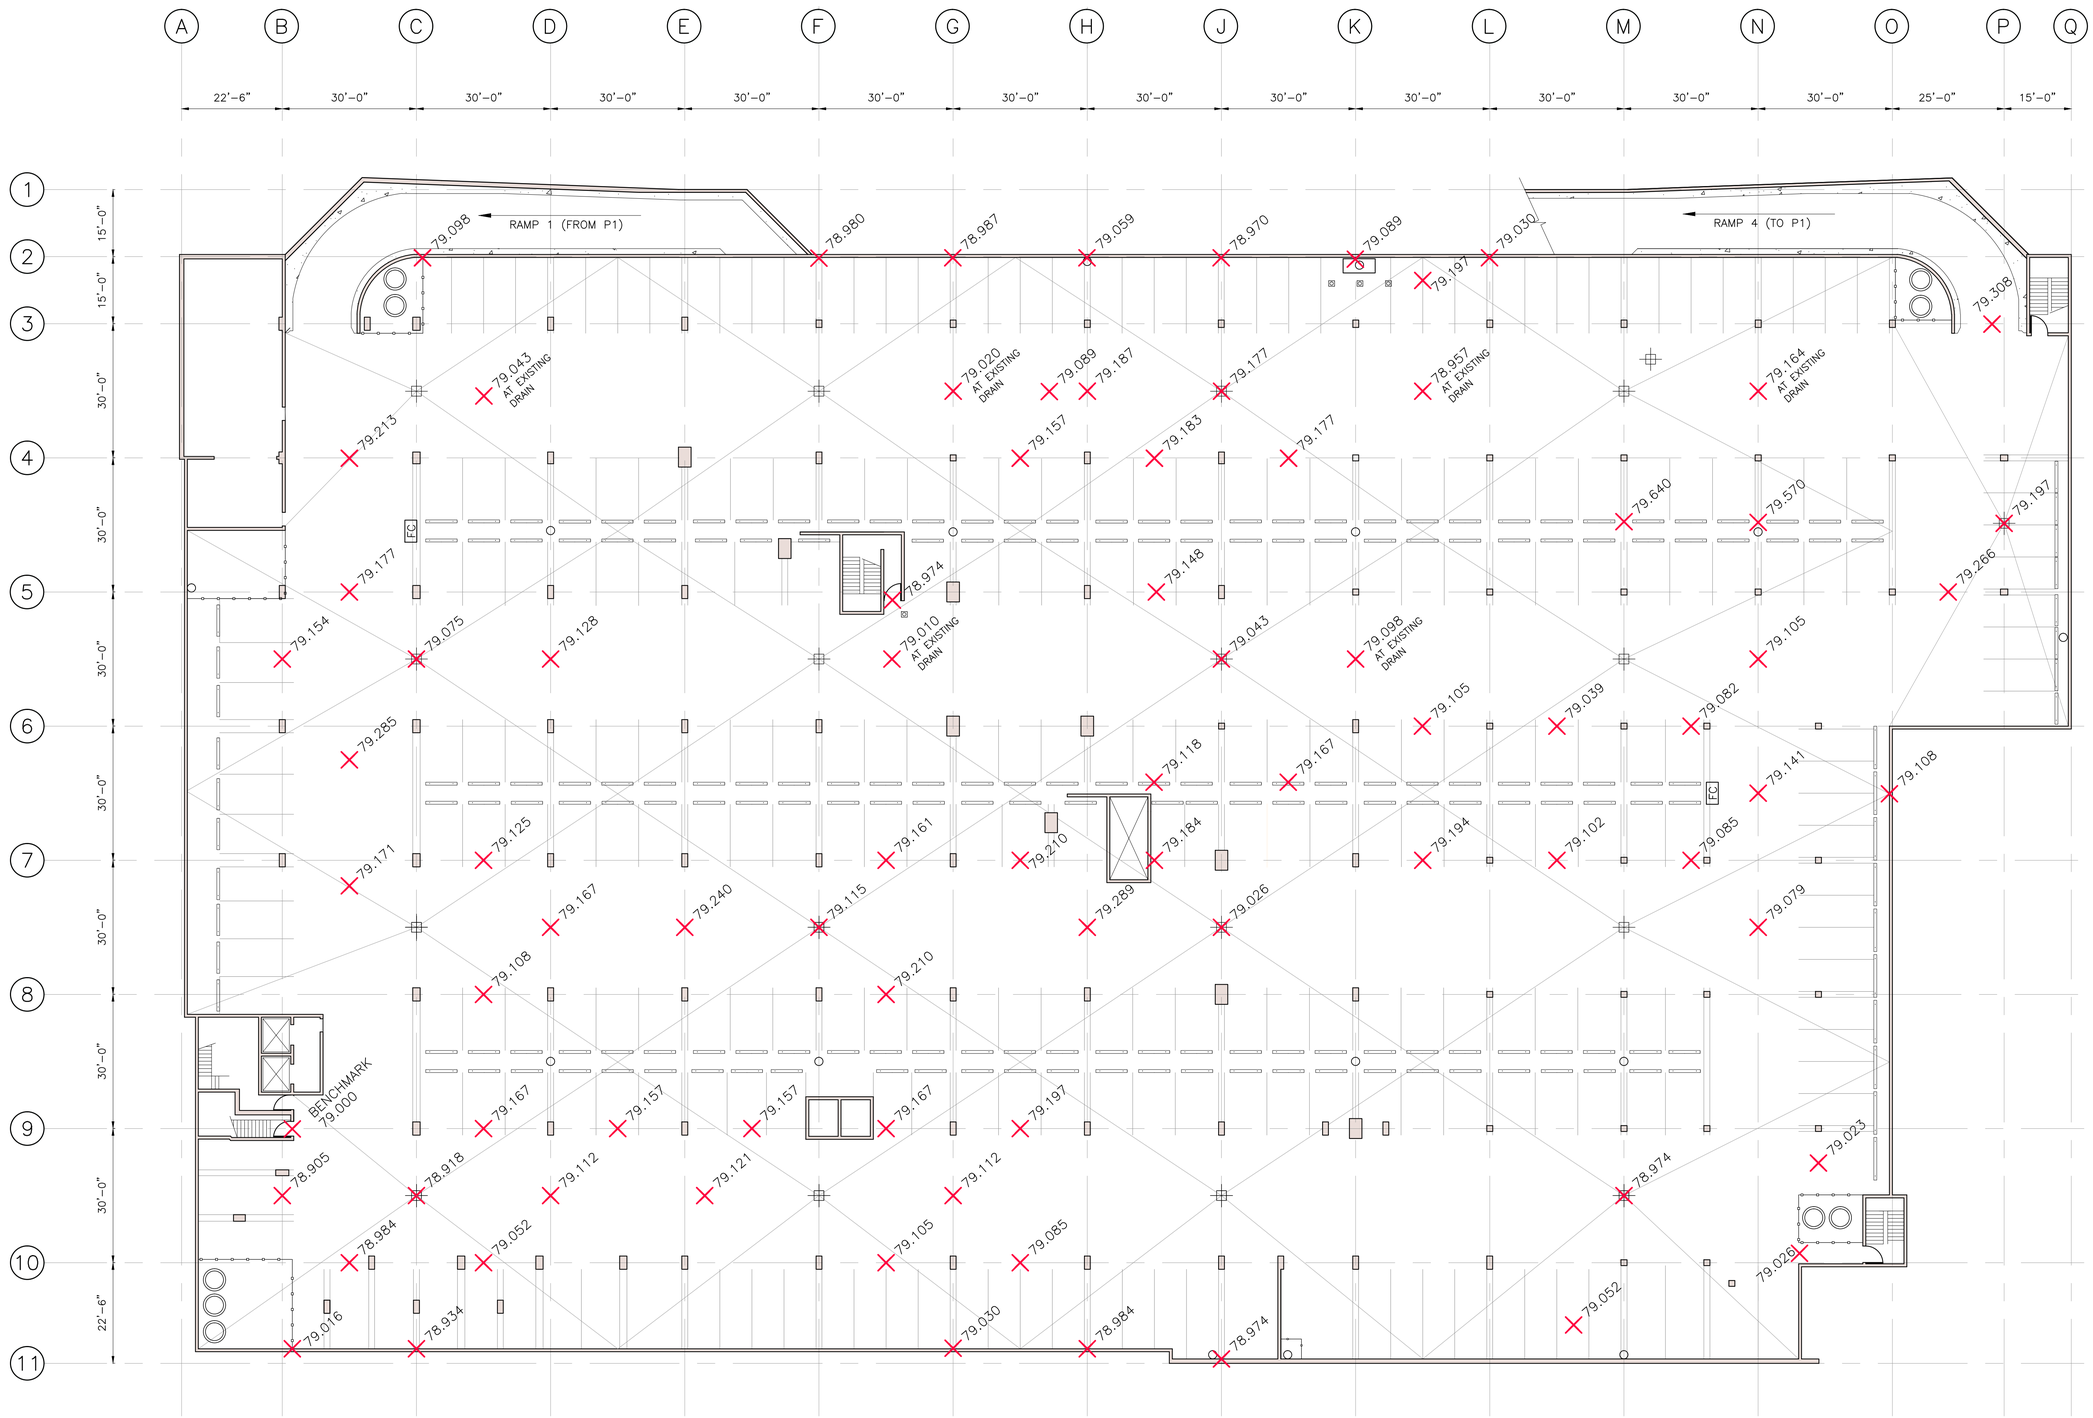

P2 LEVEL EXISTING ELEVATION PLAN

SCALE: 1/16"=1'-0"

NO.	REVISION	DATE
1	ISSUED FOR COORDINATION	JULY 3, 2012
2	ISSUED FOR 66% REVIEW	SEPT 6, 2012
3	ISSUED FOR BID	NOV 7, 2012
4	ISSUED FOR ADDENDUM # 4	DEC 5, 2012
5		
6		
7		

NOTES:

CONTRACTOR SHALL CHECK AND VERIFY ALL DIMENSIONS AND BE RESPONSIBLE FOR REPORTING ALL DISCREPANCIES TO CITY AND/OR CONTRACT ADMINISTRATOR PRIOR TO BID CLOSING

LATEST APPROVED DRAWINGS ONLY TO BE USED FOR CONSTRUCTION.

PRINTS ARE NOT TO BE SCALED.

KEY PLAN:

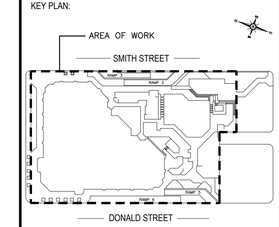

CONCENTRIC ASSOCIATES INTERNATIONAL INCORPORATED

LONDON Tel. 1-519-452-7700 Toll Free1-866-919-4531
OTTAWA Tel. 1-613-824-8900 Toll Free1-866-919-4530
IQALUIT Tel. 1-867-979-3300 Toll Free 1-866-919-4533
SASKATOON Tel. 1-306-343-5500 Toll Free 1-866-919-8899
REGINA Tel. 1-306-520-6100 Toll Free 1-866-919-1861
WINNIPEG Tel. 1-204-783-1276 Toll Free 1-866-919-4531

YOU CHALLENGE US... **TOGETHER WE SUCCEED**
www.concentriceng.com

CLIENT NAME:

CITY OF WINNIPEG

PROJECT ADDRESS:

251 DONALD STREET
WINNIPEG, MANITOBA

PROJECT NAME:

REHAB OF MILLENNIUM LIBRARY PARKADE

DRAWING TITLE:

P2 LEVEL EXISTING ELEVATION PLAN

DESIGN:	PSM	SCALE:	AS SHOWN
DRAWN:	JAW	DATE:	DEC/12
APPV'D:	PSM/ADM	FILE No:	11-4145

SHEET No.

S11