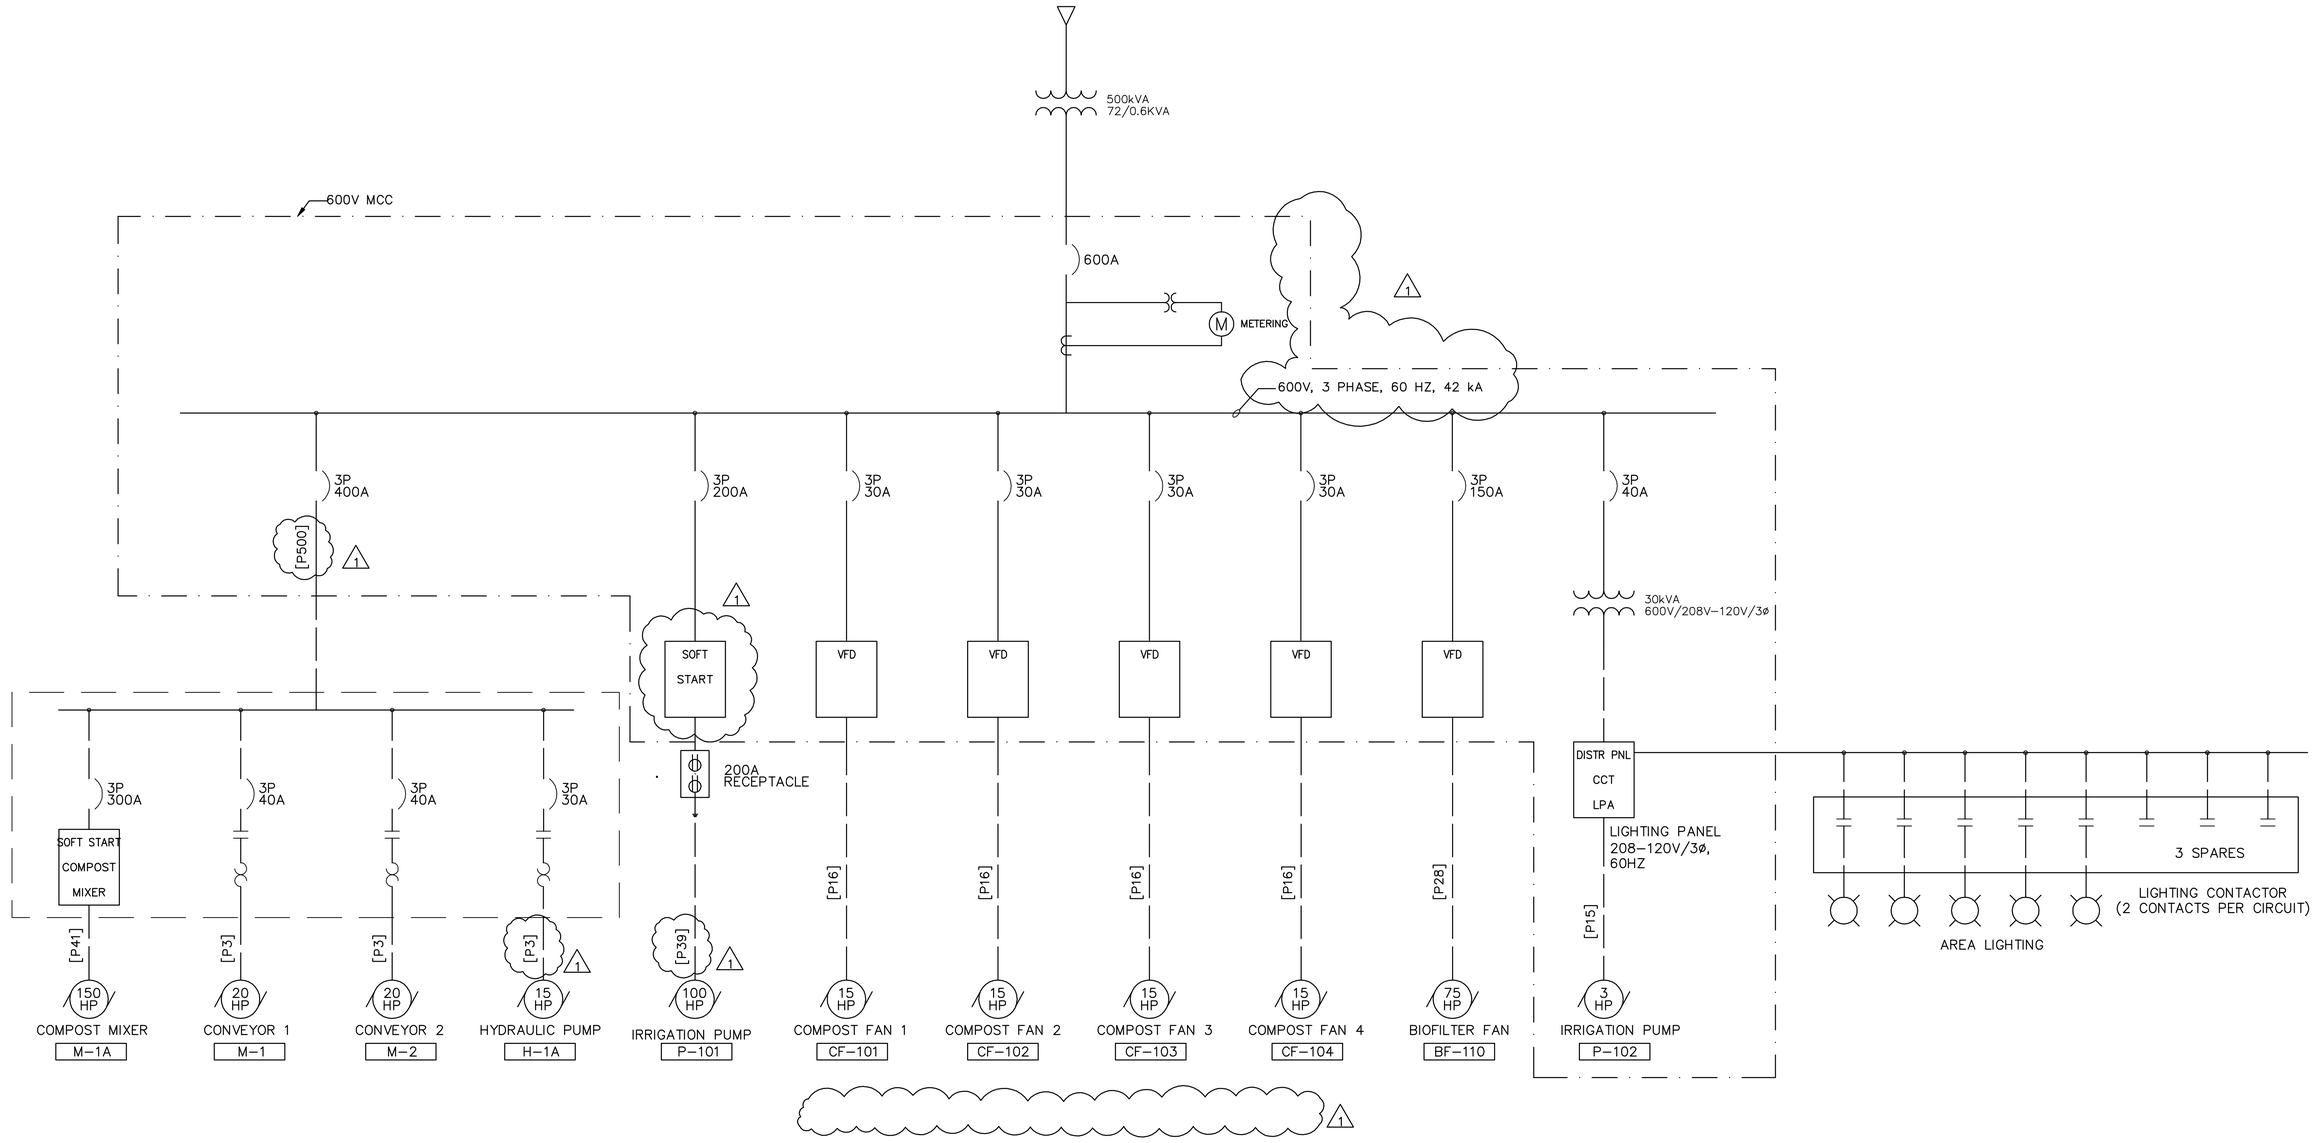

B.M.
ELEV.

CONSTRUCTION COMPLETION DATE: YYYY MM DD

NO.	REVISIONS	DATE	BY
1	ISSUED FOR ADDENDUM 2	13/02/26	JBC
0	ISSUED FOR CONSTRUCTION	13/01/25	JBC

CH2MHILL®

DESIGNED BY	LL	CHECKED BY	WT
DRAWN BY	JN	APPROVED BY	BW
SCALE: HORIZONTAL	NTS	RELEASED FOR CONSTRUCTION	
VERTICAL	NTS		
DATE	2013 01 25	DATE	

PLOT DATE: 2013 02 26

ENGINEER'S SEAL

ORIGINAL
SIGNED BY
L.D. LLEWELLYN
13/01/25

CONSULTANT DRAWING NUMBER
E–601

BID OPPORTUNITY: 839–2012

Winnipeg

THE CITY OF WINNIPEG
WATER AND WASTE DEPARTMENT
ENGINEERING DIVISION

BRADY ROAD RESOURCE MANAGEMENT FACILITY
LEAF AND YARD WASTE AND
PILOT BIOSOLIDS COMPOSTING

ELECTRICAL – M&R BUILDING
SINGLE LINE DIAGRAM

SHEET 42 OF 45

CITY DRAWING NUMBER
1–0400B–E0005–001–01

FILE PATH: C:\pw_workdir\ch2mhill_wbg\jcortez1\d0198672\
FILE NAME: E–601_438634.dwg