



**J** CONCORDIA STREET - STA. 2+130  
SCALE - H-1:100 V-1:50

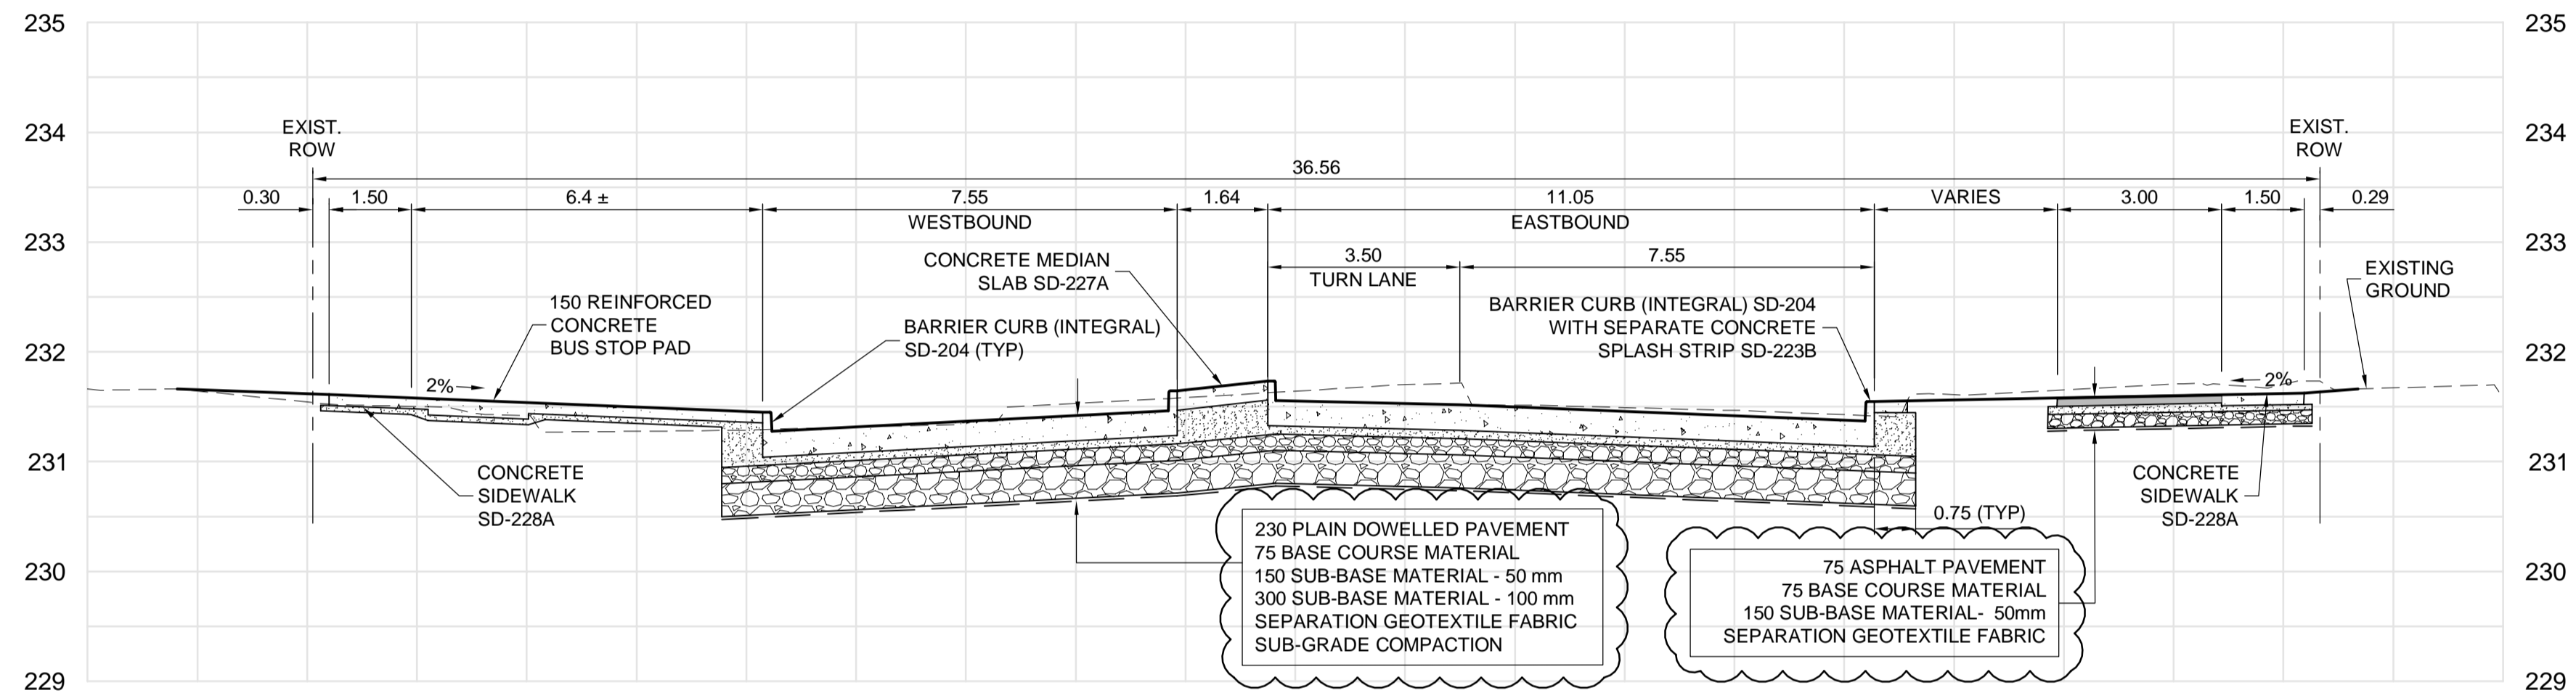

**K** CONCORDIA STREET - STA. 2+252  
SCALE - H-1:100 V-1:50

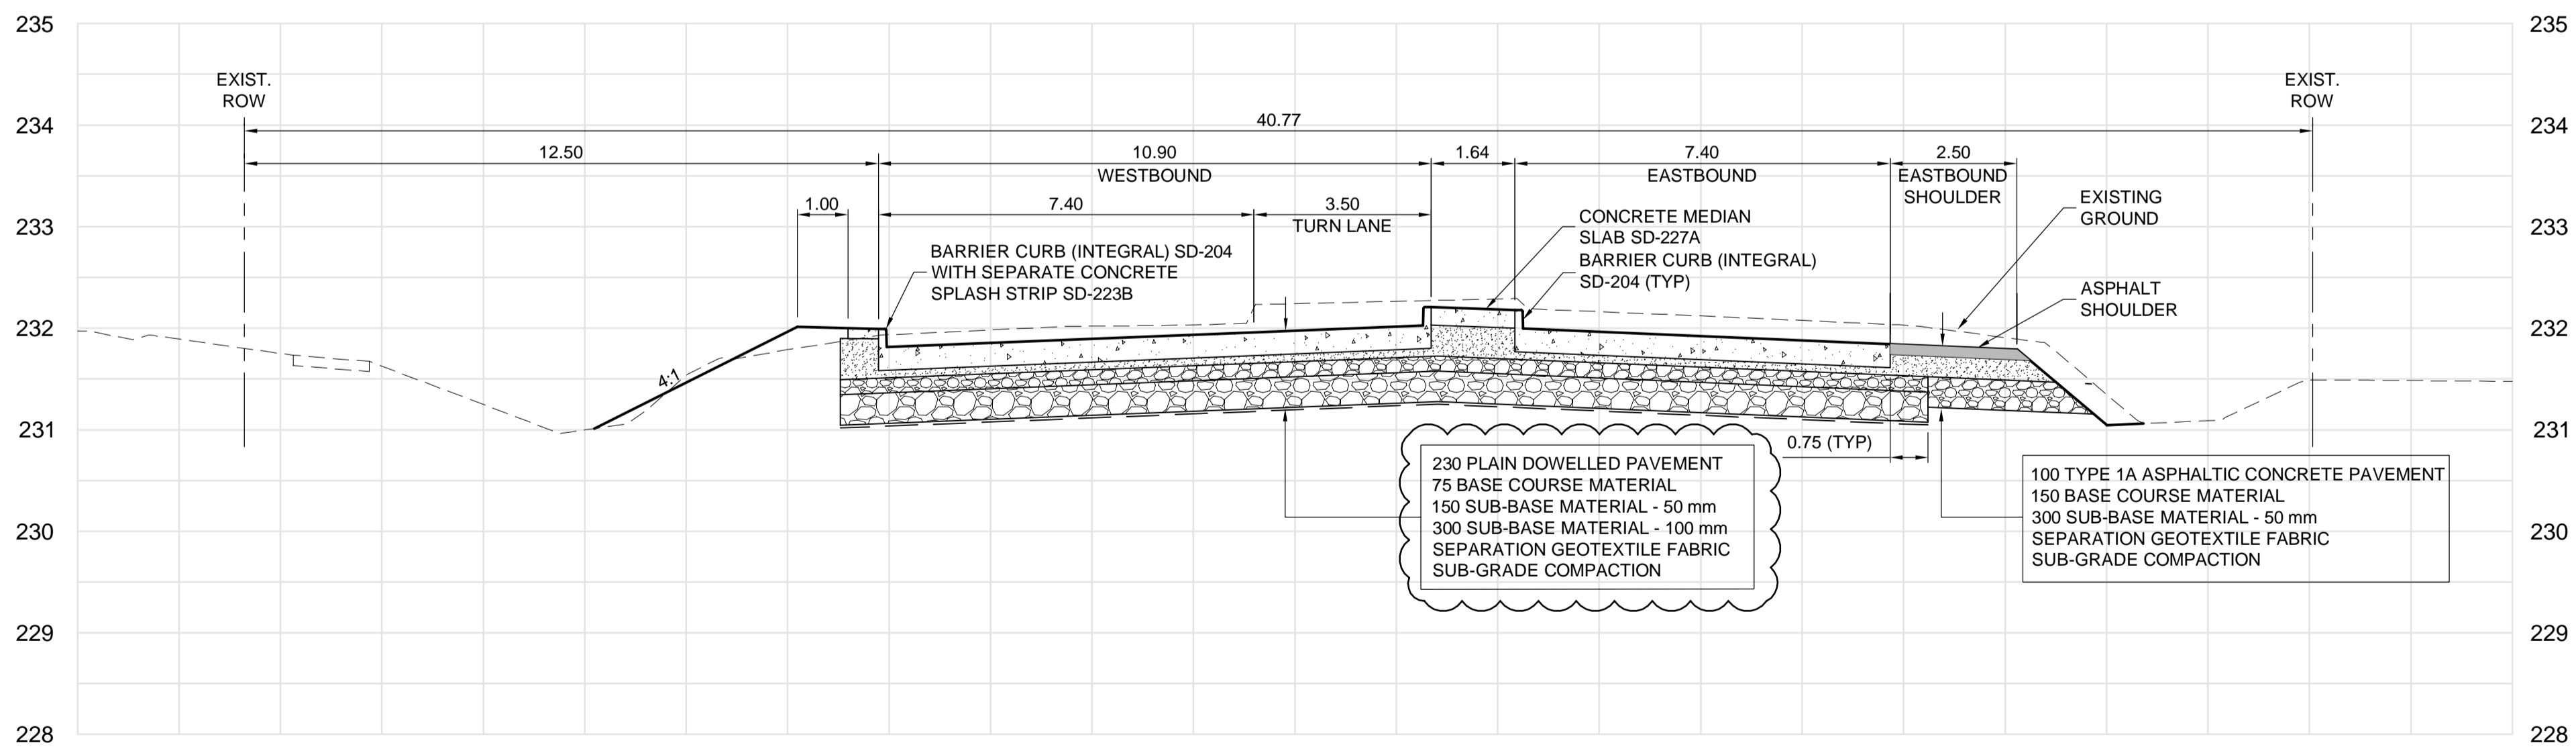

**L** CONCORDIA STREET - STA. 2+355  
SCALE - H-1:100 V-1:50

METRIC

WHOLE NUMBERS INDICATE MILLIMETRES  
DECIMALIZED NUMBERS INDICATE METRES



Certificate of Authorization  
**Dillon Consulting Limited (MB)**  
No. 1789 Date: 01/14/2014

G:\CAD\127055\02-Civil\01-Contract\20-Sections-Details.dwg

150 WM	WATERMAIN	150 WM	HYDRO	HYDRO	HYDRO	150 WM	WATERMAIN	150 WM
HYDRANT	HYDRANT	MTS	M.T.S.	CONCRETE	MTS	HYDRANT	HYDRANT	+
VALVE	VALVE	300 LDS	CONCRETE	ASPHALT	300 LDS	VALVE	VALVE	X
LAND DRAINAGE SEWER	LAND DRAINAGE SEWER	250 WWS	ASPHALT	PLANING	250 WWS	LAND DRAINAGE SEWER	LAND DRAINAGE SEWER	300 LDS
WASTE WATER SEWER	WASTE WATER SEWER	MANHOLE	PLANING	SIDEWALK	MANHOLE	WASTE WATER SEWER	WASTE WATER SEWER	250 WWS
		CATCH BASIN	SIDEWALK	PAVING STONES	CATCH BASIN			300 LDS
		CURB INLET	PAVING STONES	PARTIAL DEPTH REPAIR	CURB INLET			250 WWS
		JUNCTIONS	PARTIAL DEPTH REPAIR	PROPERTY LINE	JUNCTIONS			300 LDS
		CULVERT	PROPERTY LINE	DRAINAGE ARROW	CULVERT			250 WWS
		100 GAS	DRAINAGE ARROW	CURB RAMP	100 GAS			300 LDS
		EXISTING	CURB RAMP	LEGEND-PLAN	EXISTING			250 WWS
		PROPOSED	LEGEND-PLAN	PROPOSED	PROPOSED			300 LDS
		EXISTING	LEGEND-PROFILE	EXISTING	EXISTING			250 WWS
		PROPOSED	LEGEND-PROFILE	PROPOSED	PROPOSED			300 LDS

UNDERGROUND STRUCTURES		B.M. ELEV.
SUPPLY	U/G STRUCTURES	DATE
4	ISSUED FOR ADDENDUM NO. 3	01/14/14 JNC
3	ISSUED FOR TENDER	12/16/13 JNC
2	ISSUED FOR REVIEW	07/22/13 JNC
1	ISSUED FOR REVIEW	06/21/13 JNC
NO.	REVISIONS	DATE BY

DESIGNED BY	JMS/MRD
DRAWN BY	TJH
CHECKED BY	JNC
APPROVED BY	DPK
HOR. SCALE	
VERTICAL	
DATE	01/14/2014

RELEASED FOR CONSTRUCTION	DATE
---------------------------	------



ENGINEER'S SEAL	PROVINCE OF MANITOBA
REGISTERED PROFESSIONAL ENGINEER	JAN CRANG
	01/14/2014
CONSULTANT PROJECT NUMBER	12-7055

PANET ROAD/MOLSON STREET RECONSTRUCTION AND TWINNING	
CITY DRAWING NUMBER	P-3350-31
SHEET	31 OF 47
CONSULTANT DRAWING NUMBER	
SECTIONS (5 OF 5)	