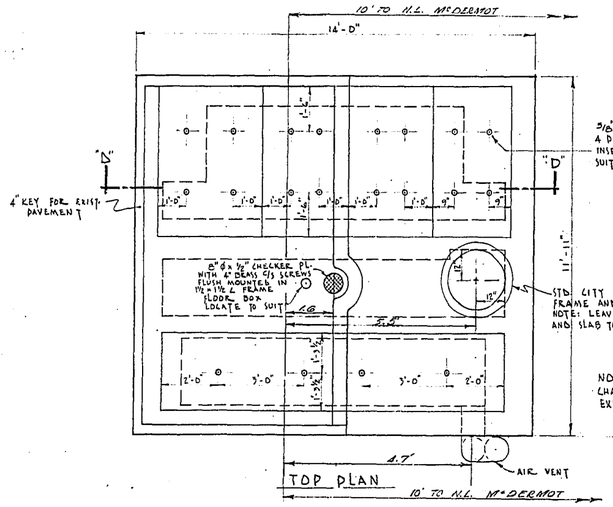

TOP PLAN

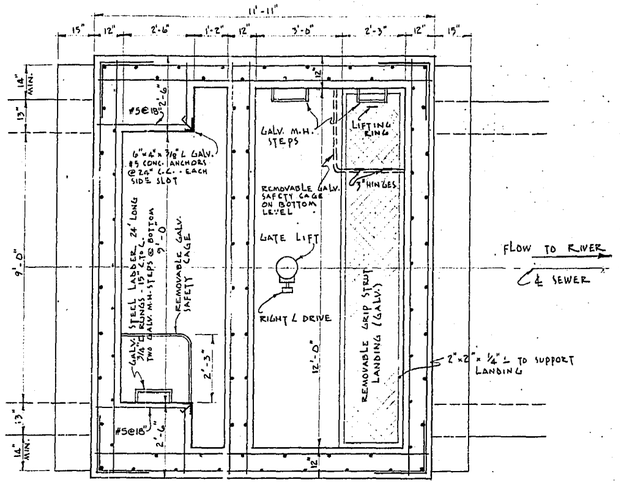

SECTION "C-C"

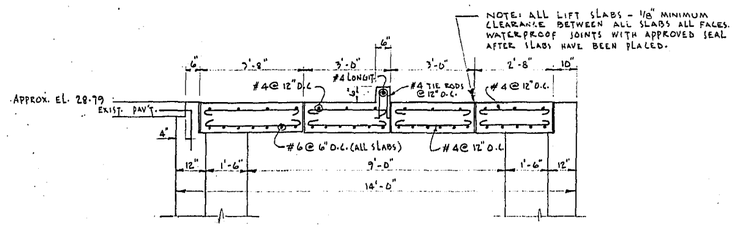

SECTION "D-D"

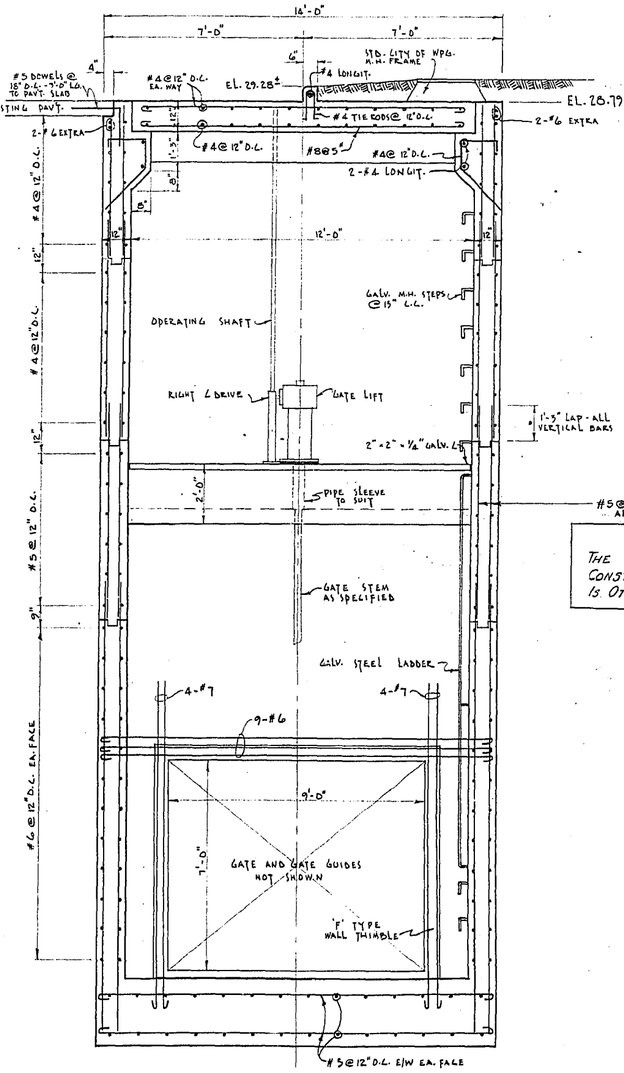

SECTION "A-A"

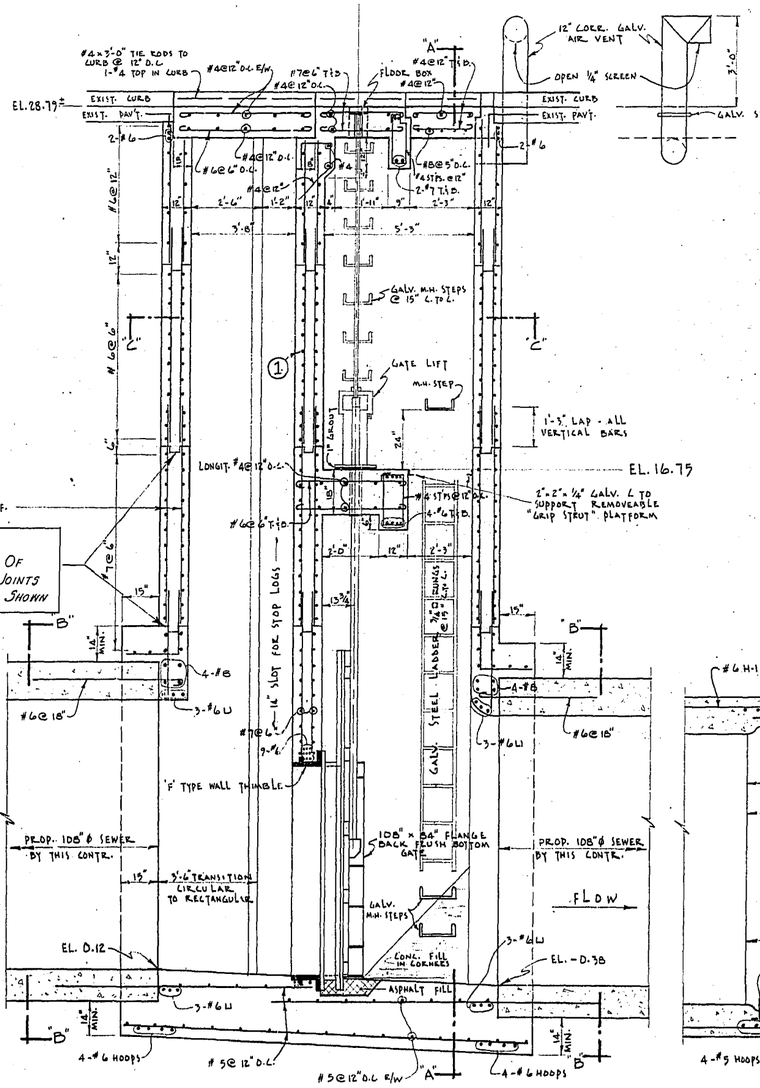

SECTIONAL ELEVATION

NOTE: LOCATION DRAWING SEE DWG. SC.15702

FILE: B-6-K
L.E.D. 15-65
P.D. 65-48

NOTE: THE LOCATION OF CONSTRUCTION JOINTS IS OTHER THAN SHOWN

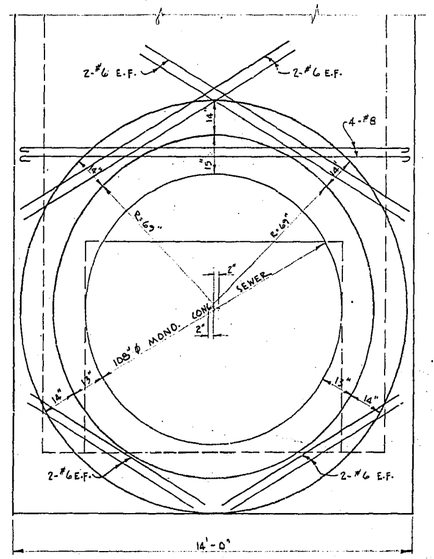

SECTION "B-B"

NOTE: ALL STEEL 2½" CLEAR

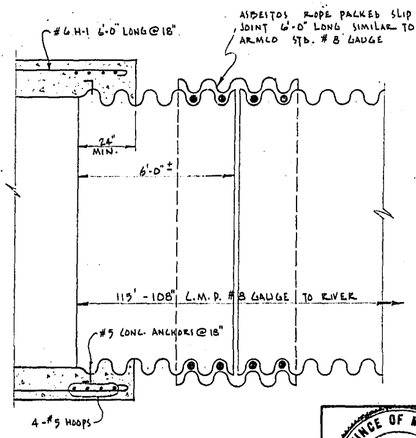

W.O.# 100-120-961

REVISED AS CONSTRUCTED
BY 2.D DATE 26/4/66
CHECKED BY W.S. DATE 26/4/66

METRO APPROVAL REC'D.
W.W. & W.D. DATE 19 MAY '65

APPROVAL FROM DYKING COMMISSIONER
BY H.L. 26 MAY 65

APPROVAL FROM RIVER AND STREAMS PROTECTION
BY H.L. 1 JUN 65

NO.	BY	DATE	REFERENCES
1	D.G.	21/5/65	STEEL ADDED TO CENTRE WALL

REVISIONS

PROVINCE OF MANITOBA — P.C. GALBRAITH — REGISTERED ENGINEER

DETAILS OF McDERMOT AVENUE GATE CHAMBER

CITY OF WINNIPEG
ENGINEERING DEPARTMENT
W. D. HURST, CITY ENGINEER
J. B. STRIOWSKI, DEPUTY CITY ENGINEER

DRAWN BY D.G. DATE MAY 10/65
TRACED BY
CHECKED BY
APPROVED BY

SCALE 3/16"=1'-0"
DRAWING NO. SC.15703