


A1 - 841694
2013-12-12
_ACOMMO_DEFAULT.CIB
P:\60273041\000-CADD\02-SHEETS\01\60273041-01-G-002.DWG



DETAIL
Scale 1:1000

- NOTES:**
1. CONTRACTOR SHALL BE REQUIRED TO MAINTAIN EXISTING CONCRETE BARRICADES AND FENCING SHOWN TO SECURE SITE TO PREVENT VEHICULAR AND PEDESTRIAN TRAFFIC FROM ACCESSING THE SITE.
 2. THE CONTRACTOR WILL ASSUME RESPONSIBILITY FOR EXISTING CONCRETE BARRIERS ONSITE UPON MOBILIZATION. THE CONTRACTOR WILL RETURN THE CONCRETE BARRIERS TO THE CITY OF WPG YARD IN ACCORDANCE WITH THE SPECIFICATIONS ONCE PLEISSIS ROAD IS OPEN TO TRAFFIC.
 3. SHOULD BARRIERS OR FENCING BE OPEN FOR ACCESS, THE CONTRACTOR SHALL SUPPLY A FLAGMAN TO CONTROL ACCESS.

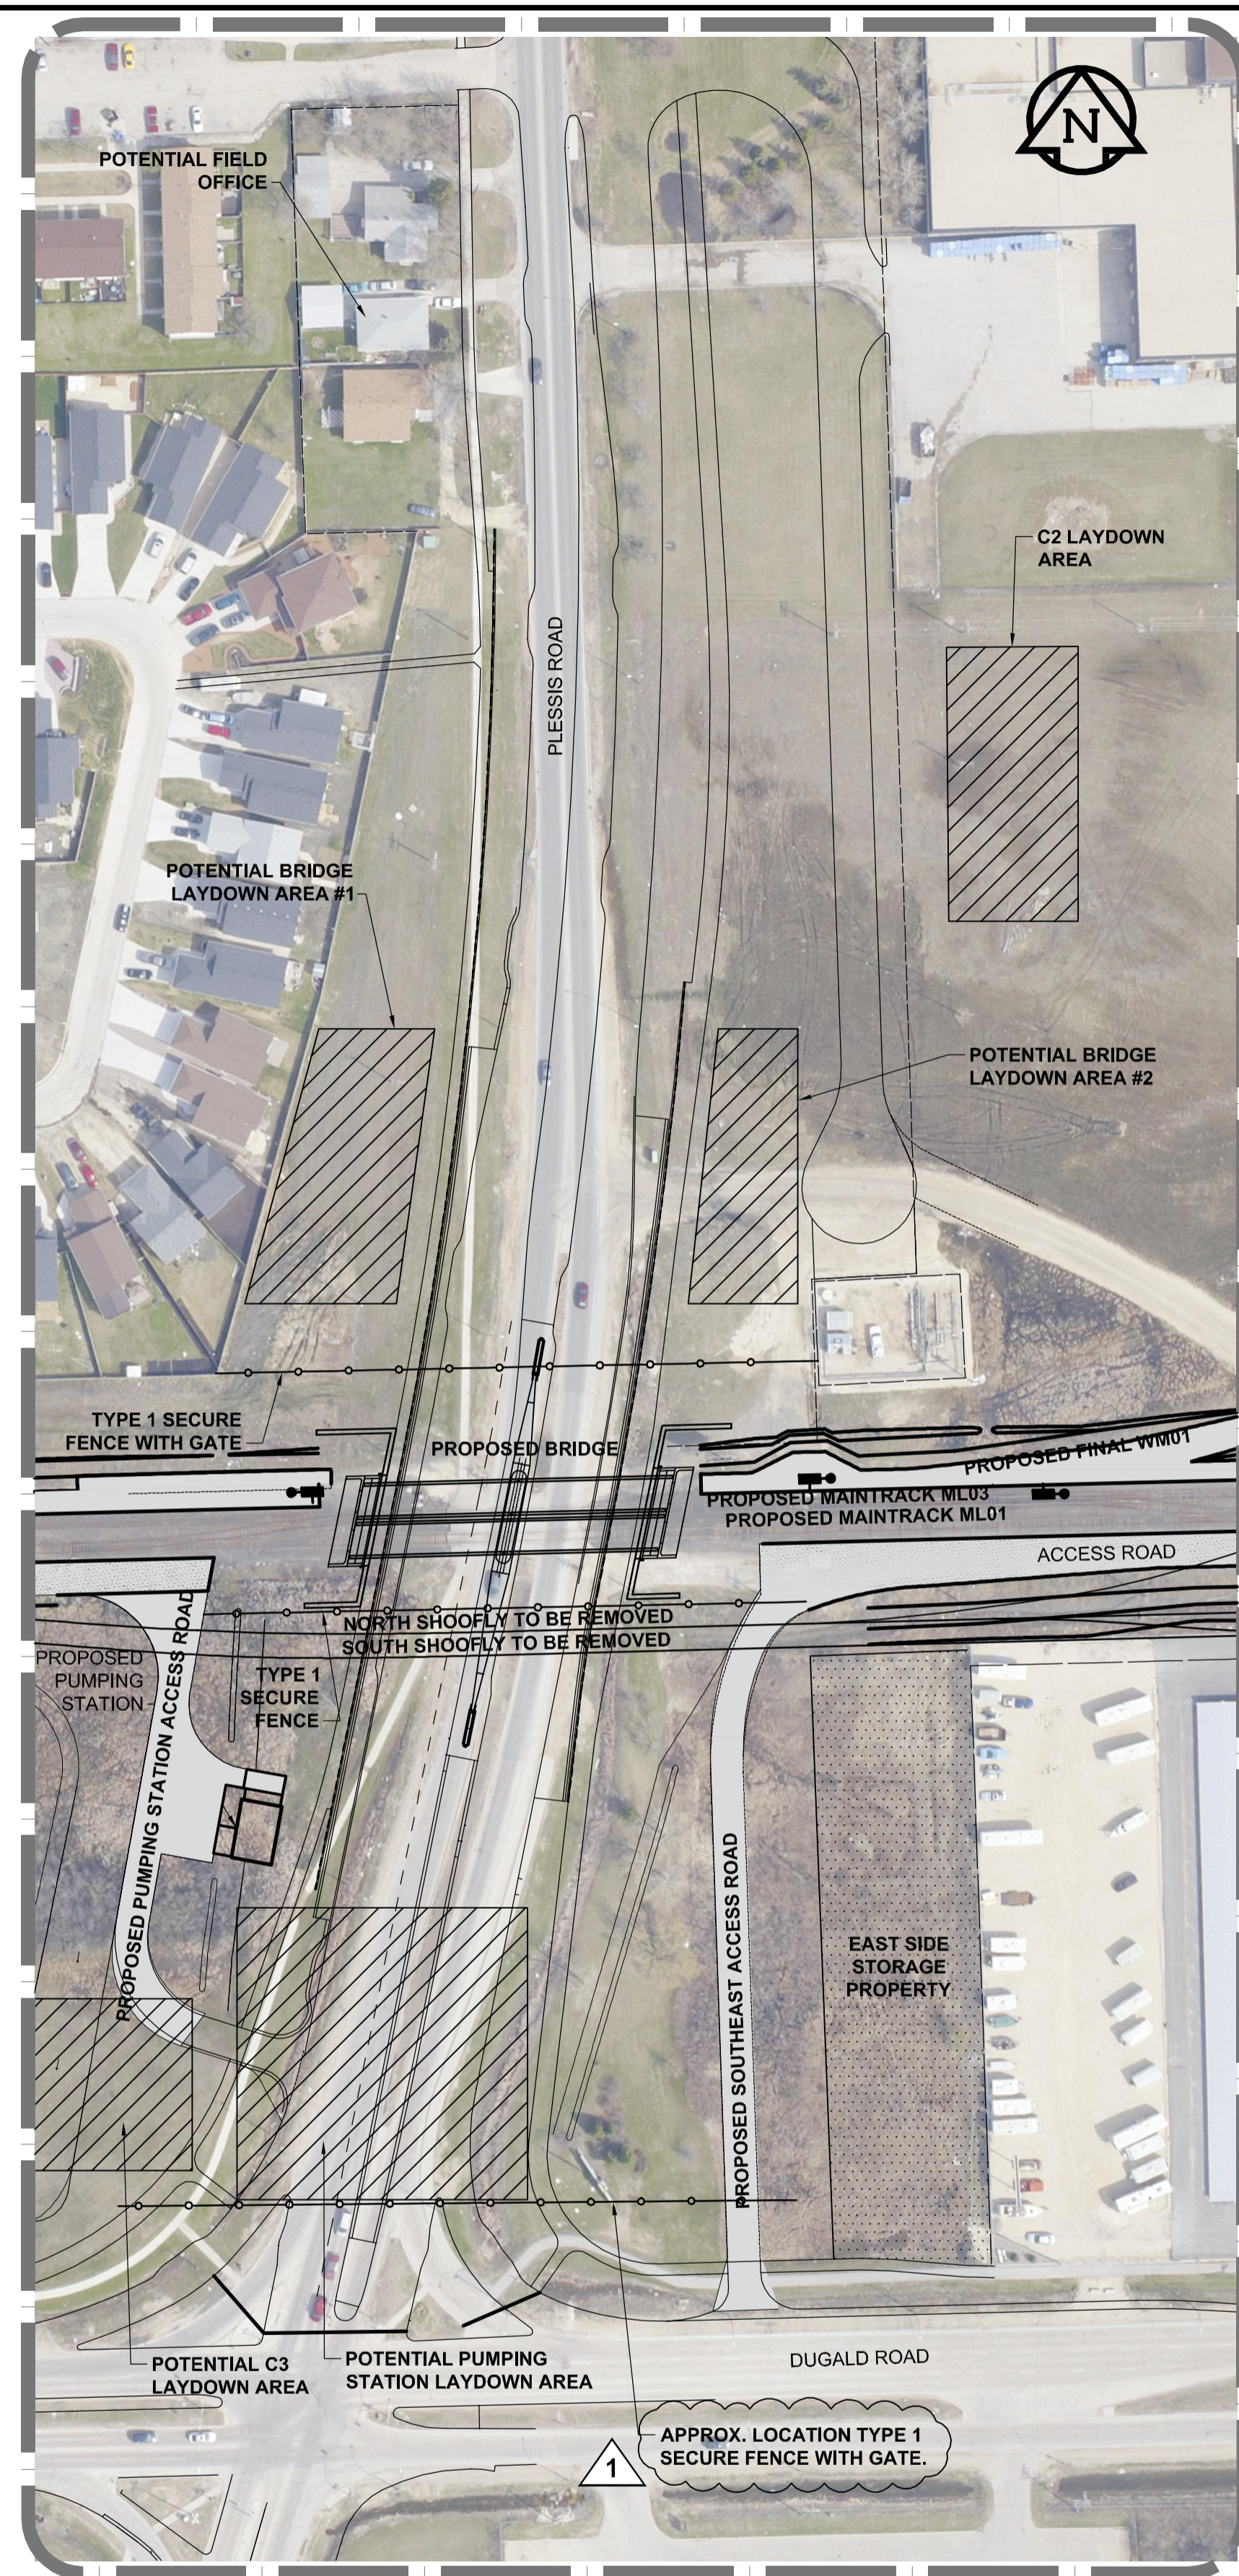

SITE PLAN
Scale 1:2000



LOCATION APPROVED UNDERGROUND STRUCTURES

NO.	REVISIONS	DATE	BY
1	ISSUED FOR ADDENDUM	2013/12/10	DJH
0	ISSUED FOR TENDER	2013/11/21	KC


NOTE:
LOCATION OF UNDERGROUND STRUCTURES AS SHOWN ARE BASED ON THE BEST INFORMATION AVAILABLE, BUT NO GUARANTEE IS GIVEN THAT ALL EXISTING UTILITIES ARE SHOWN OR THAT THE GIVEN LOCATIONS ARE EXACT. CONFIRMATION OF EXISTENCE AND EXACT LOCATION OF ALL SERVICES MUST BE OBTAINED FROM THE INDIVIDUAL UTILITIES BEFORE PROCEEDING WITH CONSTRUCTION.

B.M. ELEV.

NO.	REVISIONS	DATE	BY
1	ISSUED FOR ADDENDUM	2013/12/10	DJH
0	ISSUED FOR TENDER	2013/11/21	KC

AECOM

DESIGNED BY	TDW	CHECKED BY	BDK
DRAWN BY	DJH	APPROVED BY	EBL
HOR. SCALE:	AS NOTED	RELEASED FOR CONSTRUCTION BY:	
VERTICAL:	AS NOTED	DATE	2013-06-04

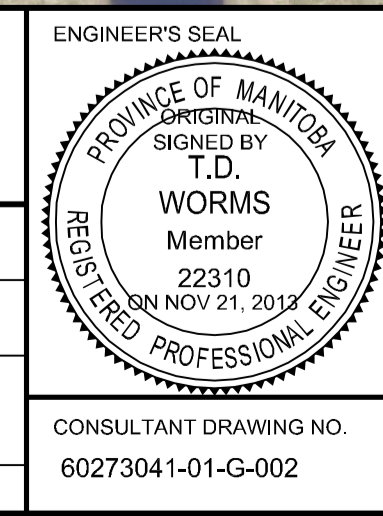

THE CITY OF WINNIPEG PUBLIC WORKS DEPARTMENT

PLEISSIS ROAD TWINNING AND GRADE SEPARATION AT CN REDDITT SUBDIVISION CONTRACT 3

CITY DRAWING NUMBER: U238-2014-1903
SHEET 03 OF 04

G-0003

BID OPPORTUNITY NO. 712-2013