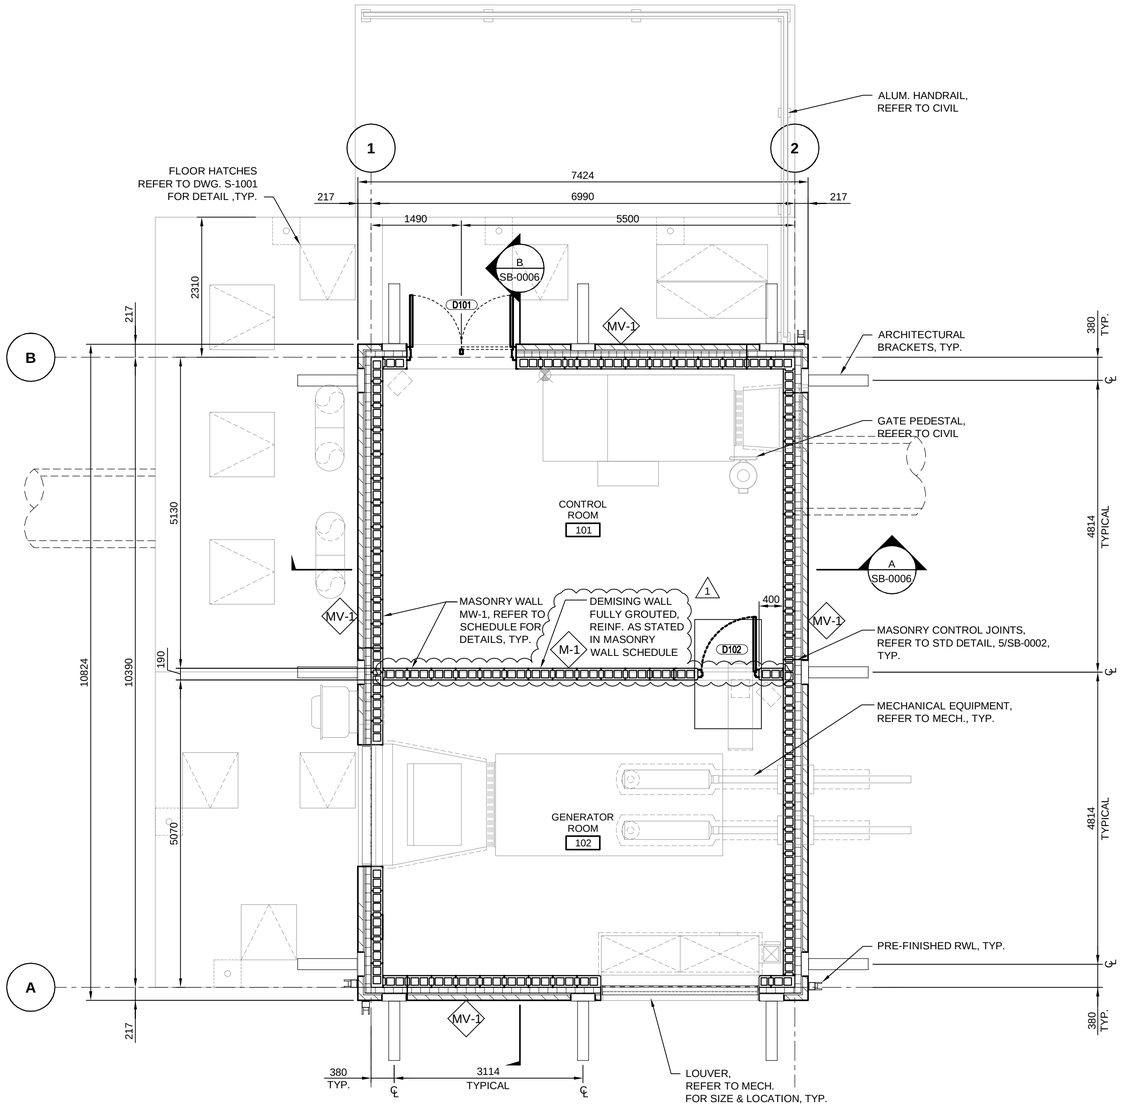

MAIN FLOOR PLAN

Scale 1:50

REFER TO ROOF FRAMING PLAN FOR LINTELS, DWG. SB-0004

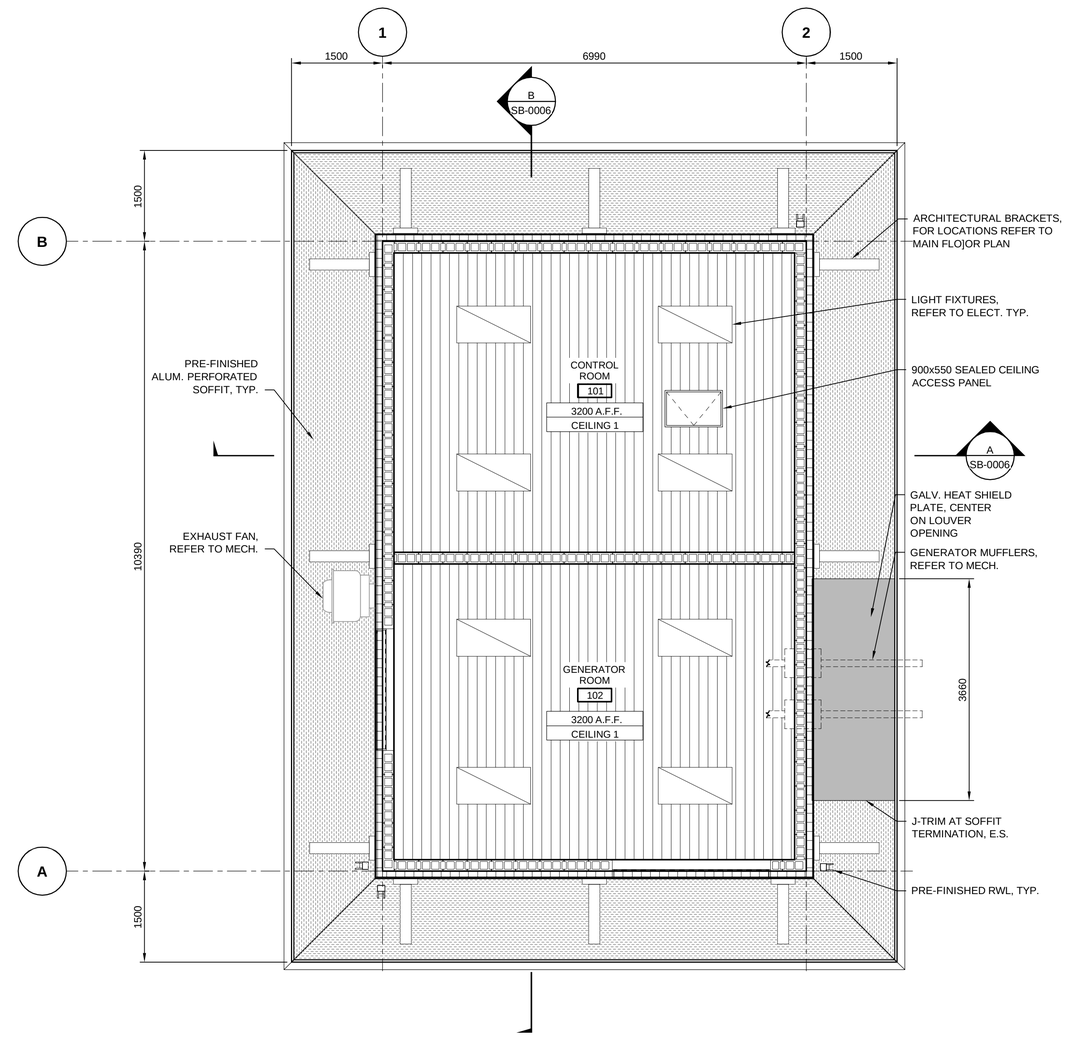

REFLECTED CEILING PLAN

Scale 1:50

WALL SCHEDULE

NO.	PLAN DETAIL	DESCRIPTION
MV-1		STONE VENEER, CMU WALL MV-1 LIMESTONE AND CONCRETE BRICK VENEER 25mm AIR SPACE 102mm RIGID INSULATION AIR/VAPOUR BARRIER 190 CMU (REFER TO DETAILS)
MP-1		METAL PANEL, CMU WALL MP-1 PRE-FINISHED METAL WALL PANEL 102mm RIGID INSULATION Z-GIRTS (HORIZ.) @ 600 o/c AIR/VAPOUR BARRIER 190 CMU (REFER TO DETAILS)
M-1		MASONRY WALL M-1 (60min. FRR) 190 CMU (REFER TO DETAILS)

CEILING SCHEDULE

MARK	FIRE RATING	ASSEMBLY	REMARKS
CEILING-1		PRE-FINISHED METAL LINER PANEL 20mm PLYWOOD	FASTEN LINER PANEL SO THAT CORRUGATIONS ARE PERPENDICULAR TO TRUSS SPAN

APEGM
Certificate of Authorization
AECOM Canada Ltd.
No. 4671 Date:_____

BID OPPORTUNITY NO. 712-2013

LOCATION APPROVED
UNDERGROUND STRUCTURES

SUPV. U/G STRUCTURES COMMITTEE — DATE

NOTE:
LOCATION OF UNDERGROUND STRUCTURES AS SHOWN ARE BASED ON THE BEST INFORMATION AVAILABLE. BUT NO GUARANTEE IS GIVEN THAT ALL EXISTING UTILITIES ARE SHOWN OR THAT THE GIVEN LOCATIONS ARE EXACT. CONFIRMATION OF EXISTENCE AND EXACT LOCATION OF ALL SERVICES MUST BE OBTAINED FROM THE INDIVIDUAL UTILITIES BEFORE PROCEEDING WITH CONSTRUCTION.

B.M.
ELEV.

NO.	REVISIONS	DATE	BY
1	ISSUED FOR ADDENDUM	14/01/13	KK
0	ISSUED FOR TENDER	13/10/15	KK

AECOM

DESIGNED BY	KK	CHECKED BY	
DRAWN BY	KK	APPROVED BY	
HOR. SCALE:	AS NOTED	RELEASED FOR CONSTRUCTION BY:	
VERTICAL:	AS NOTED		
DATE	2013-07-12	DATE	

ENGINEER'S SEAL

CONSULTANT DRAWING NO.
SB-2323 PLANS.DWG

Winnipeg
THE CITY OF WINNIPEG
PUBLIC WORKS DEPARTMENT

PLESSIS ROAD TWINNING AND GRADE SEPARATION AT CN REDDITT SUBDIVISION
CONTRACT 3

CITY DRAWING NUMBER U238-2014-2323
SHEET 03 OF 08

STRUCTURAL SUPERSTRUCTURE
MAIN FLOOR AND REFLECTED CEILING PLAN

SB-0003 1

A1 – 841x594
2013-04-03
AECOM REVIEW DRFT CHK
C:\DOCUMENTS AND SETTINGS\STEPHUKS\APPLICATION DATA\AUTODESK\C3D 2012\ENU\PLOTTERS\PLOT STYLES\1055C-H-B&C.CTB
P:\60273041\000-CADD\02-SHEETS\SB\SB-2323 PLANS.DWG