




AL - 844694
R010-10-11
AECOM REVIEW DRAFT CHK

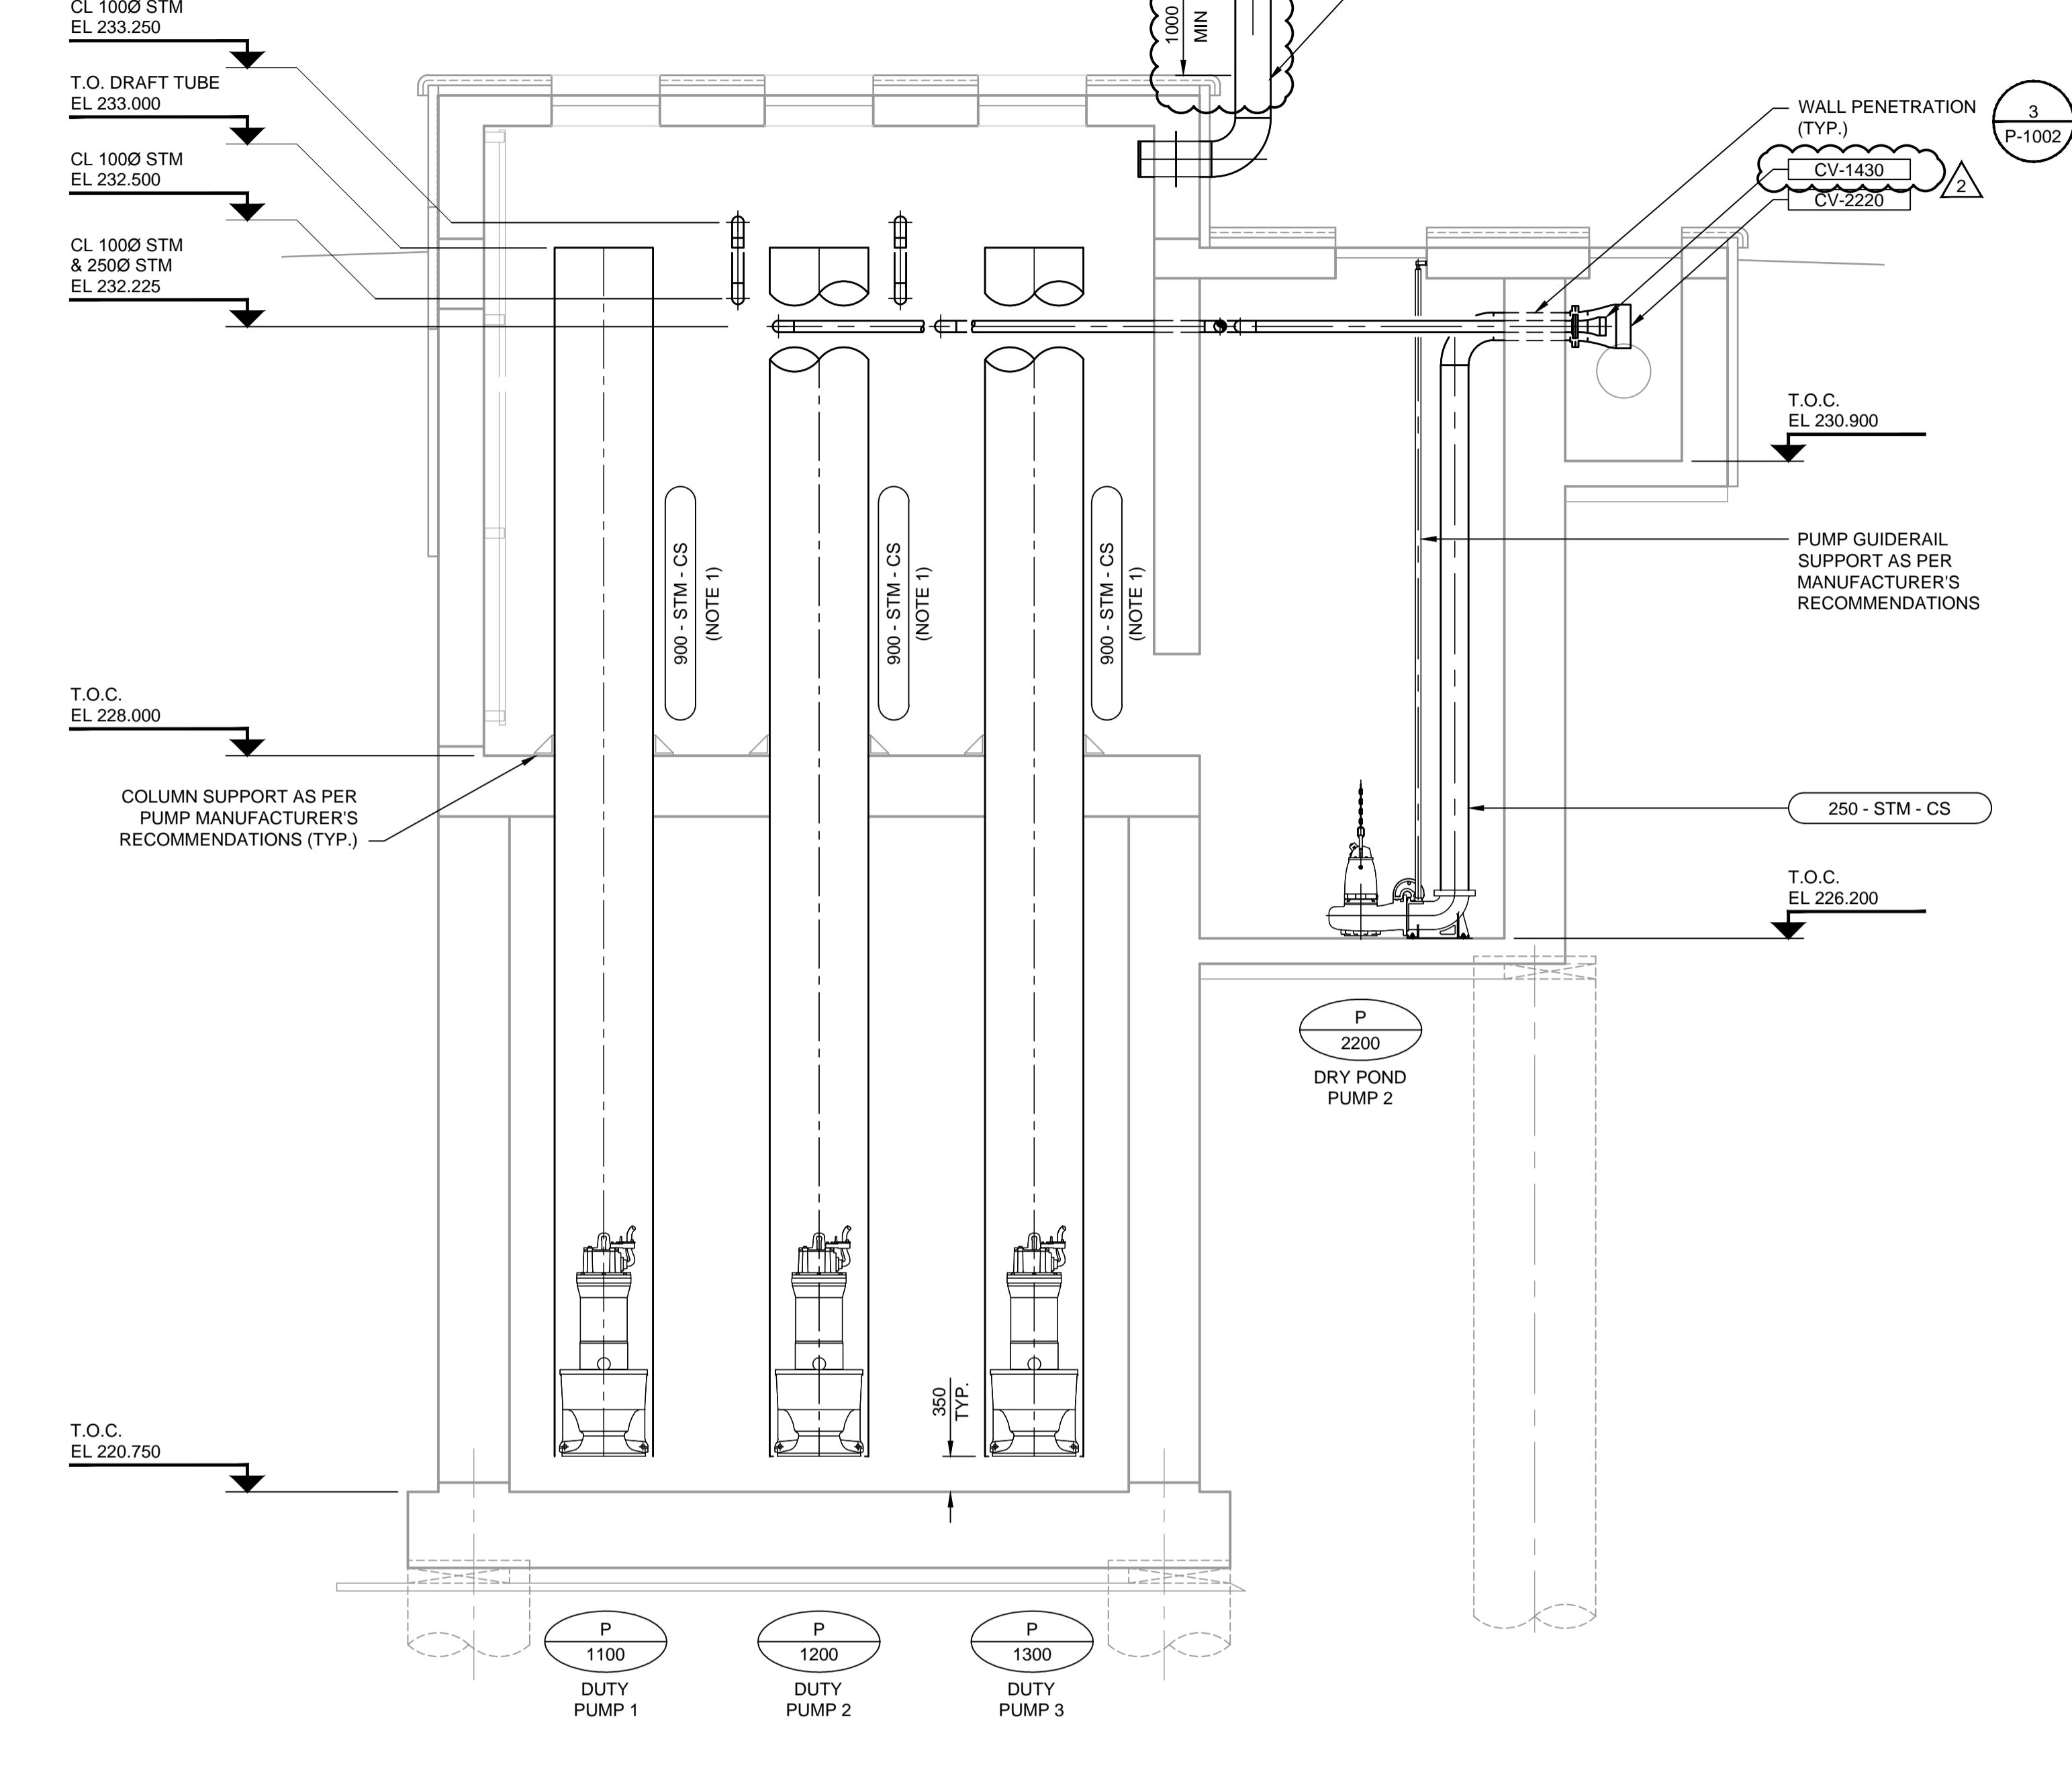

A SECTION
P-1003

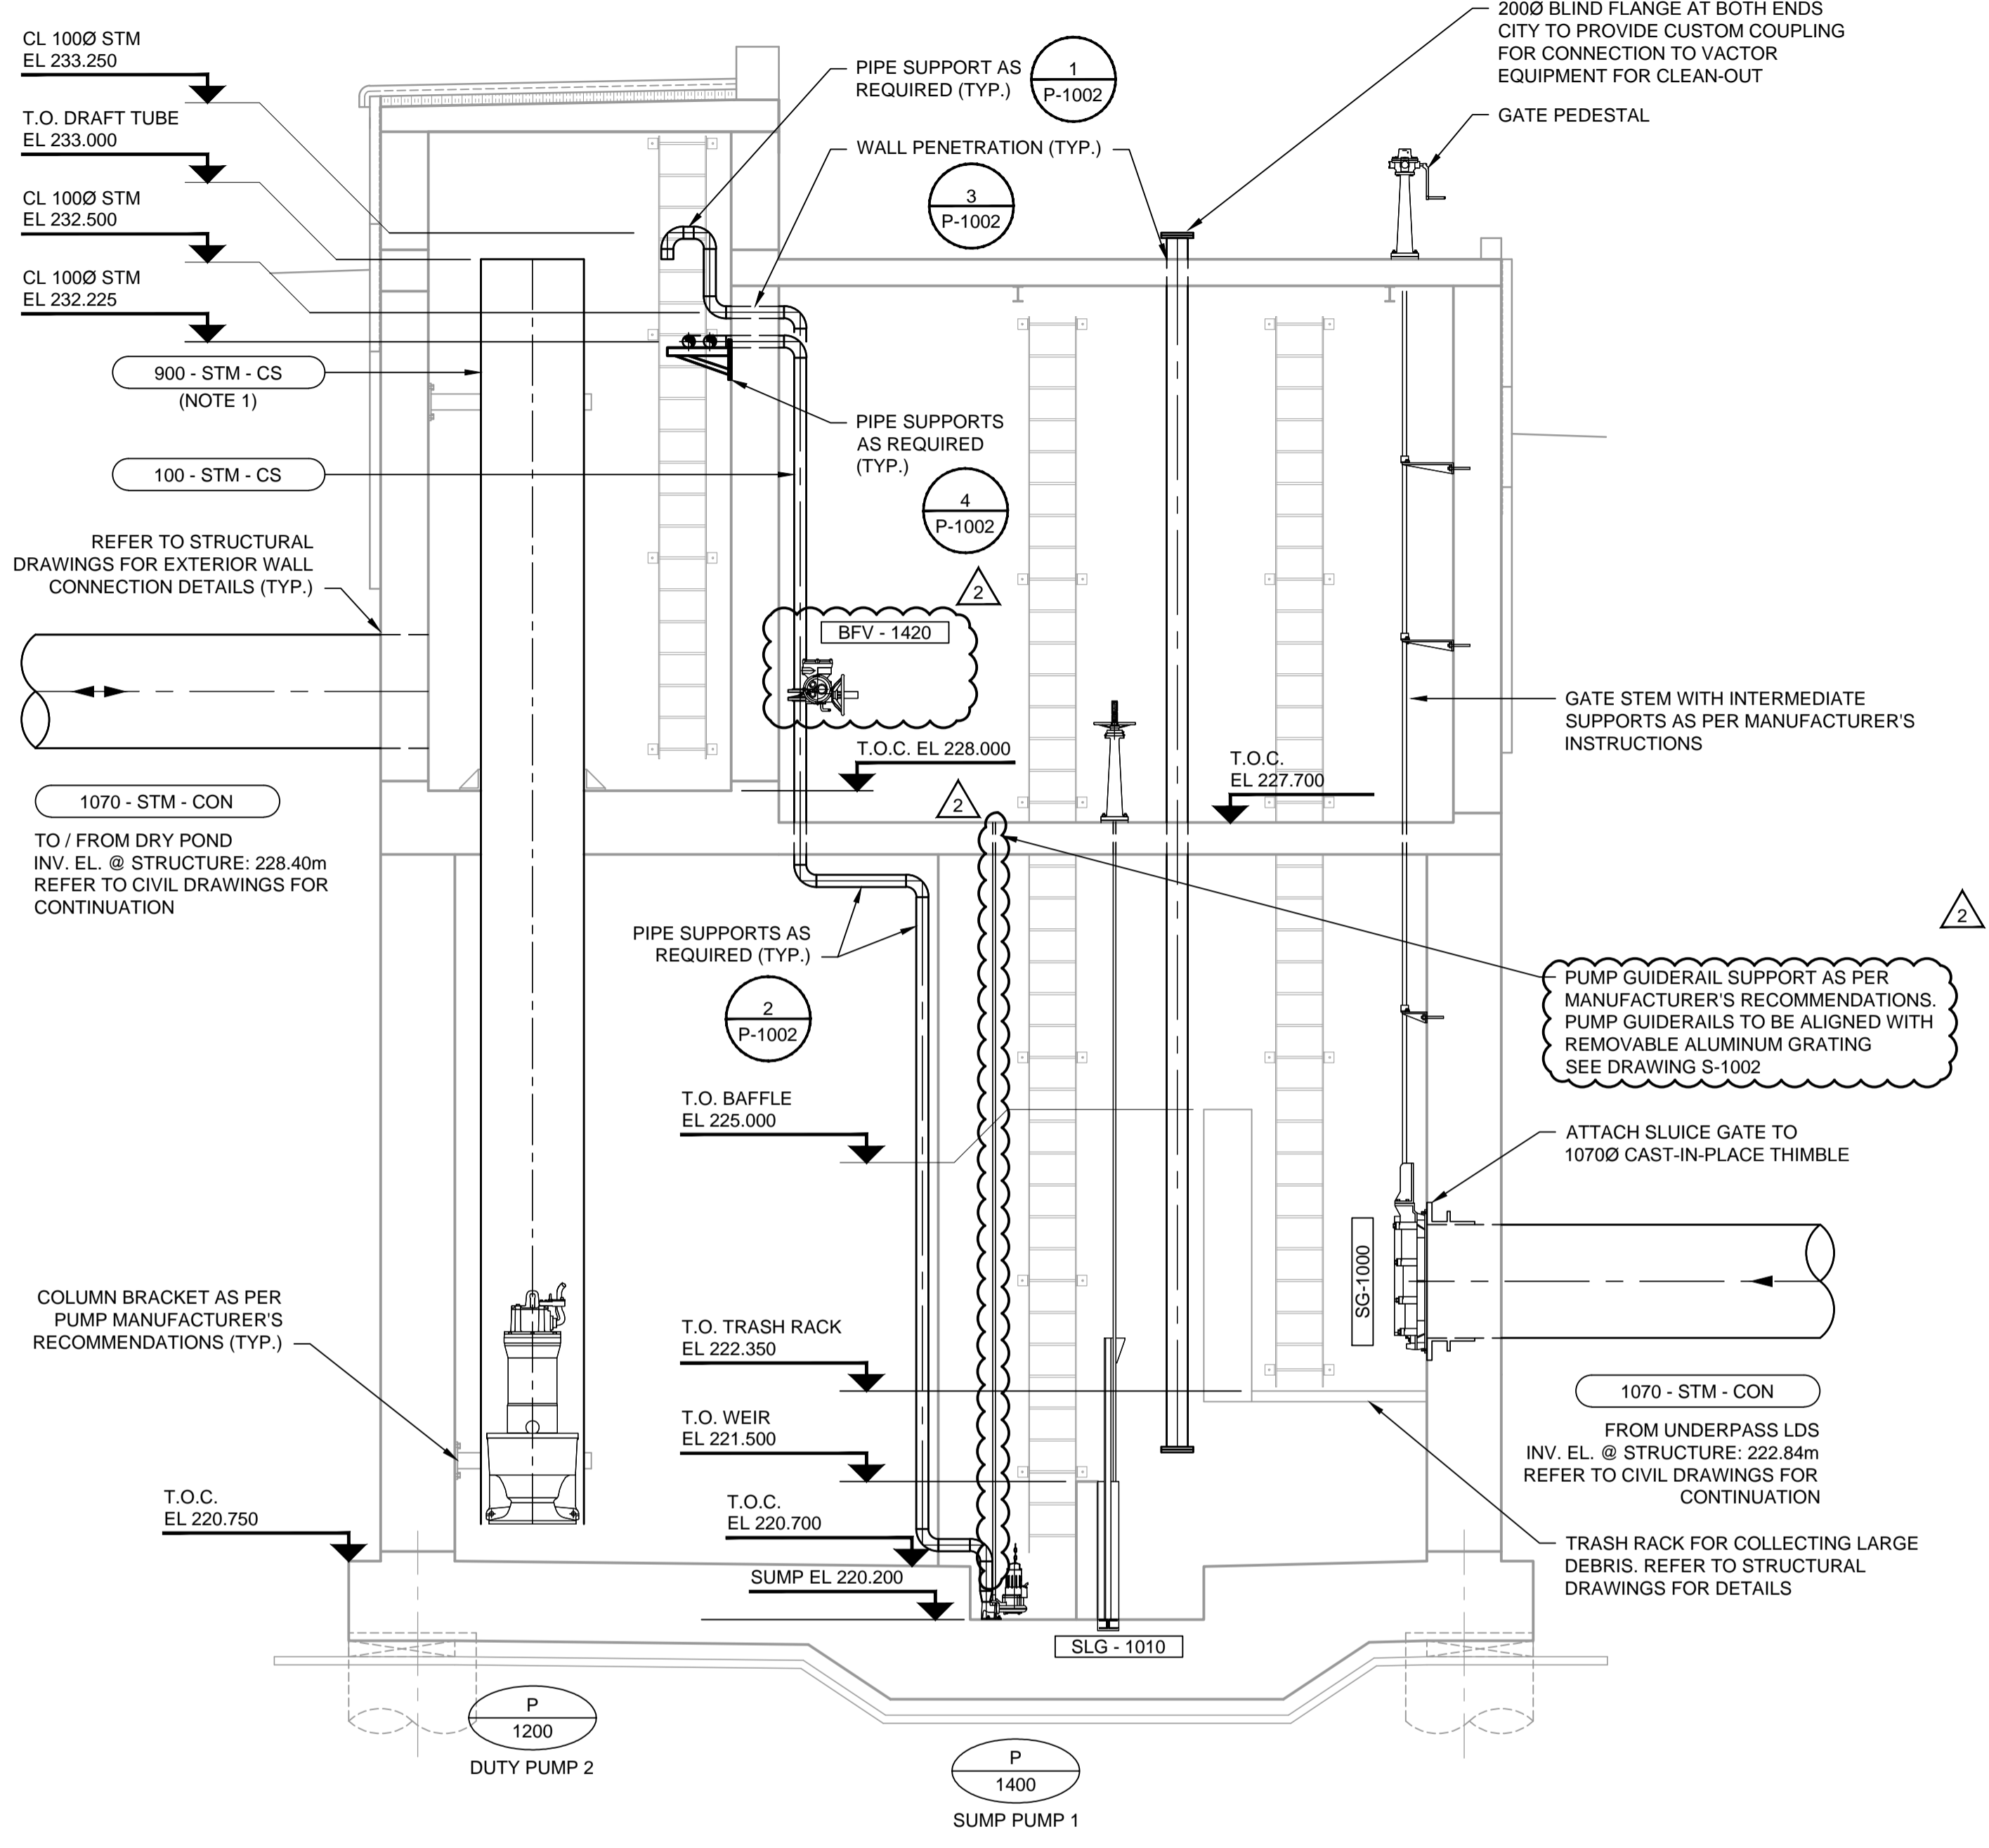

B SECTION
P-1003

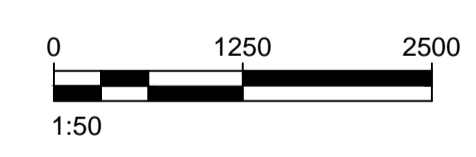

NOTE:
1. DRAFT TUBE DIAMETER MAY DIFFER DEPENDING ON PUMP MODEL. COORDINATE FLOOR PENETRATION DETAILS WITH PUMP SUPPLIER PRIOR TO COMMENCING WORK.

LOCATION APPROVED UNDERGROUND STRUCTURES	
SUPV. U/G STRUCTURES COMMITTEE	DATE
NOTE: LOCATION OF UNDERGROUND STRUCTURES AS SHOWN ARE BASED ON THE BEST INFORMATION AVAILABLE, BUT NO GUARANTEE IS GIVEN THAT ALL EXISTING UTILITIES ARE SHOWN OR THAT THE GIVEN LOCATIONS ARE EXACT. CONFIRMATION OF EXISTENCE AND EXACT LOCATION OF ALL SERVICES MUST BE OBTAINED FROM THE INDIVIDUAL UTILITIES BEFORE PROCEEDING WITH CONSTRUCTION.	

NO.	REVISIONS	DATE	BY
2	ISSUED FOR ADDENDUM	14/01/14	WJd
1	ISSUED FOR ADDENDUM	13/12/10	WJd
0	ISSUED FOR TENDER	13/10/15	SRG

DESIGNED BY	CL	CHECKED BY	
DRAWN BY	SRG	APPROVED BY	
HOR. SCALE:	AS NOTED	RELEASED FOR CONSTRUCTION BY:	
VERTICAL:	AS NOTED	DATE	

APECM
Certificate of Authorization
AECOM Canada Ltd.
No. 4671 Date: _____

ENGINEER'S SEAL
CONSULTANT DRAWING NO.
60273041-SHT-01-Con3-P-1004

**THE CITY OF WINNIPEG
PUBLIC WORKS DEPARTMENT**

**PLESSIS ROAD TWINNING AND GRADE SEPARATION AT CN REDDITT SUBDIVISION
CONTRACT 3**

CITY DRAWING NUMBER
U238-2014-2374
SHEET 4 OF 5

**PUMPING STATION
PROCESS MECHANICAL
SECTIONS**

P-1004