
			PAI	NEL	'R'			
CCT NO	DESCRIPTION	LOAD	TRIP AMPS	<u>N</u> ABC	TRIP AMPS	LOAD	DESCRIPTION	CC.
01	SPACE			•	15		STRANTROL ENG. OFFICE CHLORINE PUMP RECEPT	. 3
02	SPACE				20		?	32
03	SPACE			[15		DHW CIRC. PUMP	33
04	SPACE			lack	2P			34
05	SPACE				15		POOL DECK RECEPT. GFI	35
06	SPACE] 	15		?	36
07	SPACE				30		P-3	37
80	SPACE				3P			38
09	SPACE			$ \ \ $	4			39
10	ELEVATOR ROOM LIGHTS		15		15		H2O CIRC. PUMP	40
11	ELEVATOR PIT LIGHTS		15		⋣ 2P			4
12	ELEVATOR ROOM FAN		15	[15		S-W POOL DECK RECEPT. GFI	42
13	CAB LIGHTS		15		15		WASHER RECEPT. WEST DIVING AREA GFI	43
14	SUMP PUMP RECEPT.		15		IJ 2P			44
15	ELEVATOR ROOM RECEPT.		15	¹	15		POOL DECK WEST S-W RECEPT. GFI	45
16	TRANE CONTROLS		15		15		3RD FLOOR OFFICE RECEPT.	46
17	TRANE CONTROLS		15		15		POOL DECK S-W RECEPT. GFI	47
18	TRANE CONTROLS		15	 	15		DAY CARE A.C.	48
19	JOHNSON CONTROLS		15		15		FF-1 CO2 STORAGE ROOM	49
20	SPACE						SPACE	50
21	SPACE			1 •			SPACE	5
22	SPACE						SPACE	52
23	SPACE						SPACE	53
24	SPACE			† 			SPACE	54
25	SPACE						SPACE	55
26	SPACE						SPACE	56
27	SPACE			† 			SPACE	57
28	SPACE						SPACE	58
29	SPACE			† 			SPACE	59
30	SPACE			 			SPACE	60
	LTAGE: 120/208V	PHASE: 3	•	ı		E: 4	BREAKER I.C.: 18 kA	}
MA	IN BREAKER: N/A	MAINS: 225	δA		FEE	DER: 4	# 3/0 AWG TECK	
МО	UNTING: SURFACE	LOCATION:	EXISTIN	IG E	LECTRIC	AL RO	OM <u>/1</u>	7
FEI	D FROM: PANEL 'Y'							
NΩ	TES: -							
.40	_							
	_							
	_							

CCT NO			PAI	NEL	' P'			
	DESCRIPTION	LOAD	TRIP AMPS	N	TRIP AMPS	LOAD	DESCRIPTION	CC
01	PERIMETER LIGHTS		15	•	15		F/A SOLENOID VALVE	3
02	PERIMETER LIGHTS		15	1 •	15		GAS DETECTION	3.
03	PERIMETER LIGHTS		15	1 •	15		GAS DETECTION	3.
04	PERIMETER LIGHTS		15]	15		GAS DETECTION	3.
05	PERIMETER LIGHTS		15] •	15		SPARE	3
06	PERIMETER LIGHTS		15] •	15		SPARE	3
07	PERIMETER LIGHTS		15] 🛉	15		SPARE	3
80	PERIMETER LIGHTS		15] •	15		SPARE	3
09	PODIUM LIGHTING		15] •			SPACE	3
10	PODIUM LIGHTING		15] 🛉			SPACE	4
11	PODIUM LIGHTING		15] •			SPACE	4
12	PODIUM LIGHTING		15] •			SPACE	4.
13	LEFT PODIUM LIGHTING		15] 🛉			SPACE	4.
14	RIGHT PODIUM LIGHTING		15] •			SPACE	4
15	RIGHT PODIUM LIGHTING		15] •			SPACE	4
16	N-E ENTRANCE #8 PODIUM LTG.		15] 🛉			SPACE	4
17	SOUTH WALKWAY TO PARKING		15] •			SPACE	4
18	SOUTH WALKWAY TO PARKING		15] •			SPACE	4
19	SPACE] 🛉			SPACE	4
20	SPACE] •			SPACE	5
21	SPACE] •			SPACE	5
22	SPACE] 🛉			SPACE	5.
23	SPACE] •			SPACE	5
24	SPACE] •			SPACE	5.
25	SPACE] 🛉			SPACE	5
26	SPACE						SPACE	5
27	SPACE] •			SPACE	5
28	SPACE] 🛉			SPACE	5
29	SPACE] •			SPACE	5
30	SPACE						SPACE	6
28 29 30	SPACE SPACE SPACE	SE: 3				E: 4	SPACE SPACE	k

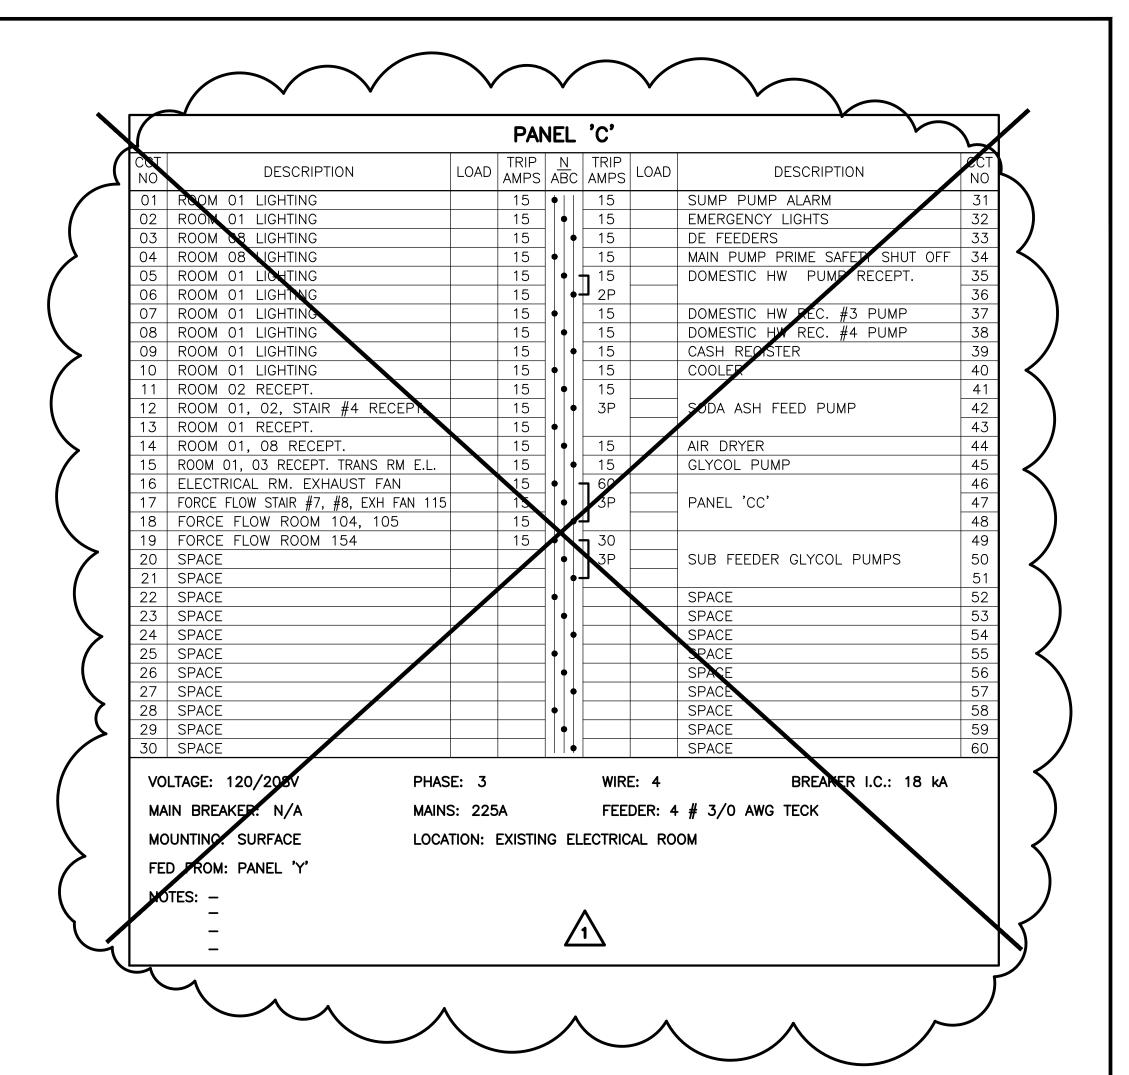

PANEL '208-A'									
CCT NO	DESCRIPTION	TRIP AMPS	AE		TRIP AMPS	DESCRIPTION	CCT NO		
01	MAIN FLR. ELECT. RM. LIGHTING	15	•		15	MAIN FLR. ELECT. RM. CRAWLSPACE RECEPT.	25		
02	MAIN FLR. ELECT. RM. RECEPT.	15] •	•	15	MOTORIZED DAMPERS	26		
03	MAIN FLR. ELECT. RM. CRAWLSPACE LTG.	15		•			27		
04	MAIN FLR. ELECT. RM. CRAWLSPACE RECEPT.	15	•		15	UNIT HEATER UH-1	28		
05	MAIN FLR. ELECT. RM. SUMP PUMP	15	•	•	3P		29		
06	ELECT. RM. EXHAUST FAN EF-1	15		•	15	CHLORINE RM HEATER FF-1	20		
07	MAIN FLR. ELECT. RM. SUPPLY FAN	15	$\rfloor ullet \mid$		15	ELECTRICAL ROOM EXHAUST FAN	31		
08	ELECT. RM. EXHAUST FAN EF-2	15 15		!	15	F.F. #7, #8 CHLR. EXH. FAN	32		
09	D.E. FEEDERS	15		¥	15	F.F. RM.104, RM.105	33		
10	FORCE FLOW RM. 154	15	$\rfloor igl $			SPACE	34		
11	AIR DRYER	15	∫ ∣ ∳	•		SPACE	35		
12	GLYCOL PUMP	15		•		SPACE	36		
13	DOMESTIC H.W. RECIRC PUMP #3	15	$\rfloor ullet \mid$			SPACE	37		
14	DOMESTIC H.W. RECIRC PUMP #4	15] •	•		SPACE	38		
15	SPACE			•		SPACE	39		
16	SPACE] 🛉			SPACE	40		
17	SPACE] •	•		SPACE	41		
18	SPACE			•		SPACE	42		
19	SPACE] 🛉			SPACE	43		
20	SPACE] •	•		SPACE	44		
21	SPACE			•		SPACE	45		
22		15 r	++			SPACE	46		
23	SODA ASH FEEDER PUMP	3P	•	•		SPACE	47		
24		L	<u> </u>	•		SPACE	48		
	LTAGE: 120/208V PHASE: 3 IN BREAKER: N/A MAINS: 225	5A				E: 4 BREAKER I.C.: 18 kA DER: 4 # 3 AWG TECK			
	·	NIEW E	1 -	\ T r		"			
MO	OUNTING: SURFACE LOCATION:	INEW E	בב() I F	RICAL F	KOOM			
FE	D FROM: PANEL 'X'								
NO	TES: -					^			
"0						/1\			
	_								
	_						1		
\		• •			A A	A A A A A A A	كرير		
		∼	へ	_			_		


CCT NO	DESCRIPTION		TRIP AMPS	<u>N</u> ABC	TRIP AMPS	DESCRIPTION	CC
01	EXIST.		15	•	15	EXIST.	16
02	EXIST.		15] • .	15	EXIST.	17
03	EXIST.		15	」 │	15	EXIST.	18
04	EXIST.		15	」 ♦	15	EXIST.	19
05	EXIST.		15	<u> </u>	15	EXIST.	20
06	EXIST.		15	 	15	EXIST.	2
07	EXIST.		15	•	15	EXIST.	22
80	EXIST.		15	$\frac{1}{2} \left[\frac{1}{2} \right]$	15	EXIST.	23
09	EXIST.		15	$\frac{1}{2}$	15	EXIST.	24
10	EXIST.		15	$\frac{1}{2}$	15	AIR COMP. FOR FIRE PROTECTION SYSTEM	2
11 12	EXIST.		15	$+ \uparrow \downarrow $		SPACE	26
13	EXIST.		15 15	$\left \frac{1}{4} \right $		SPACE SPACE	28
14	EXIST.		15	$+$ \top \downarrow $ $		SPACE	29
15	EXIST.		15	$+ \uparrow \downarrow $		SPACE	30
	LTAGE: 120/208V IN BREAKER: N/A	PHASE: 3				E: 4 BREAKER I.C.: — DER: EXIST.	
MOUNTING: SURFACE LOCATION: FED FROM:							
NO	TES: -						

Conditions of Use

Verify elevations and/or dimensions on drawing prior to use. Report any discrepancies to Dillon Consulting Limited.

Do not scale dimensions from drawing.

Do not modify drawing, re-use it, or use it for purposes other than those intended at the time of its preparation without prior written permission from Dillon Consulting Limited.

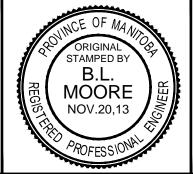





				DESIGN	REVIEWED BY	
				DRAWN	CHECKED BY	
				DATE		
				FEB. 1	2, 2013	
1	ISSUED FOR ADDENDUM No.1	13-12-10	SCK			
0	ISSUED FOR BID OPPORTUNITY NUMBER 850-2013	13-11-20	SCK	SCALE N.		
No.	ISSUED FOR	DATE	BY		1.0.	

ELECTRICAL

PAN AM POOL ELECTRICAL UPGRADE

PANEL SCHEDULES 1 OF 4

E421

137300