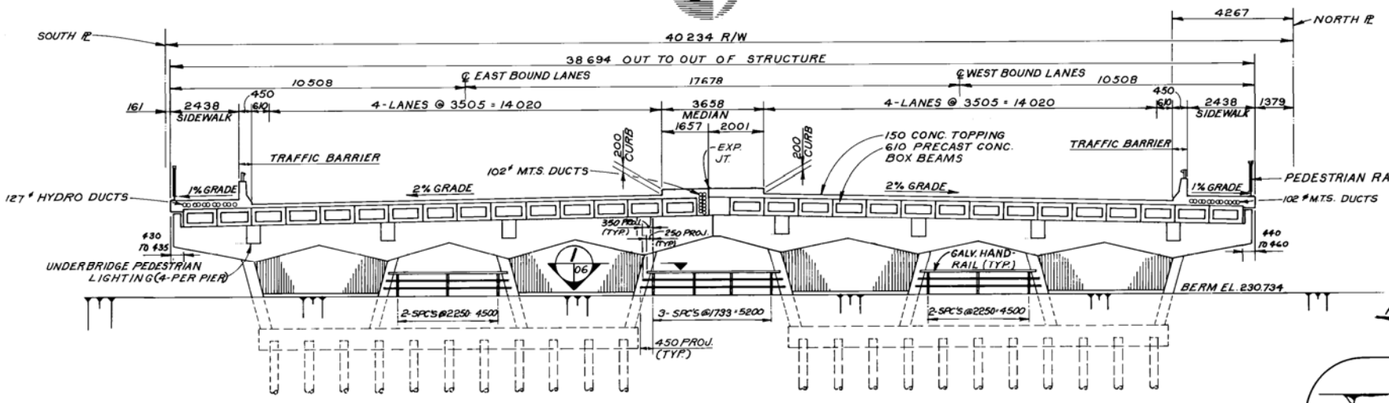

SECTION
PEDESTRIAN WALKWAY SIDE

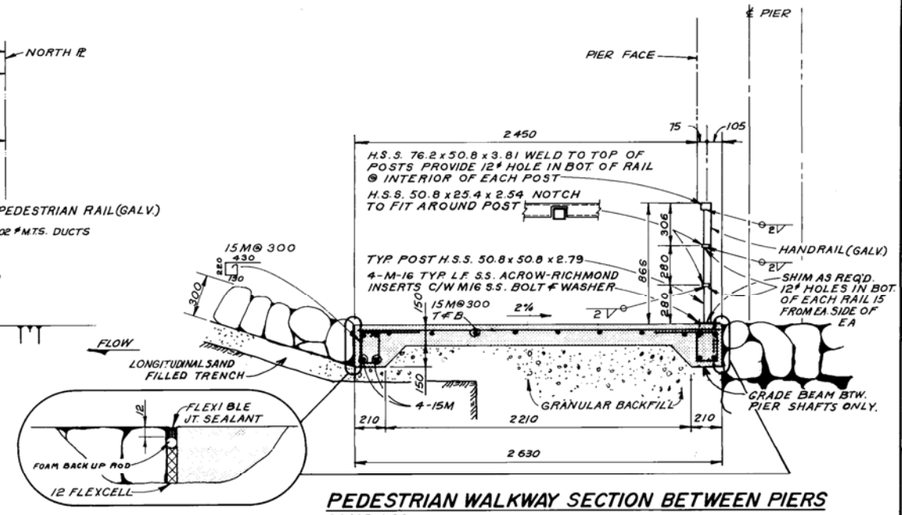

PEDESTRIAN WALKWAY SECTION BETWEEN PIERS
SCALE: 1:20

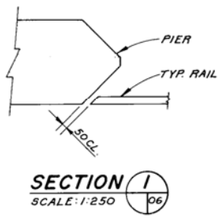

SECTION 1/06
SCALE: 1:250

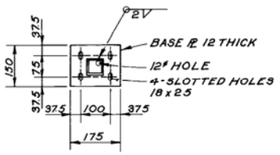

RAIL POST BASE PLATE PLAN
SCALE: 1:10

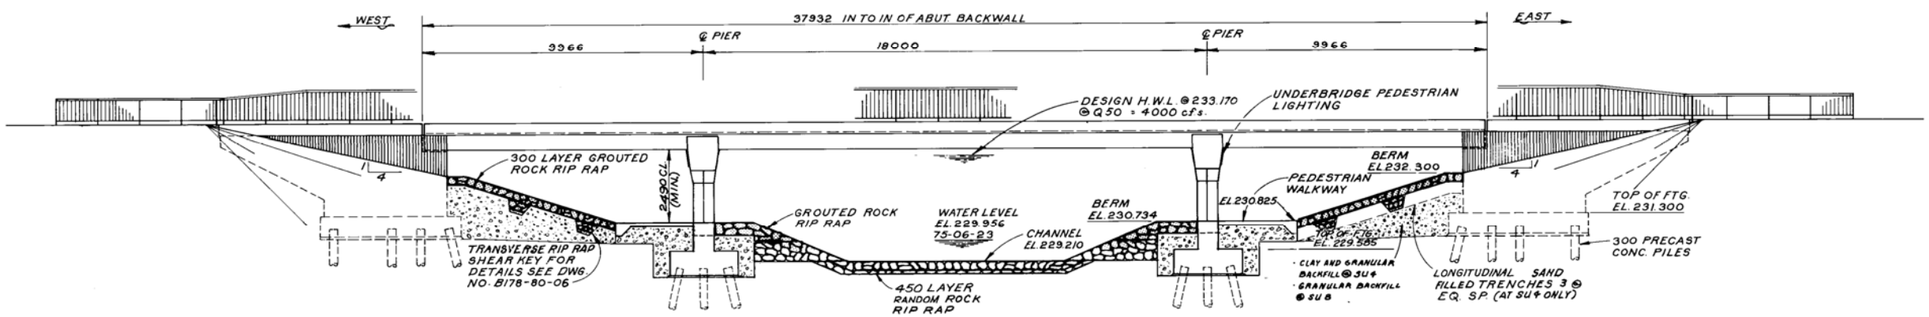

SU-1 (SOUTH STRUCTURE)
SU-5 (NORTH STRUCTURE)

SU-2 (SOUTH STRUCTURE)
SU-6 (NORTH STRUCTURE)

SU-3 (SOUTH STRUCTURE)
SU-7 (NORTH STRUCTURE)

SU-4 (SOUTH STRUCTURE)
SU-8 (NORTH STRUCTURE)

DOWNSTREAM ELEVATION

B-5391

AS BUILT

NOTE: DETERMINE LOCATION OF UNDERGROUND UTILITIES BEFORE PROCEEDING WITH CONSTRUCTION.

WARNING: READ THIS BEFORE YOU BEGIN WORK IF POWER EQUIPMENT OR EXPLOSIVES ARE TO BE USED FOR THE EXCAVATION AUTHORIZED BY THE ATTACHED PERMIT, NO WORK SHALL BE COMMENCED BEFORE: (1) THE LOCAL OFFICE OF THE GAS COMPANY HAS BEEN NOTIFIED OF THE PROPOSED EXCAVATION, AND (2) THE GAS COMPANY HAS MARKED OUT THE LOCATION OF ANY ENDANGERED GAS INSTALLATIONS, OR THE GAS COMPANY HAS ADVISED THAT NO GAS INSTALLATIONS WILL BE ENDANGERED BY THE PROPOSED EXCAVATION FOR SPECIFIC DETAILS REFER TO MANITOBA REGULATIONS 210/72 MADE UNDER THE GAS PIPE LINE ACT.

LOCATION APPROVED
UNDERGROUND STRUCTURES COMMITTEE
OCT. 24/80 (DATE) — SUPV. U/G STRUCTURES COMMITTEE

LOCATION OF UNDERGROUND STRUCTURES AS SHOWN ARE BASED ON BEST INFORMATION AVAILABLE, BUT NO GUARANTEE IS GIVEN THAT ALL EXISTING UTILITIES ARE SHOWN AND EXACT LOCATIONS OF ALL UNDERGROUND INCLUDING SERVICE CONNECTIONS MUST BE CHECKED WITH THE UTILITY CONCERNED BEFORE PROCEEDING WITH CONSTRUCTION.

NO.	REVISIONS	DATE	APP.

ENGINEER'S SEAL — 23/9/80

Consulting Engineers & Planners — DILLON

DESIGNED BY N.B.U.	DRAWN BY C.R.B.
CHECKED BY L.D.M.	DATE 80-8-25
APPROVED BY	DATE 23/9/80

THE CITY OF WINNIPEG
WORKS & OPERATIONS
STREETS & TRANSPOPTATION

STURGEON CREEK BRIDGE ON PORTAGE AVENUE
GENERAL ARRANGEMENT ELEVATION & SECTIONS

AUTHORIZED BY — DATE 80-10-01
ACCEPTED BY — DATE 80-10-24
SCALE: 1:100
DRAWING NO: B178-80-05

PROJ. NO. 7580-02 G-3