
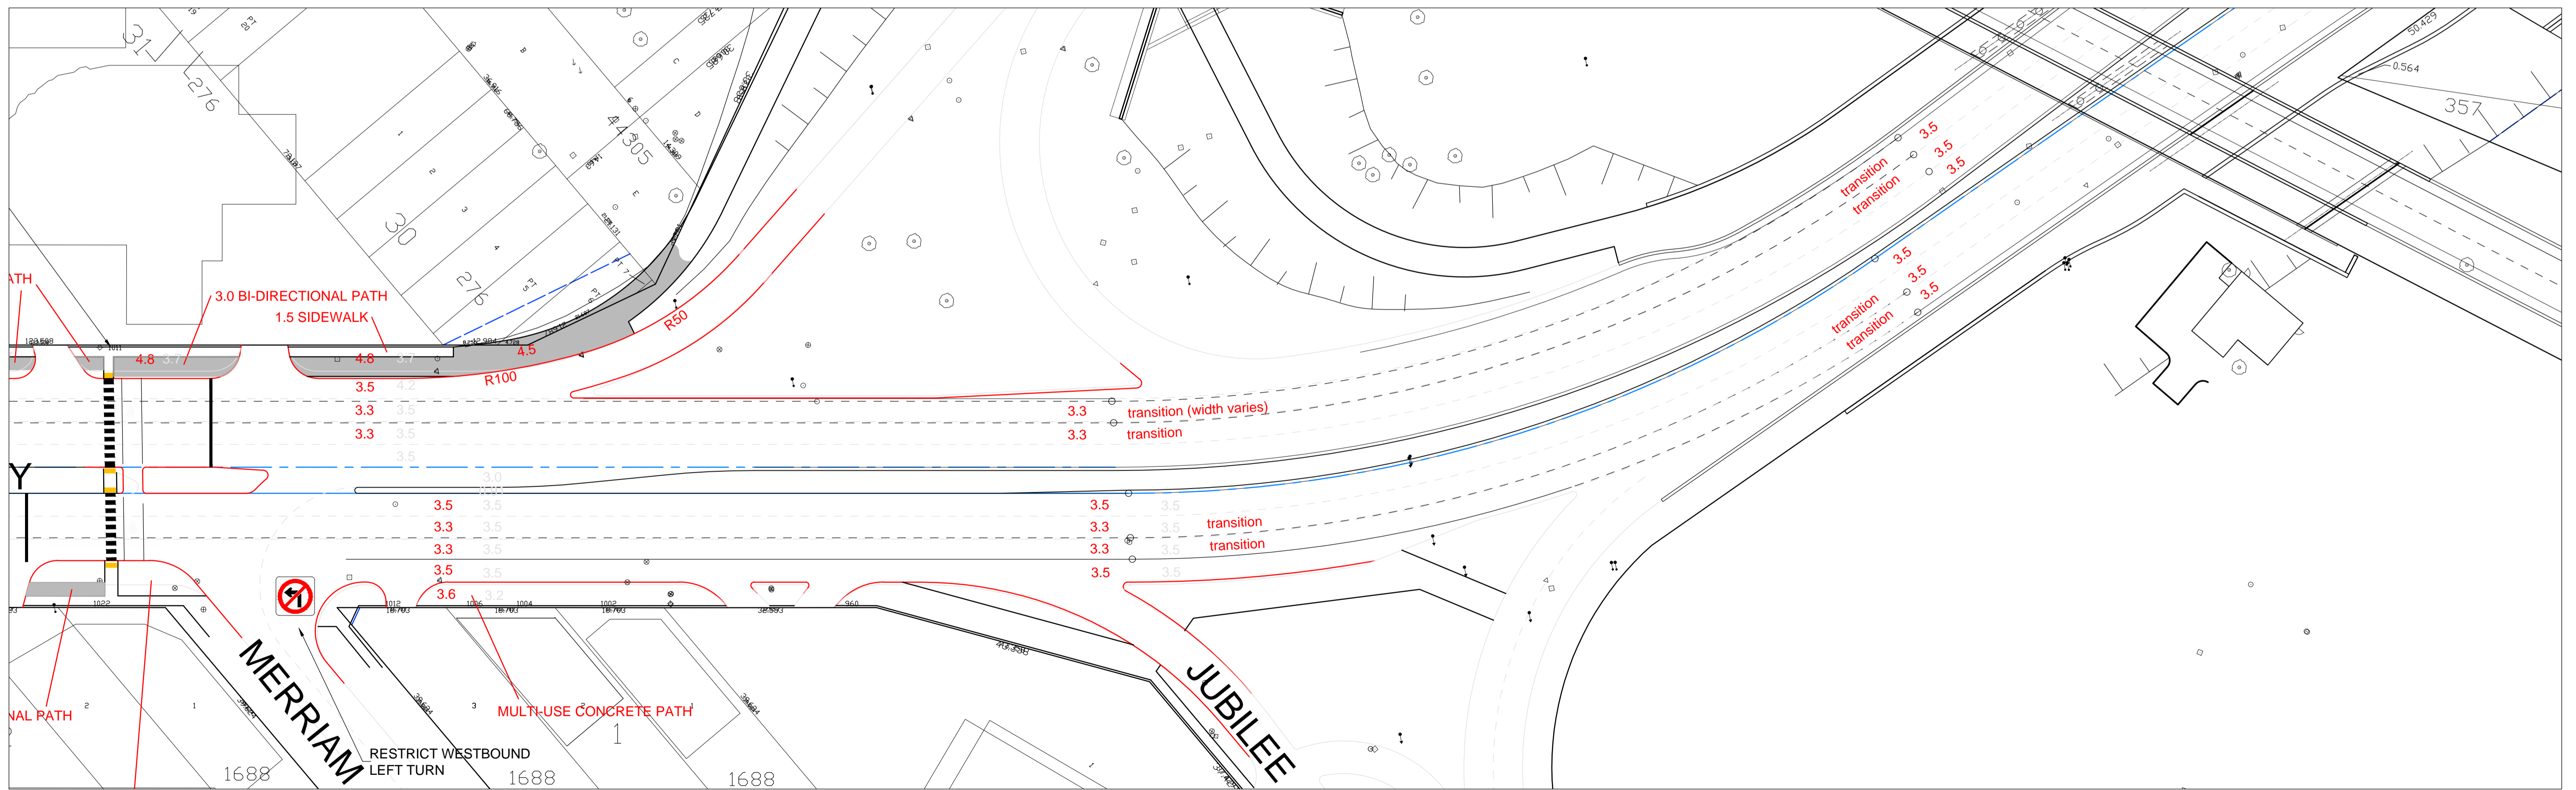


Appendix JJ – AT Path Functional Design – Pembina Highway at Jubilee Avenue

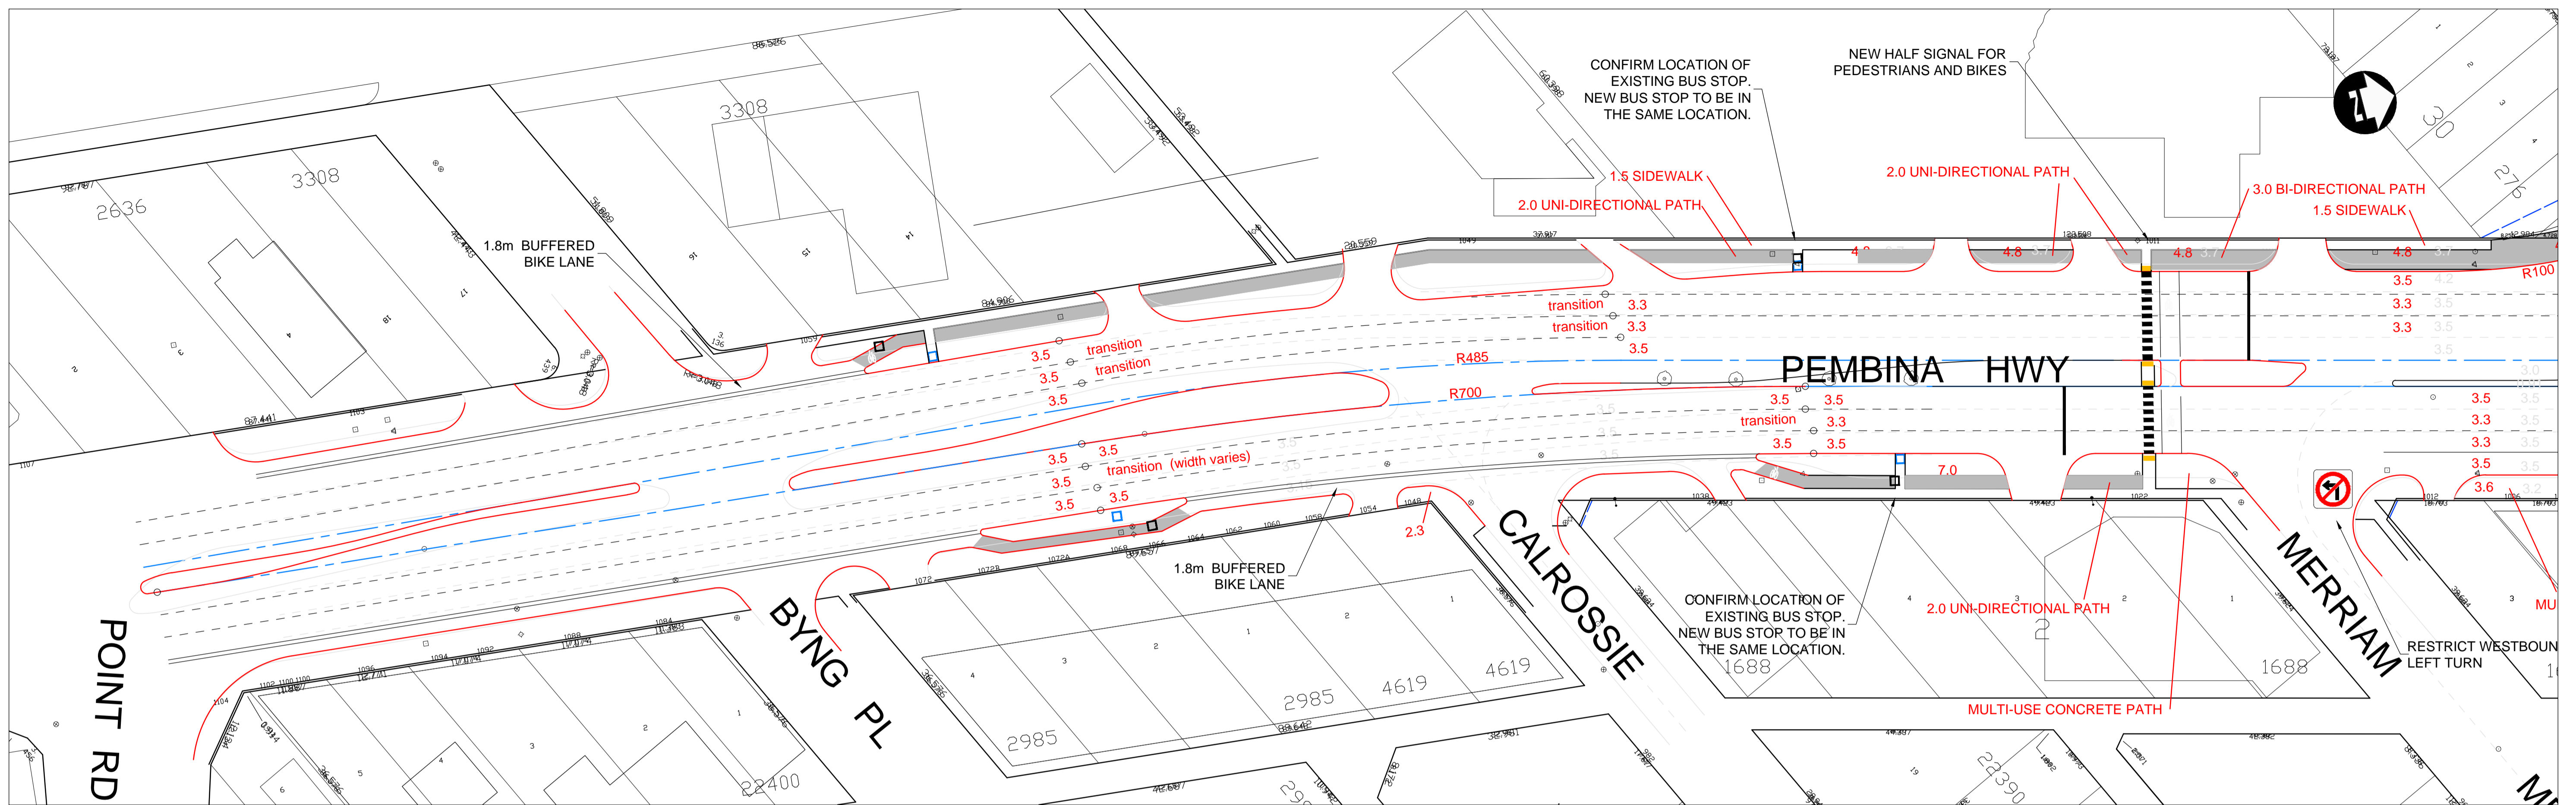

PRELIMINARY
NOT TO BE USED FOR CONSTRUCTION

THE CITY OF WINNIPEG
PUBLIC WORKS DEPARTMENT
TRANSPORTATION DIVISION

Winnipeg

DRAWN BY: MRD
DATE: 2015-10-27

SCALE:
1:500

PEMBINA HWY AT JUBILEE AVE
BIKE PATH
FUNCTIONAL DESIGN

DRAWING NO.
REF-021