
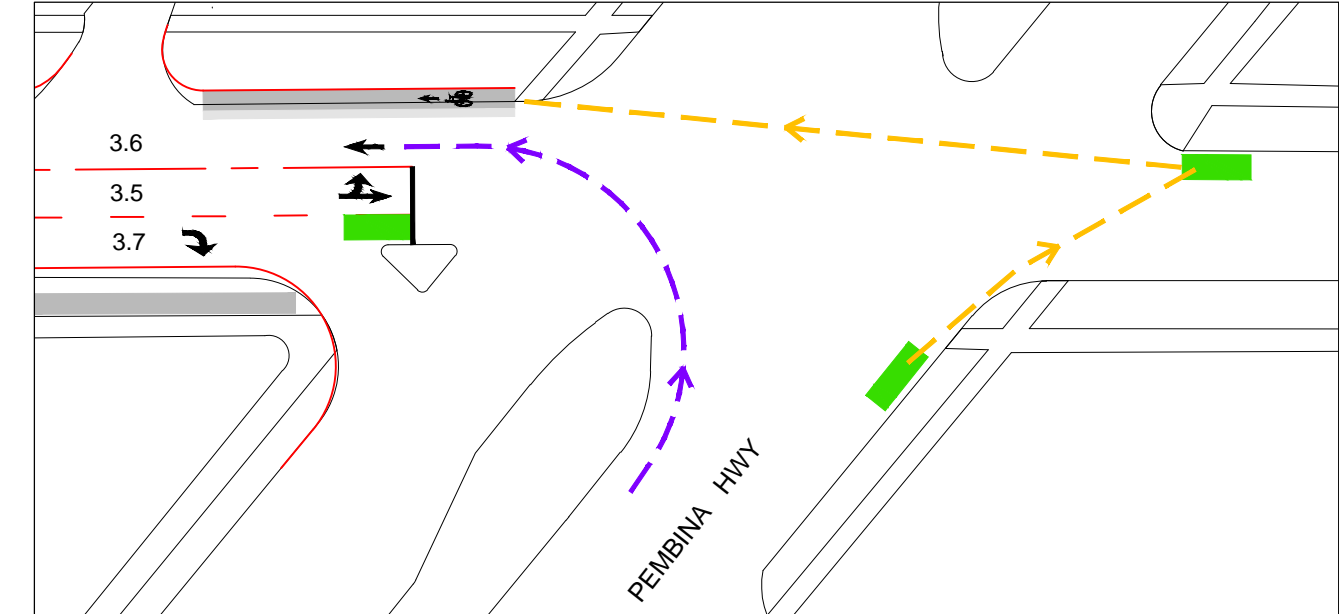
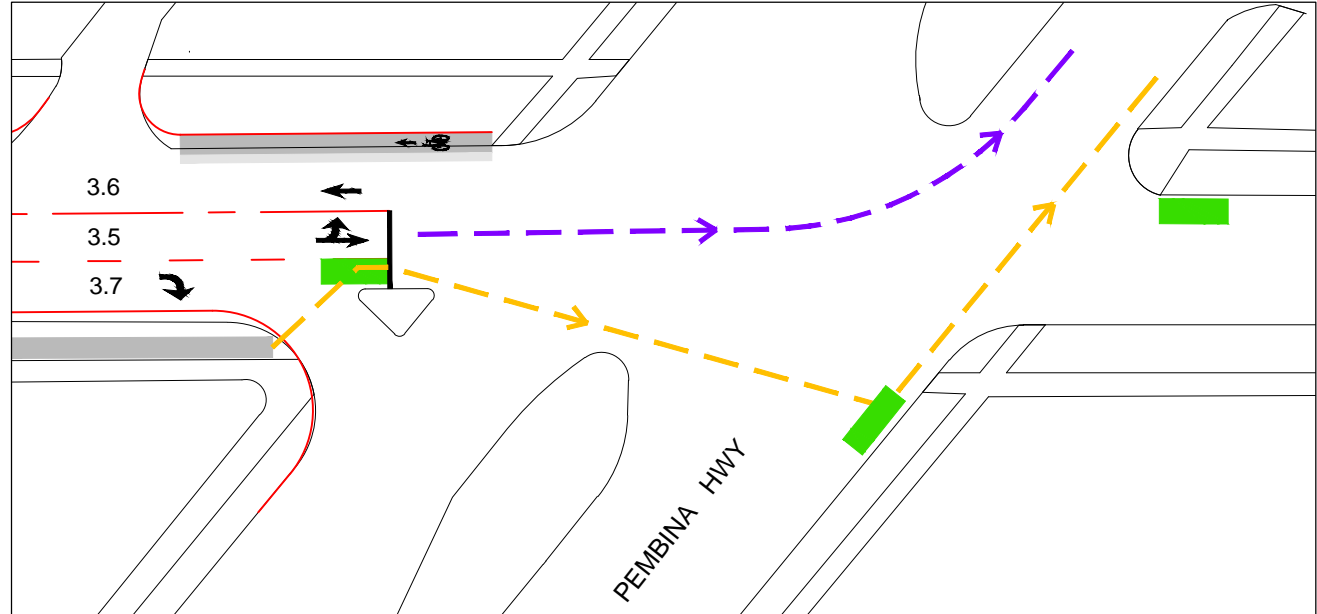
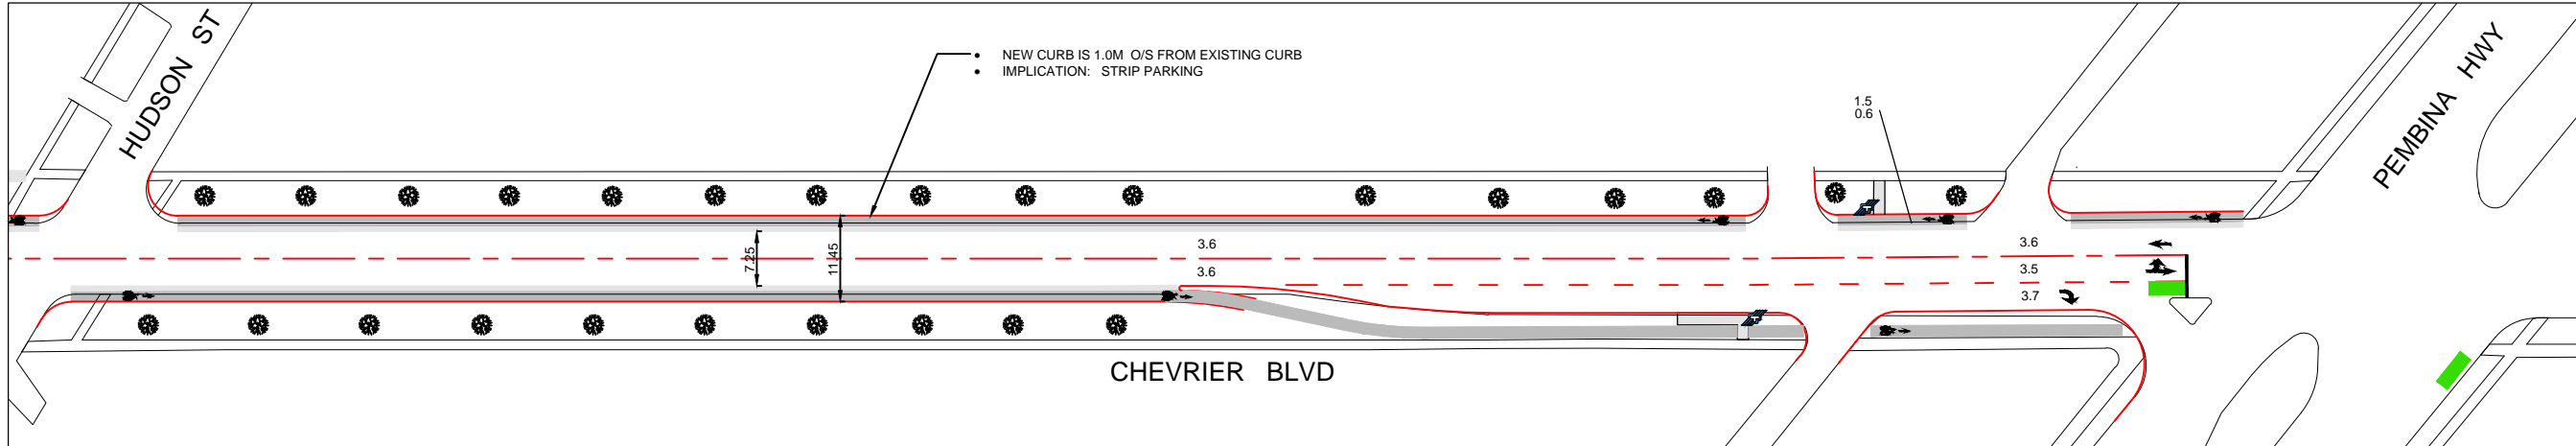


*Appendix TT – AT Path for Chevrier at Pembina*

V:\TRANSPORTATION PLANNING DRAFTING\01 - TYPRAFT\1 - RESIDENTIAL STREETS\CHEVRIER\REF\_01-BUFFERED BIKE LANES-1.0M O-SLDWG

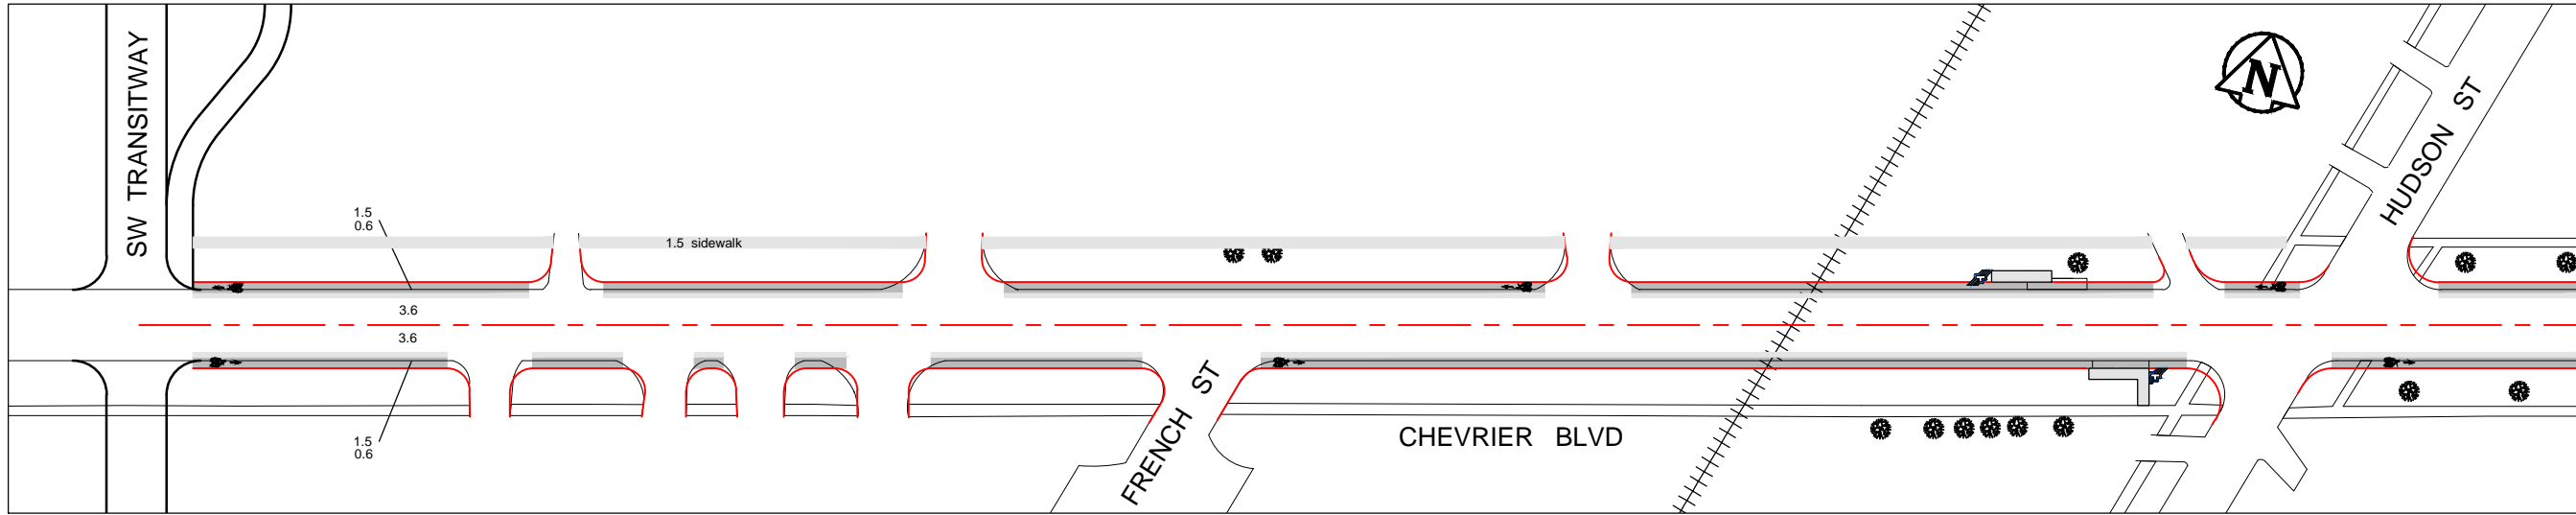

**PRELIMINARY**  
NOT TO BE USED FOR CONSTRUCTION

NO.	REVISIONS	DATE	BY

DESIGNED BY MRD	CHECKED BY
DRAWN BY MRD	APPROVED BY
HOR. SCALE: -	RELEASED FOR CONSTRUCTION
VERTICAL: -	DATE
DATE 2016-01-20	

CONSULTANT DRAWING NO.

**THE CITY OF WINNIPEG**  
PUBLIC WORKS DEPARTMENT  
TRANSPORTATION DIVISION

**CHEVRIER AT PEMBINA**  
BUFFER BIKE LANES  
OPTION 1

SHEET 1 OF 1  
CITY DRAWING NUMBER REF-01