A1 SIZE – 594mm x 841mm

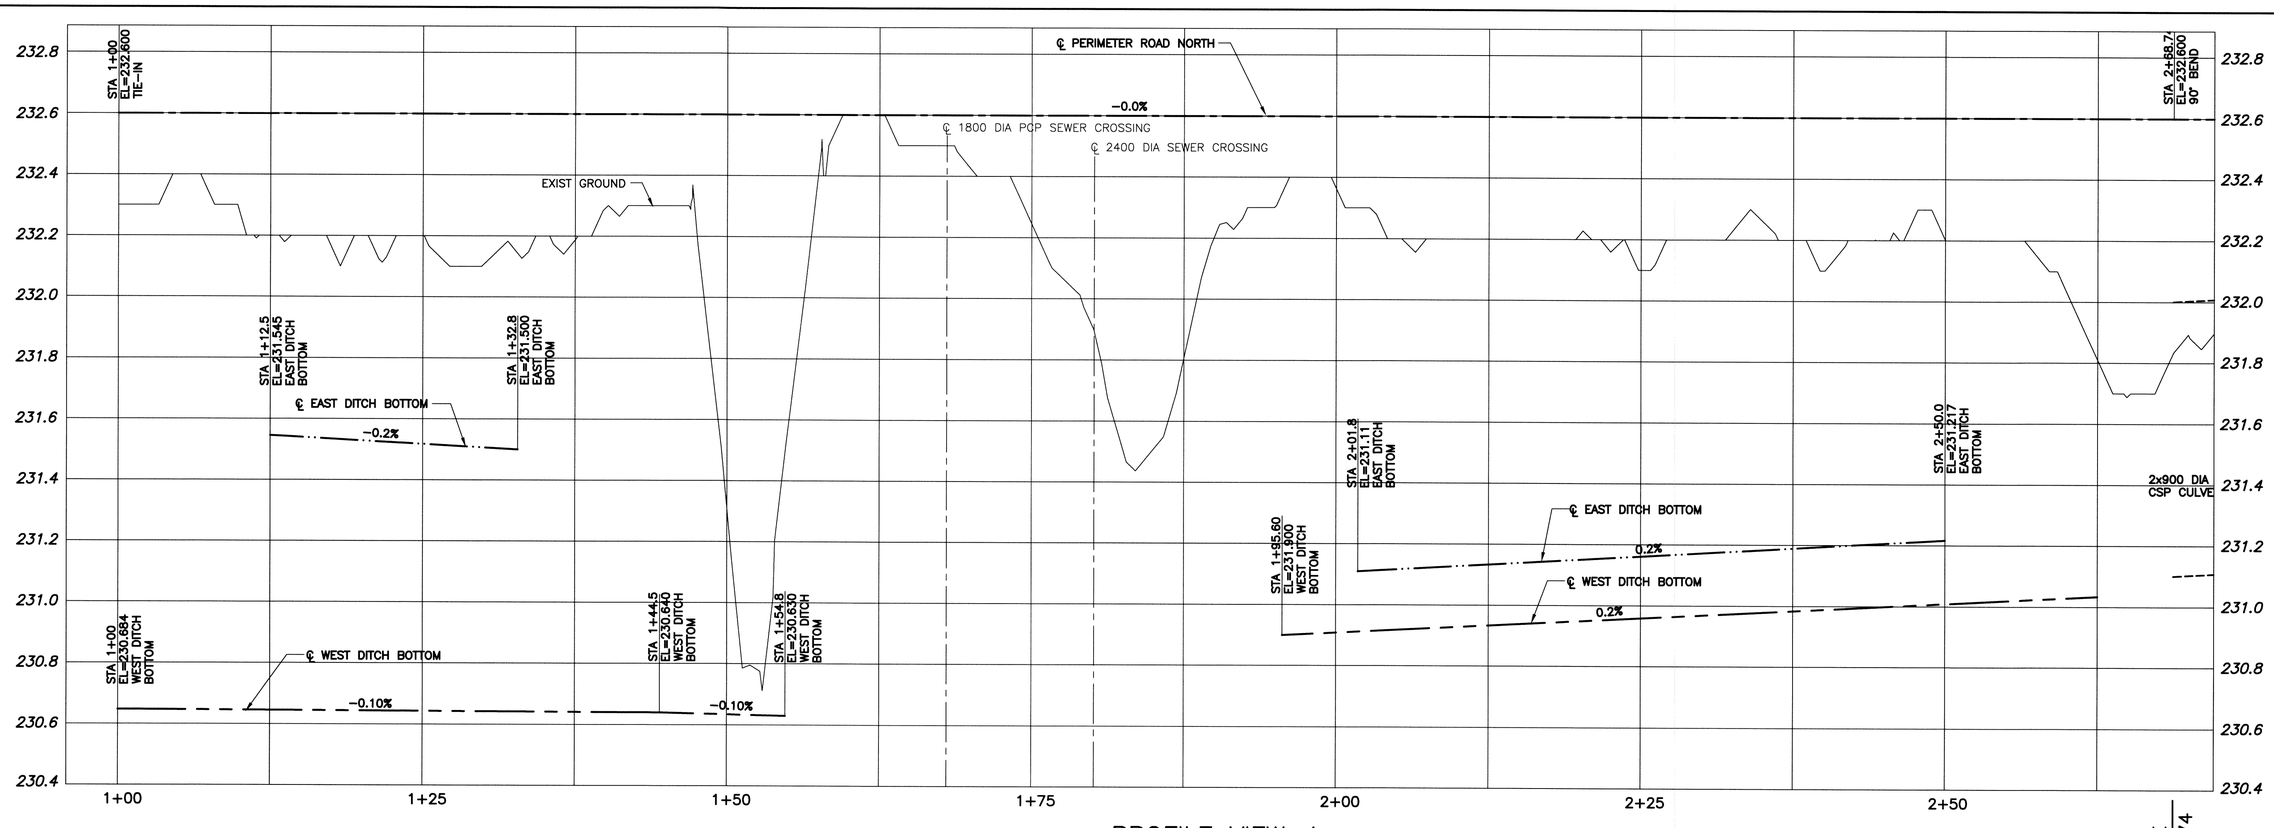

PROFILE VIEW–A

SCALE: 1:250

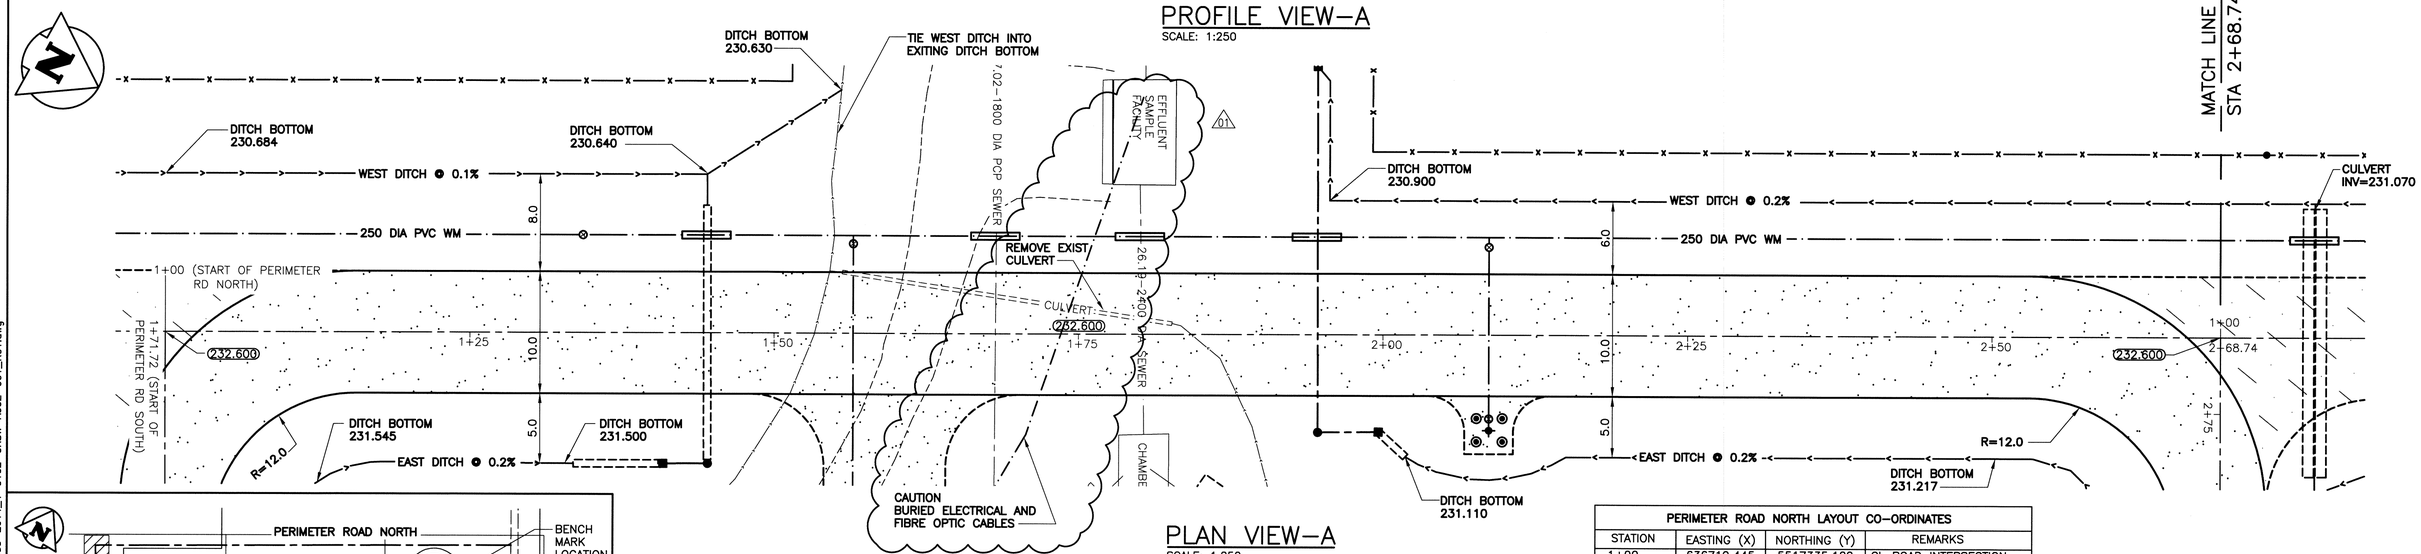

PLAN VIEW–A

SCALE: 1:250

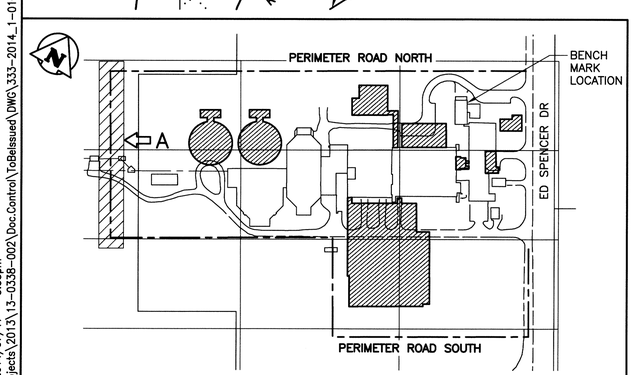

LOCATION PLAN

ROADWAY DRAWING NOTES

NOTES:

1. ALL WORK SHALL BE PERFORMED IN ACCORDANCE WITH THE CITY OF WINNIPEG STANDARD CONSTRUCTION SPECIFICATIONS.
2. ALL PIECES OF EXISTING MUNICIPAL INFRASTRUCTURE TO BE REMOVED OR ABANDONED ARE IDENTIFIED IN GREATER DETAIL ON DRAWINGS 1–0102–CGAD–A006 SHEETS 001 THROUGH 012 .

0 5.0 10.0 15.0 20.0m

SCALE: 1:250m (A1)
1:500m (A3)

LEGEND

ITEM	EXISTING	NEW	ABANDONED
WM			
WM VALVE	⊗	⊗	
WM HYDRANT			
SEWER			
SEWER MH	○	●	○
SEWER CB	□	■	□
MTS			
MTS MH	○	●	
HYDRO			
HYDRO LS	●–		
HYDRO POLE	●HP		
GAS			
DITCH			
FENCE	–x–	–x–	

ITEM	EXISTING	NEW	ABANDONED
SIGN	○	○	
BOLLARD	◉	◉	
TREE			
BUSH			
ELEVATION	233.240	233.450	
CULVERT			
ROAD			
CONSTRUCTION ACCESS ROAD			

B.M. BRASS PLATE LOCATED IN GRADE BEAM OF ADMININSTRATON BUILDING
ELEV. 234.059

NO.	REVISIONS	DATE	DESIGN	CHECK
01	ISSUED FOR ADDENDUM NO.1	07/2014	EMS	BJM
00	ISSUED FOR TENDER	06/2014	EMS	BJM

PERIMETER ROAD NORTH LAYOUT CO–ORDINATES

STATION	EASTING (X)	NORTHING (Y)	REMARKS
1+00	636719.445	5517335.109	CL ROAD INTERSECTION
2+68.74	636637.007	5517482.347	CL ROAD INTERSECTION

CH2MHILL. SNC·LAVALIN KGS GROUP

DESIGNED BY: EMS	CHECKED BY: BJM
DRAWN BY: DMW	APPROVED BY: RJH
SCALE: AS NOTED	RELEASED FOR CONSTRUCTION BY:
DATE: 2014/06/27	DATE:
CONSULTANT NO.: 13–0338–002	

ENGINEER'S SEAL

PROVINCE OF MANITOBA
B.J. MIKOLAYENKO
Member 24688
REGISTERED PROFESSIONAL ENGINEER
Jul 17/2014

APEGM
Certificate of Authorization
KGS Group
No. 245

Winnipeg
THE CITY OF WINNIPEG
WATER AND WASTE DEPARTMENT

SOUTH END WATER POLLUTION CONTOL CENTRE
SEWPCC UPGRADE/EXPANSION PROJECT
CIVIL
PERIMETER ROAD NORTH
STA 1+00 TO STA 2+68.74

CITY DRAWING NUMBER	SHEET	REV.	SIZE
1–0102–CRSW–A002	001	01	A1

LAST SAVE: 2014/07/17 – 3:53pm
PATH: P:\Projects\2013\13–0338–002\Doc.Control\ToBeIssued\DWG\333–2014_1–0102–CRSW–A002–001_R01.dwg

PLOT DATE: Jul 17, 2014 – 3:53pm

FILE NAME: 333–2014_1–0102–CRSW–A002–001_R01.dwg