


PACK OPENING AROUND
DUCT W/ MINERAL
FIREPROOFING & SAFEING


(2305-412)

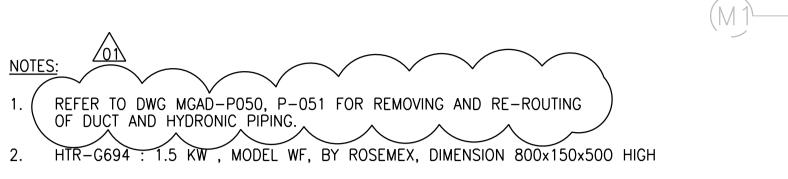



- 3. HWS/HWR, GS/GR: CARBON STEEL PIPE AND FITTING FOR HYDRONIC WATER SERVICE C/W 40mm FIBERGLASS INSULATION AND ALUMINUM JACKETING
- 4. ALUMINUM DUCTWORK WITH 32mm FIBERGLASS BOARD INSULATION AND FACTORY FINISH JACKETING
- 5. FIELD VERIFY EXACT DUCT SIZE TO MATCH WITH EXISTING AHU OPENING
- 6. GR-P681-1: TITUS, MODEL 300RS-SS C/W GANG-OPERATED OPPOSED-BLADE VOLUME CONTROL DAMPER, DIMENSION 250x250


7. FD-P681-1: REFER TO DAMPER SCHEDULE ON DWG MGAD-K604

8. V513 BUTTERFLY SHUT-OFF VALVES - SERIES 30/31, BRAY CONTROLS WITH CHAINWHEEL OPERATOR EXTENSION.

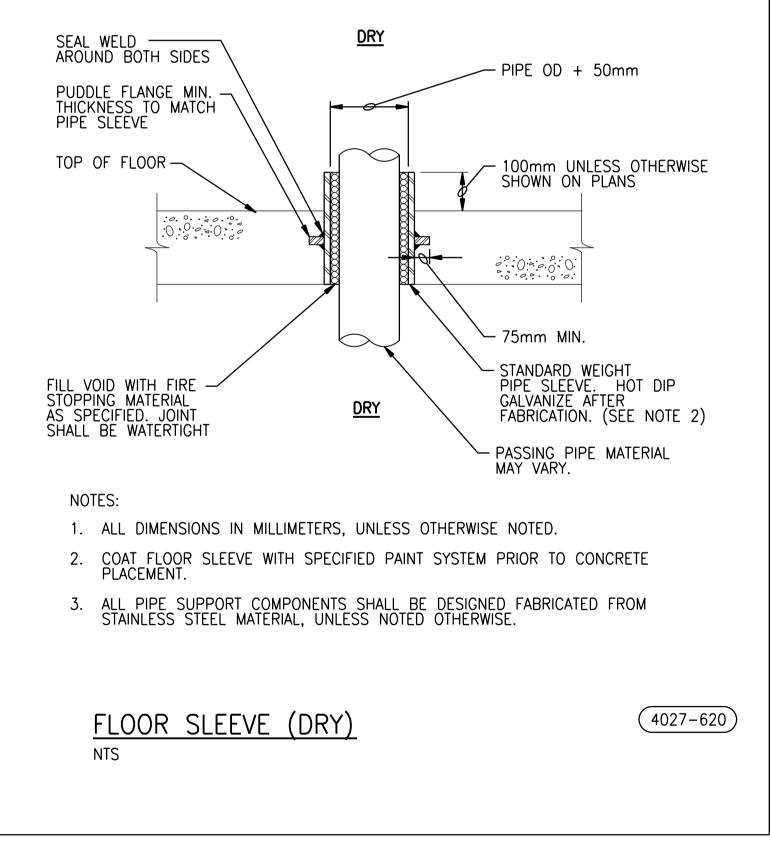

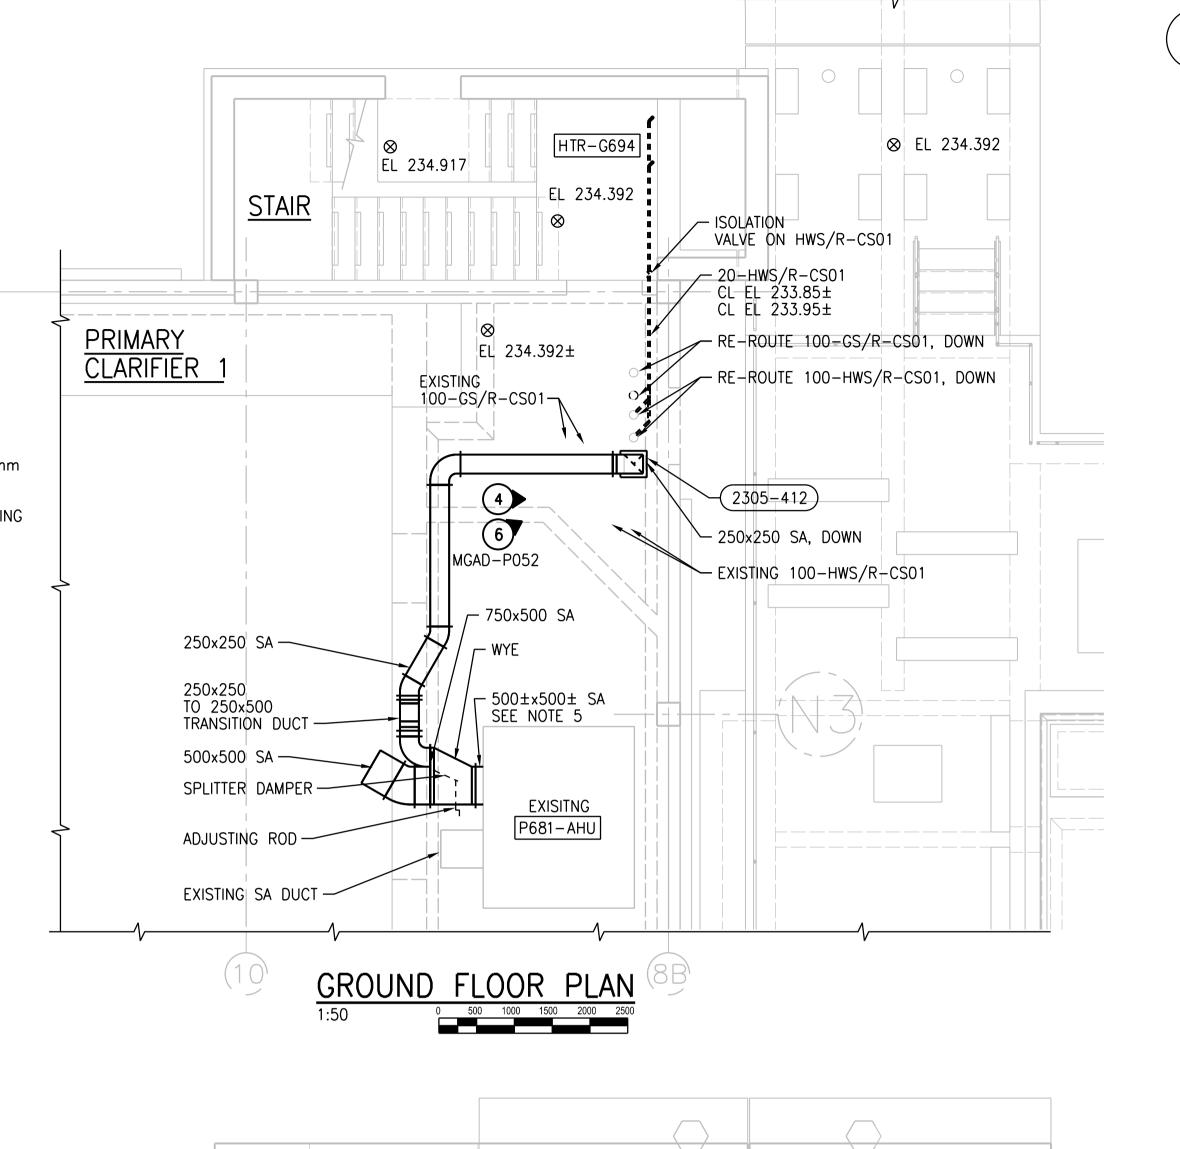

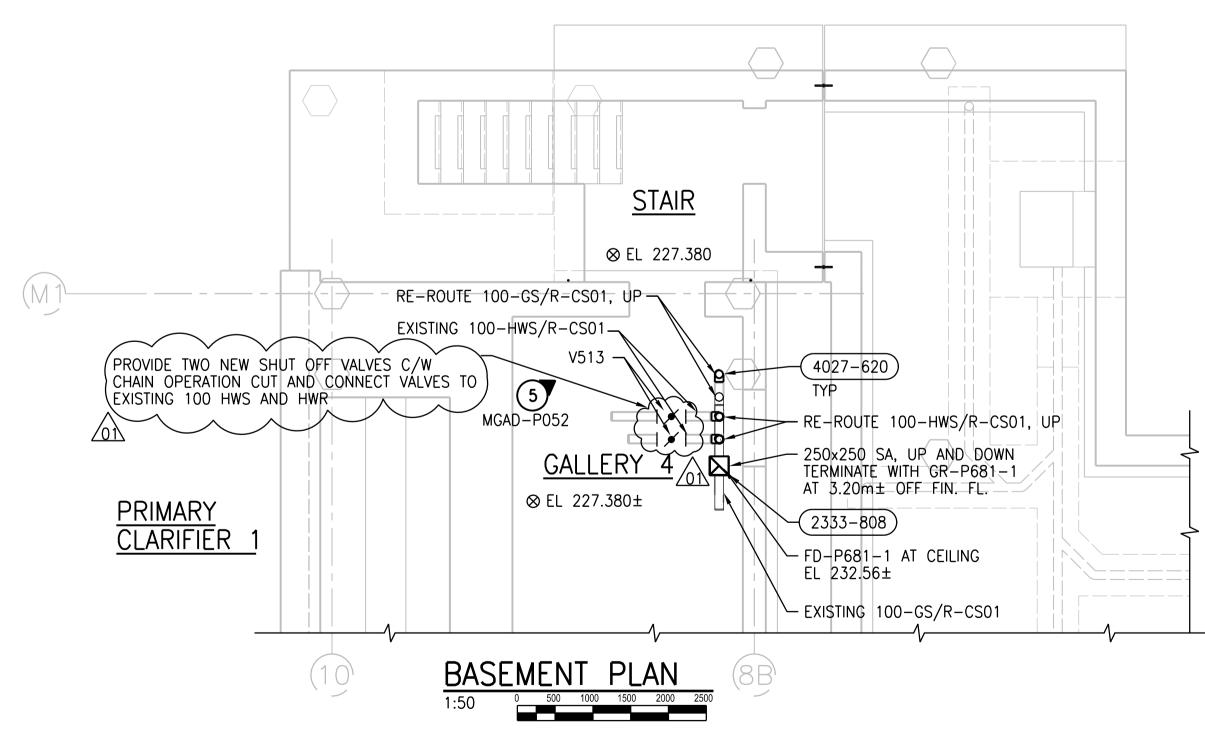

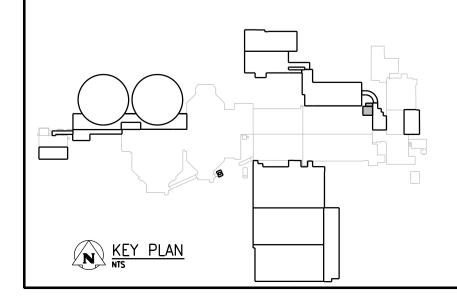

ALL AROUND, TYP BOTH SIDES OF STRUCTURE

1. WALL PENETRATION SIMILAR.

2. 50mm ANGLE CLOSURE COLLAR OF SAME MATERIAL AS DUCT.

<u>FLOOR PENETRATION – DRY AREA</u>

NOTES:

Certificate of Authorization
CH2M HILL Canada Ltd.
No. 1441

				CH2MHILL _®		ENGINEER'S SEAL	
					•))	KGS GROUP	
					SNC · LAVALIN	CONSULTING ENGINEERS	
					DESIGNED BY:	CHECKED BY:	
					D. LE	T. TRAN	
			 		DRAWN BY:	APPROVED BY:	
					K. FONG	J. CHENG	
					SCALE: AS NOTED	ISSUED FOR CONSTRUCTION	
						BY: T. TURZAK	
01	ISSUED FOR ADDENDUM NO. 2	09/2015	K.R.	T.T.	DATE: 2015/08/13	DATE: 2015/08/13	
00	ISSUED FOR TENDER	08/2015	K.F.	T.T.	CONSULTANT NO		
NO.	REVISIONS	DATE	DESIGN	CHECK	474248		

Winnipeg Water and Waste Department

SOUTH END WATER POLLUTION CONTROL CENTRE

SEWPCC UPGRADING/EXPANSION PROJECT

MECHANICAL

PRIMARY CLARIFIERS

PARTIAL PLANS

CITY DRAWING NUMBER SHEET REV. SIZE

1-0102-MGAD-P60

THE CITY OF WINNIPEG

PLOT DATE: 2015\09\11

FILE NAME: