



**1** DETAIL  
1:25  
PGAD-R002  
PGAD-R003  
PGAD-R004

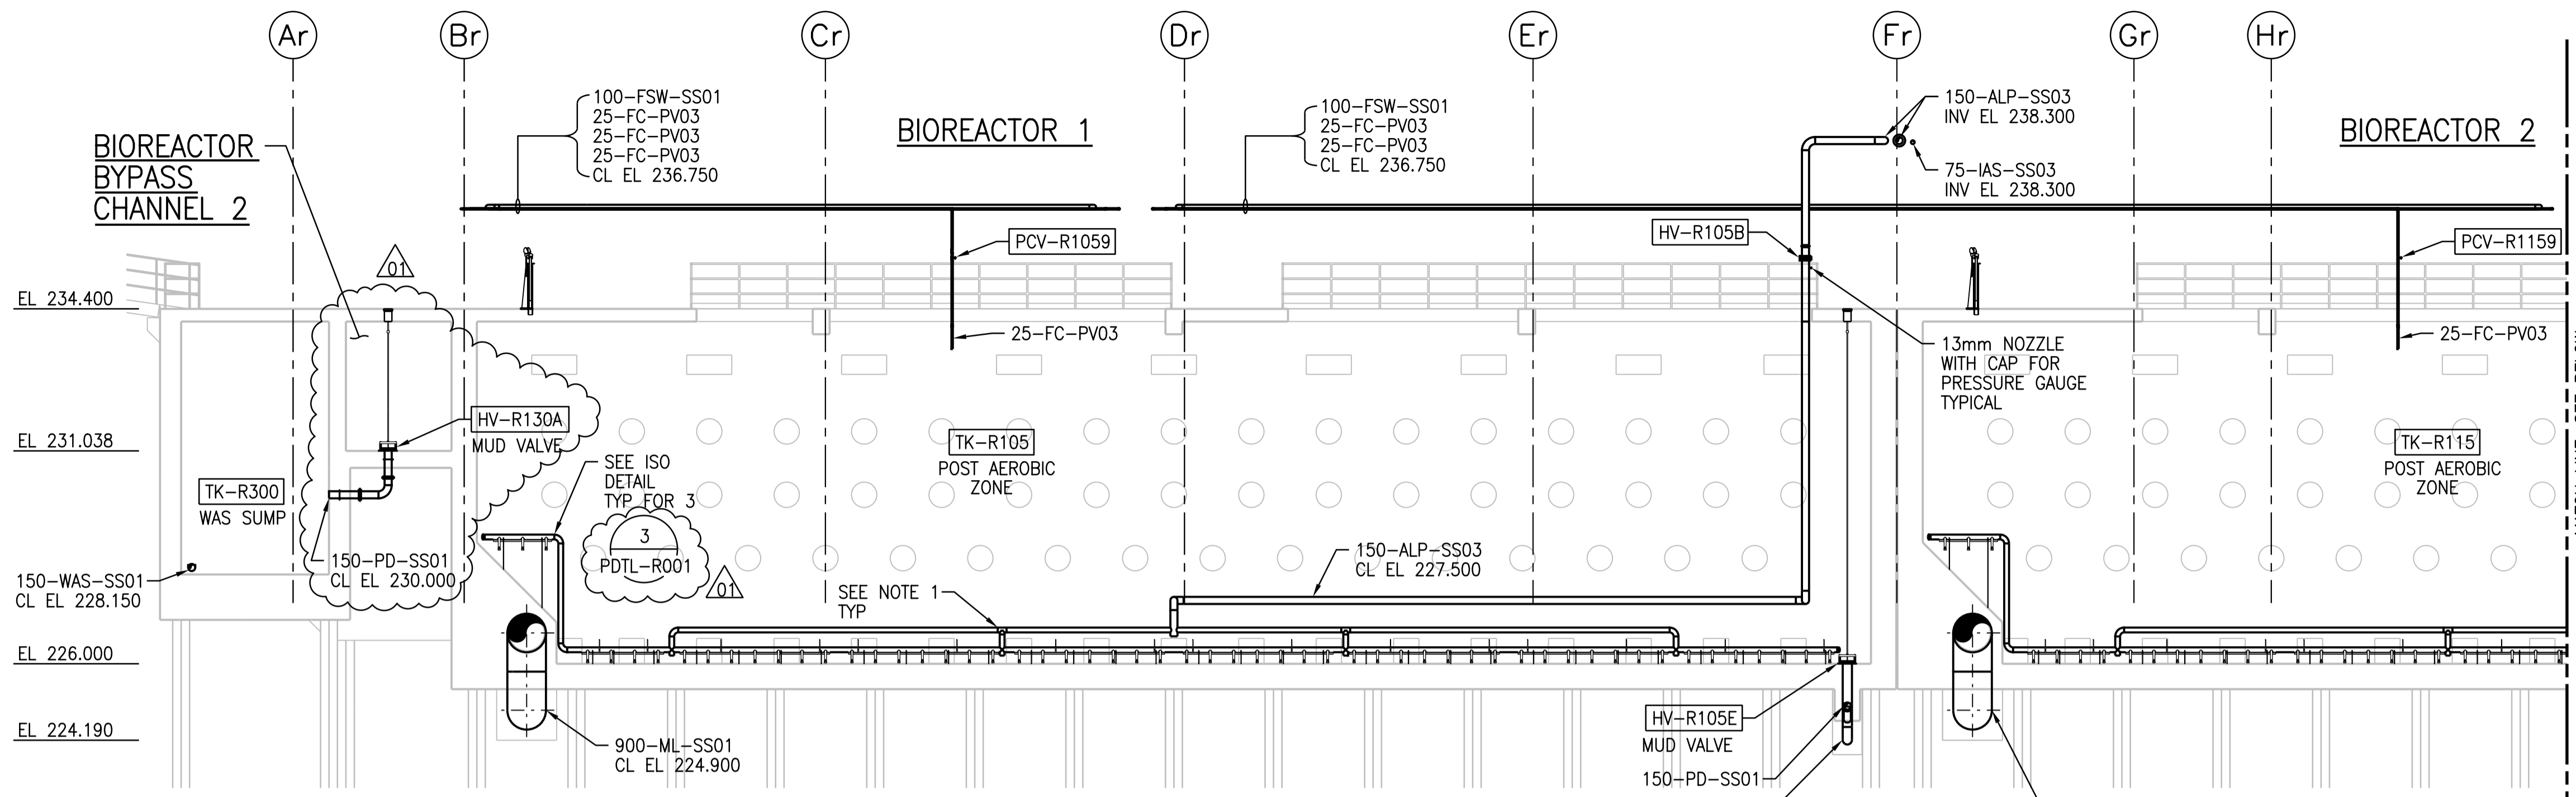

**SECTION - PART A**  
1:100  
PGAD-R001  
PGAD-R005  
PGAD-R009

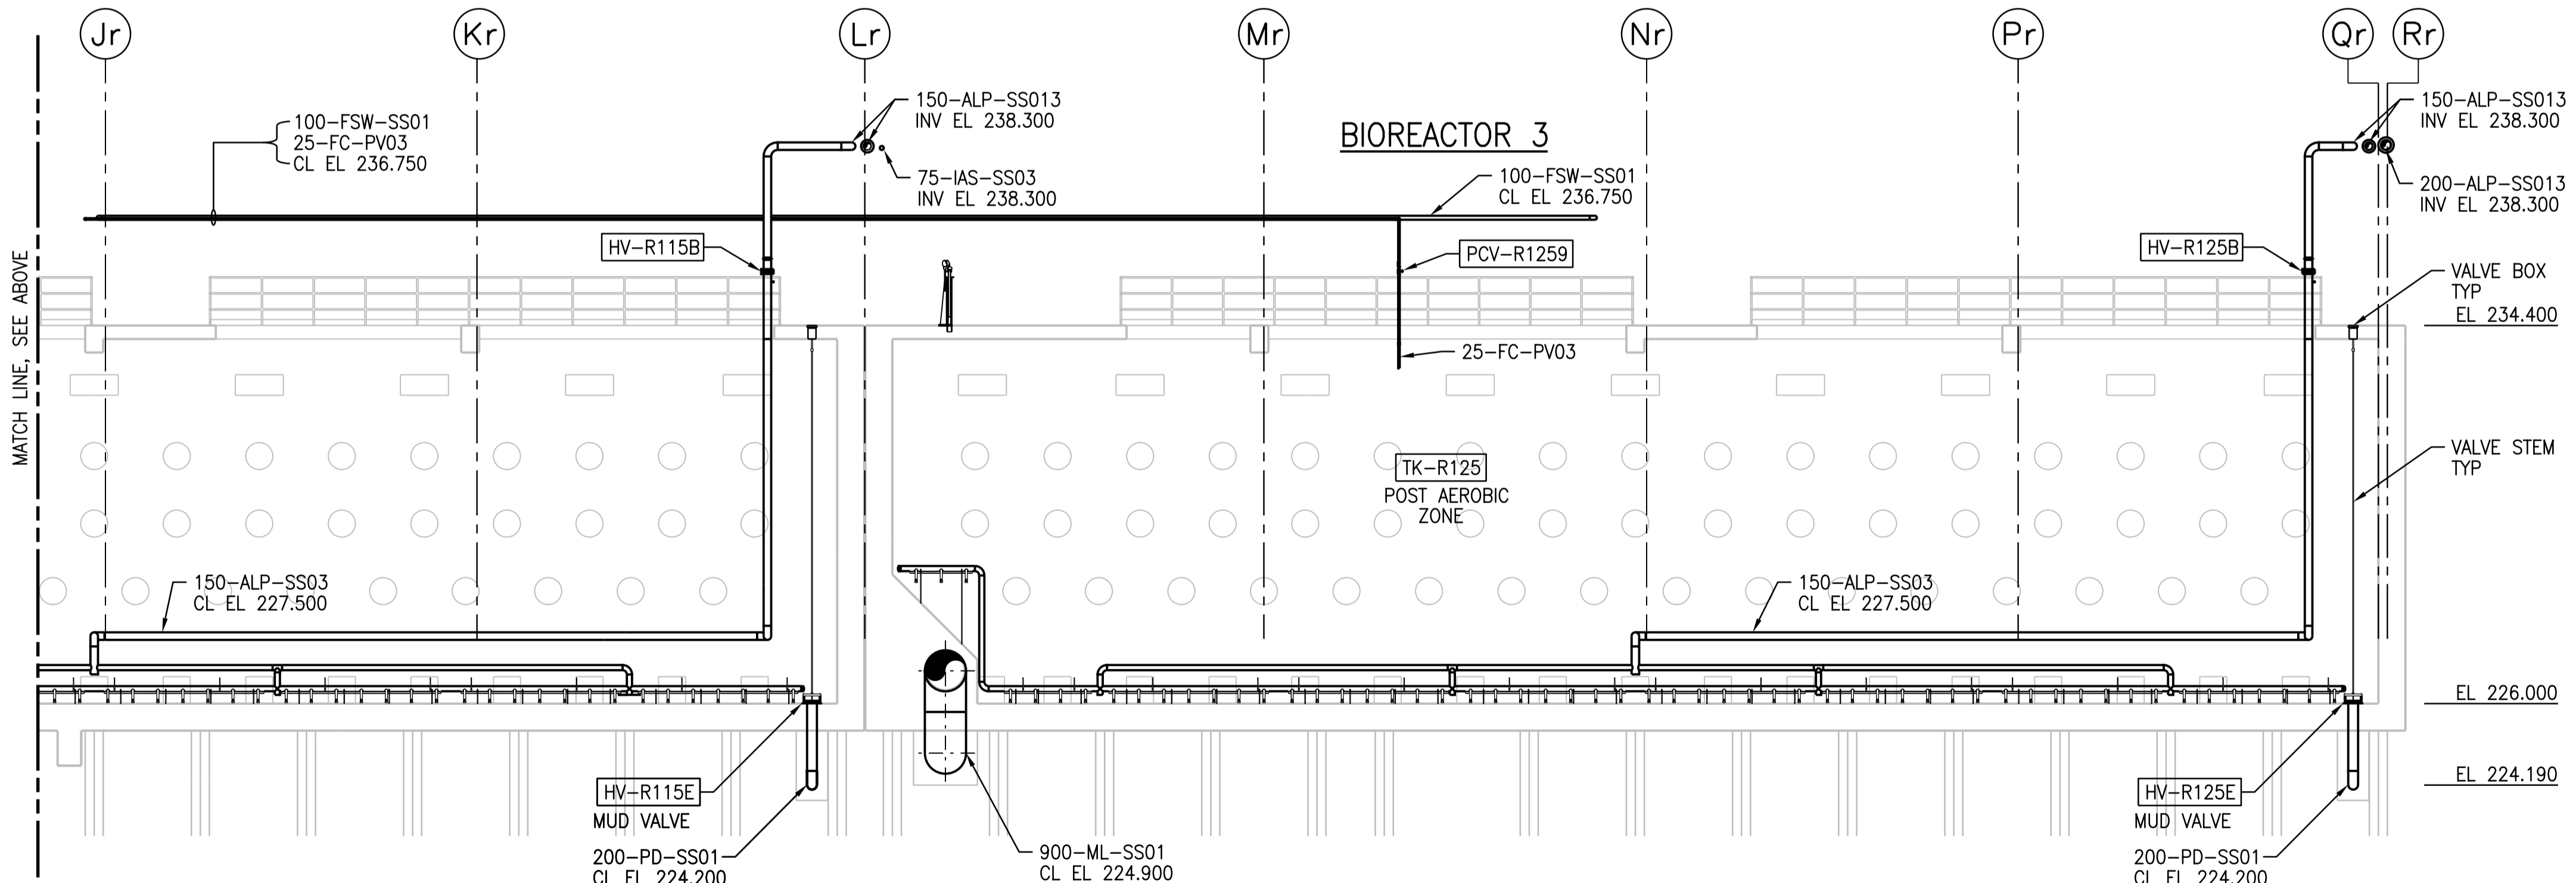

**SECTION - PART B**  
1:100  
PGAD-R001  
PGAD-R005  
PGAD-R009

**NOTE:**  
1. POST AEROBIC ZONE AERATION ASSEMBLIES SYSTEM (REFER TO VENDOR DRAWINGS FOR PLACEMENT LOCATION AND DETAILS).



NO.	REVISIONS	DATE	DESIGN	CHECK
01	ISSUED FOR ADD. 2 - B.O. 899-2015	02/2016	B.C.	J.C.
00	ISSUED FOR TENDER - B.O. 899-2015	01/2016	B.C.	J.C.

<b>CH2MHILL</b>		ENGINEER'S SEAL	
SNC-LAVALIN		KGS GROUP	
DESIGNED BY: F. ABSI	CHECKED BY: B. EDGAR		
DRAWN BY: B. COOPER	APPROVED BY: H.T. FREIHAMMER		
SCALE: AS SHOWN	ISSUED FOR CONSTRUCTION BY: T. TURZAK		
DATE: 2016/01/29	DATE: 2016/01/29		
CONSULTANT NO.: 474248			

**THE CITY OF WINNIPEG**  
Winnipeg WATER AND WASTE DEPARTMENT

SOUTH END WATER POLLUTION CONTROL CENTRE  
SEWPC UPGRADING/EXPANSION PROJECT  
PROCESS  
BIOREACTORS/BLOWER BUILDING  
SECTION N AND DETAIL

CITY DRAWING NUMBER: 1-0102-PGAD-R022  
SHEET: 001  
REV: 01  
SIZE: A1