A1 SIZE – 594mm x 841mm

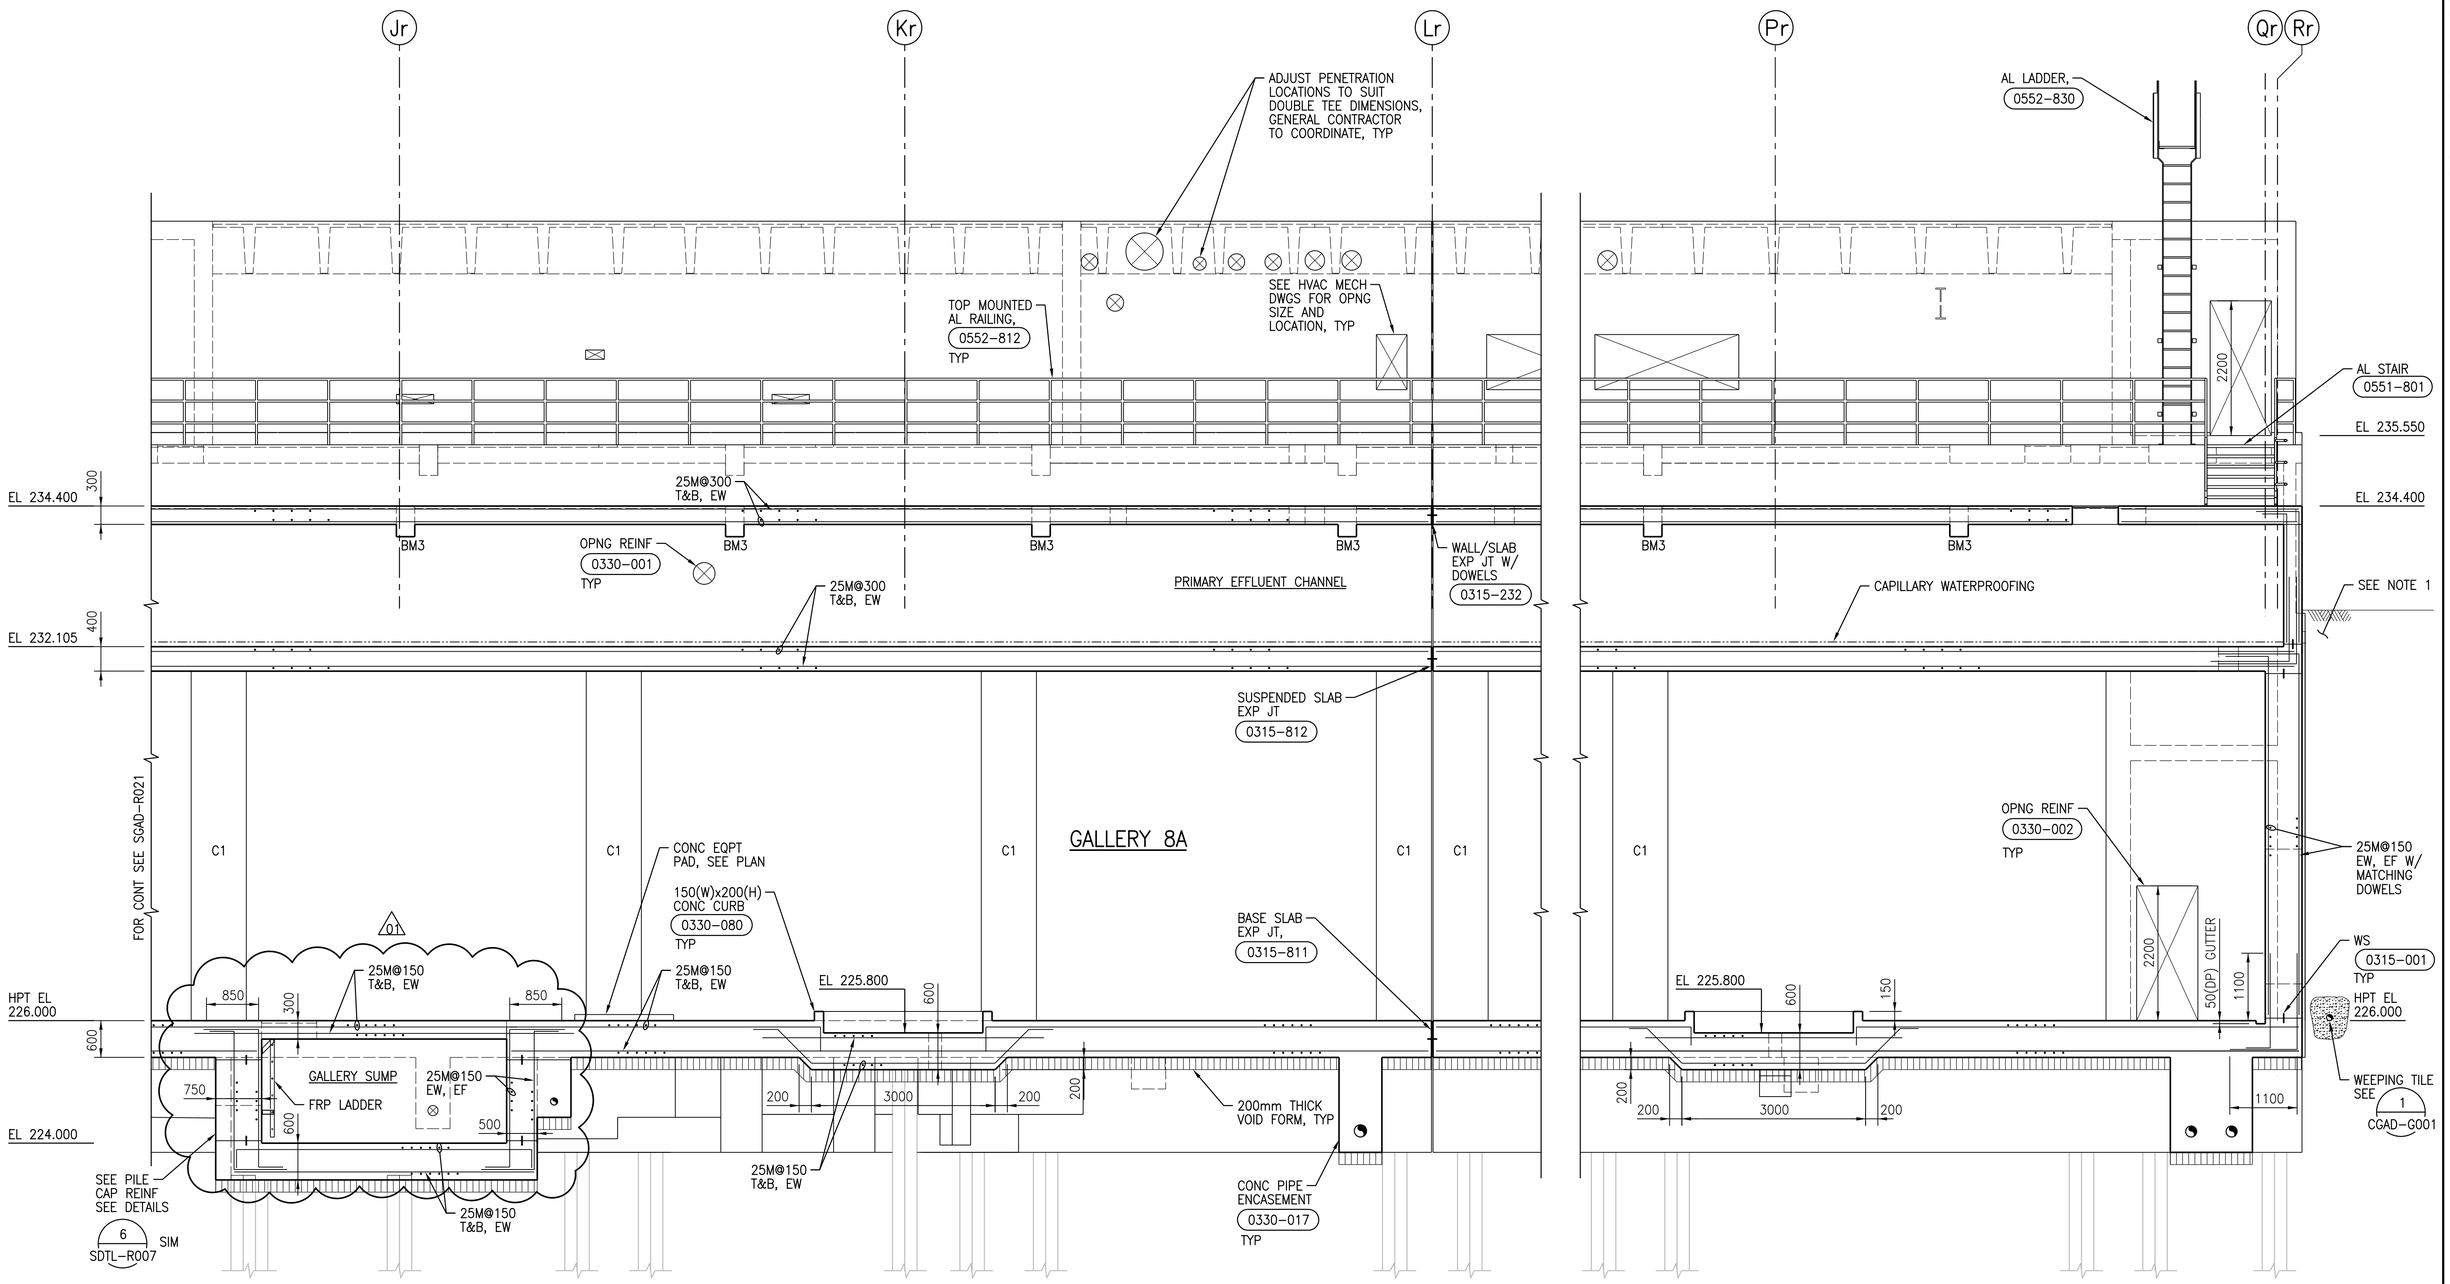

D SECTION – PART B

1:50

SGAD–R001, SGAD–R002, SGAD–R003, SGAD–R004, SGAD–R005, SGAD–R006, SGAD–R007, SGAD–R008, SGAD–R009, SGAD–R010, SGAD–R011, SGAD–R012

NOTE

1. FOR EXCAVATION AND BACKFILL REQUIREMENTS SEE SECTIONS A SGAD–R015/R016 , B SGAD–R017/R018 , C SGAD–R019/R020 , G SGAD–R027 AND K SGAD–R029 .

APEGM
Certificate of Authorization
CH2M HILL Canada Ltd.
No. 1441

NO.	REVISIONS	DATE	DESIGN	CHECK
01	ISSUED FOR ADD. 2 – B.O. 899–2015	02/2016	C.R.	J.C.
00	ISSUED FOR TENDER – B.O. 899–2015	01/2016	C.R.	J.C.

CH2MHILL
SNC·LAVALIN
KGS GROUP CONSULTING ENGINEERS

DESIGNED BY: J. THANNICKAL	CHECKED BY: E. LUI
DRAWN BY: C. RYNARD	APPROVED BY: H.T. FREIHAMMER
SCALE: 1:50	ISSUED FOR CONSTRUCTION
DATE: 2016/01/29	BY: T. TURZAK
CONSULTANT NO.: 474248	DATE: 2016/01/29

ENGINEER'S SEAL
24/02/2016
PROVINCE OF MANITOBA
S.L.E. LUI
Member 37003
REGISTERED PROFESSIONAL ENGINEER

THE CITY OF WINNIPEG
WATER AND WASTE DEPARTMENT

SOUTH END WATER POLLUTION CONTROL CENTRE
SEWPCC UPGRADING/EXPANSION PROJECT
STRUCTURAL
BIOREACTORS/BLOWER BUILDING
SECTION D – PART B

CITY DRAWING NUMBER	SHEET	REV.	SIZE
1–0102–SGAD–R022	001	01	A1

PLOT DATE: 2/24/2016
FILE NAME: 1–0102–SGAD–R022.dgn

©CH2M HILL 2015. ALL RIGHTS RESERVED.