


PLAN AT EFFLUENT CONDUIT NTS

PLAN AT EFFLUENT CONDUIT NTS

PLAN AT STOP GATES NTS

SECTION

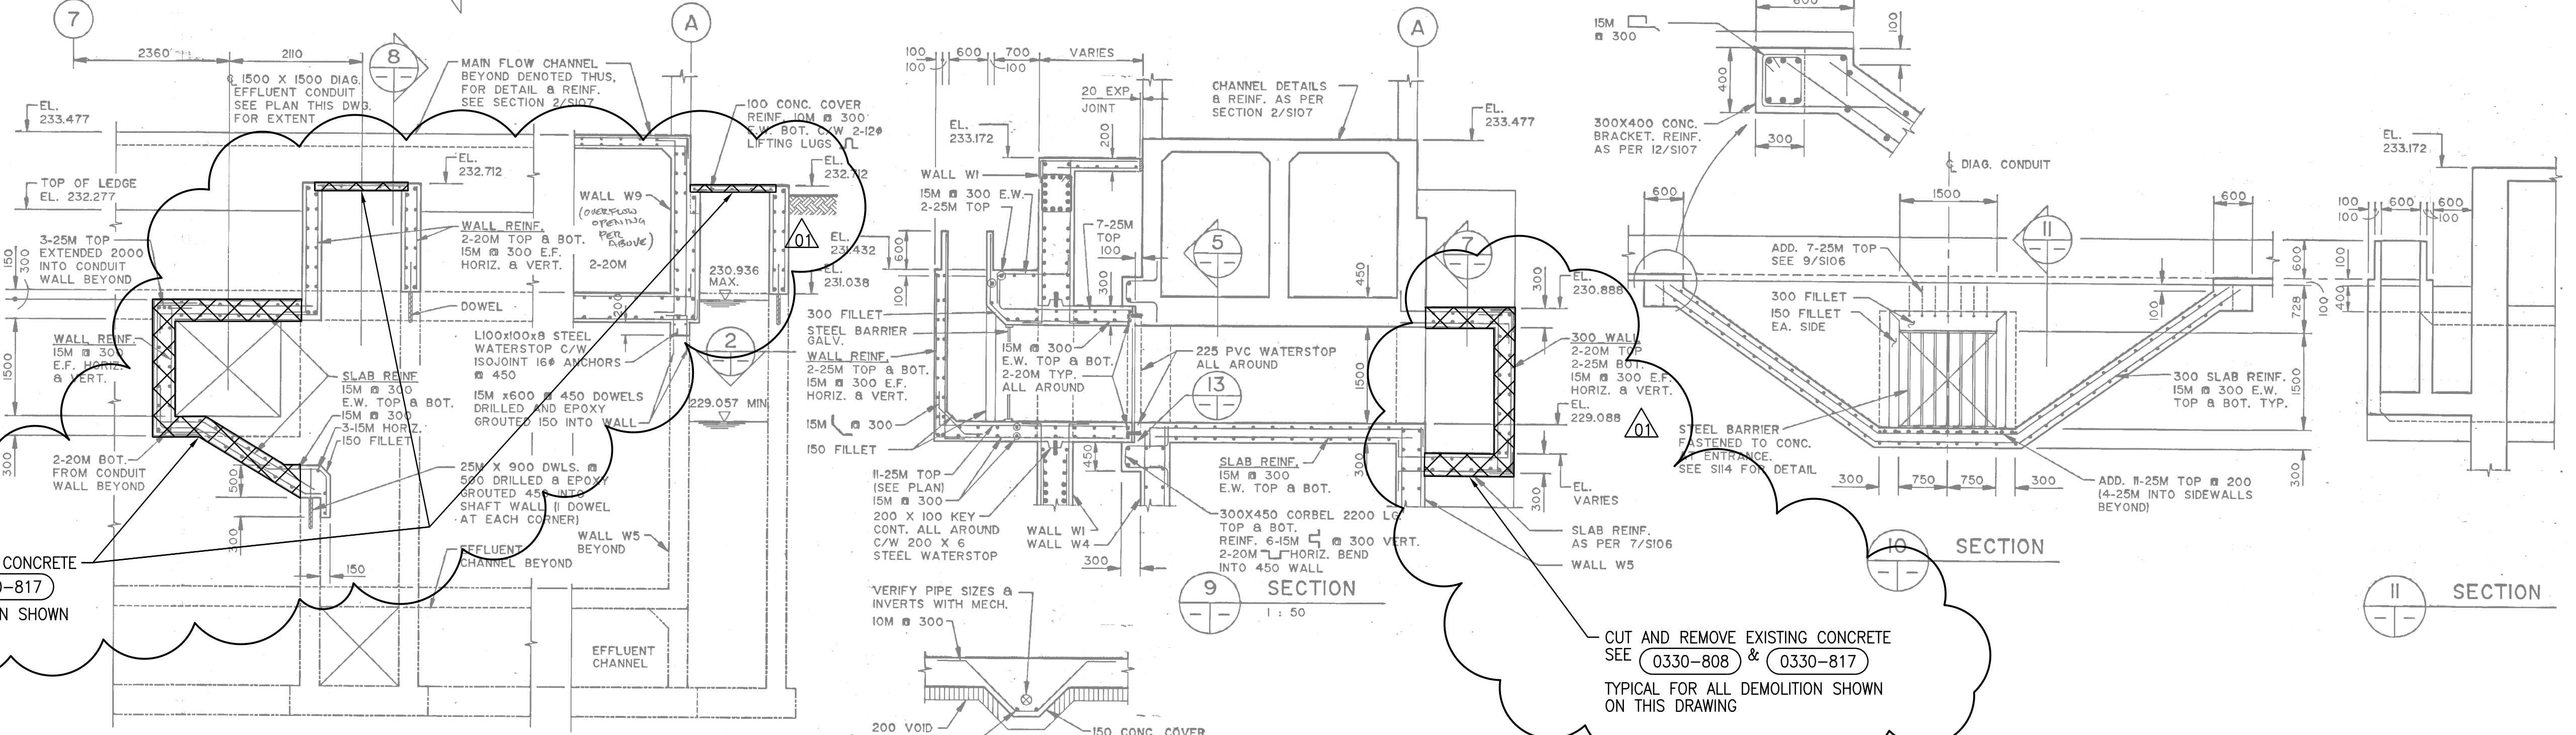

SECTION 7

SECTION 8

SECTION 9

SECTION 10

SECTION 11

SECTION 12

SECTION 13

CUT AND REMOVE EXISTING CONCRETE SEE 0330-808 & 0330-817 TYPICAL FOR ALL DEMOLITION SHOWN ON THIS DRAWING

CUT AND REMOVE EXISTING CONCRETE SEE 0330-808 & 0330-817 TYPICAL FOR ALL DEMOLITION SHOWN ON THIS DRAWING

- NOTES:
- FOR NEW CONSTRUCTION SEE DRAWING 1-0102-SGAD-S010, 1-0102-SGAD-S022 AND 1-0102-SGAD-S032.
 - REFER TO GENERAL DEMOLITION NOTES DRAWING 4-0102-DGAD-A001.



NO.	REVISIONS	DATE	DESIGN	CHECK
01	ISSUED FOR ADD. 2 - B.O. 899-2015	02/2016	G.O. J.C.	
00	ISSUED FOR TENDER - B.O. 899-2015	01/2016	G.G. J.C.	

CH2MHILL
SNC-LAVALIN

DESIGNED BY: E. LUI
DRAWN BY: G. GERMAN
SCALE: NTS

CHECKED BY: R. PARIKH
APPROVED BY: H.T. FREIHAMMER
ISSUED FOR CONSTRUCTION BY: T. TURZAK
DATE: 2016/01/26
DATE: 2016/01/29

CONSULTANT NO.: 474248



SEALING ARCHITECT OR ENGINEER ACCEPTS RESPONSIBILITY ONLY FOR AREAS IDENTIFIED BY CLOUDING ON THIS DRAWING.

NOTE: THIS DRAWING SUPERSEDES DRAWING SEP-412

THE CITY OF WINNIPEG
Winnipeg WATER AND WASTE DEPARTMENT

SOUTH END WATER POLLUTION CONTROL CENTRE
SEWPPC UPGRADING/EXPANSION PROJECT
STRUCTURAL
SECONDARY CLARIFIERS - CONCRETE AND CMU REMOVALS TIE-INS (1)

CITY DRAWING NUMBER: 1-0102-SGAD-S053
SHEET: 001
REV: 01
SIZE: A1

