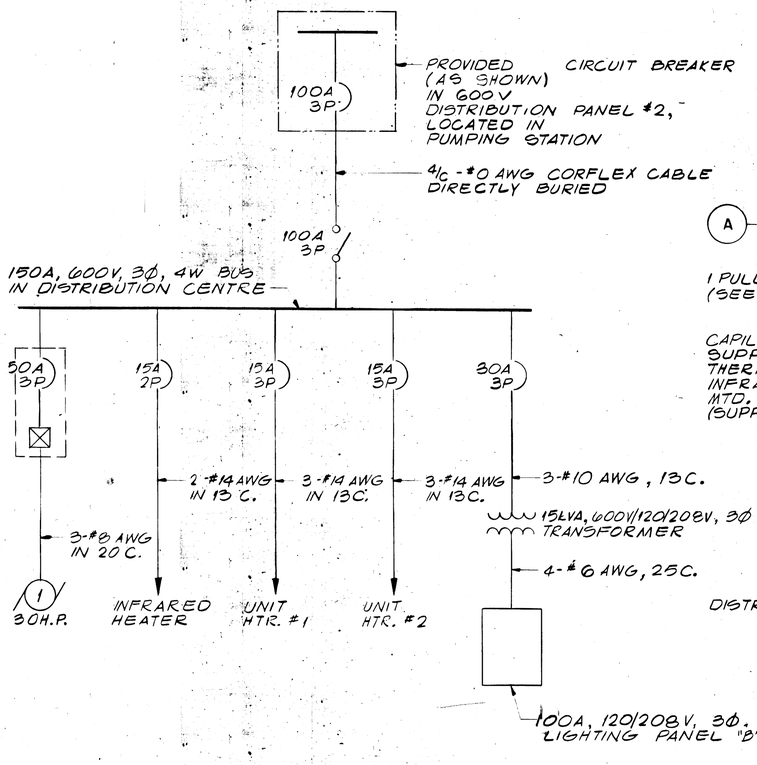

SINGLE LINE DISTRIBUTION DIAGRAM

N.T.S.

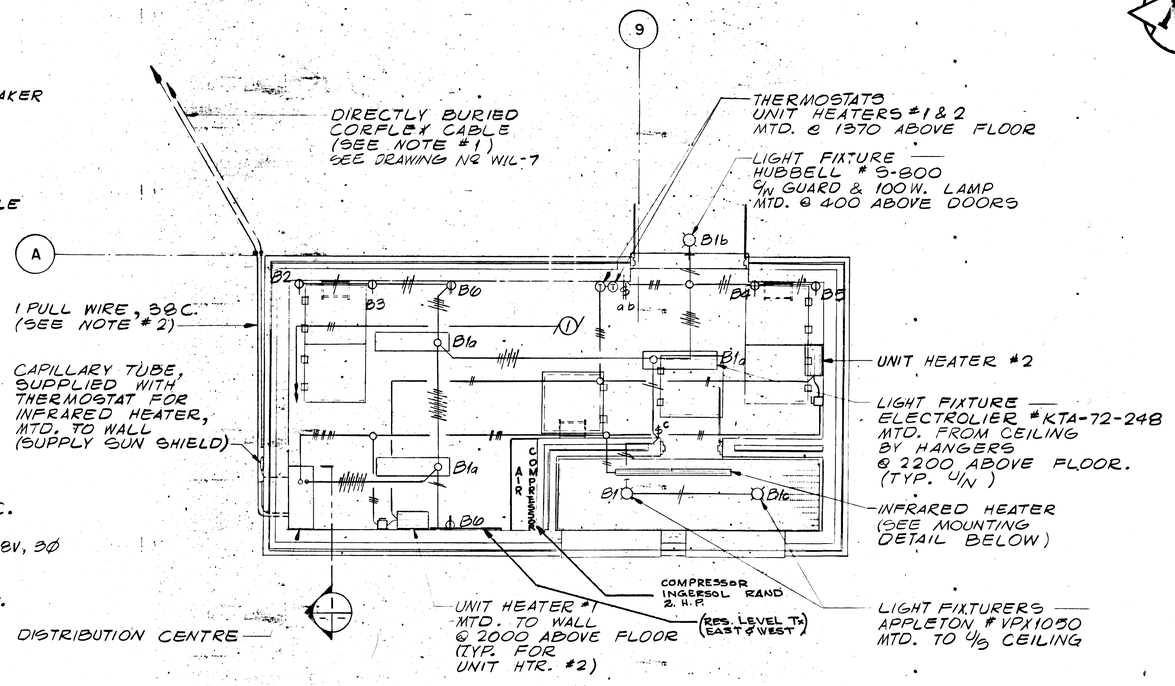

ELECTRICAL LAYOUT OF ENTRANCE HOUSING

1:50

NOTES

1. CONDUIT SLEEVE (SIZED TO SUIT) FOR CORFLEX CABLE WHERE CABLE RUNS ABOVE GRADE.
2. ONE JUNCTION BOX IN PUMPING STATION & ONE PULL WIRE IN 38C. FROM JUNCTION BOX TO DISTRIBUTION CENTRE. CAPPED CONDUIT INSIDE DISTRIBUTION CENTRE. (CONDUIT FOR FUTURE CONTROLS BY OWNER).

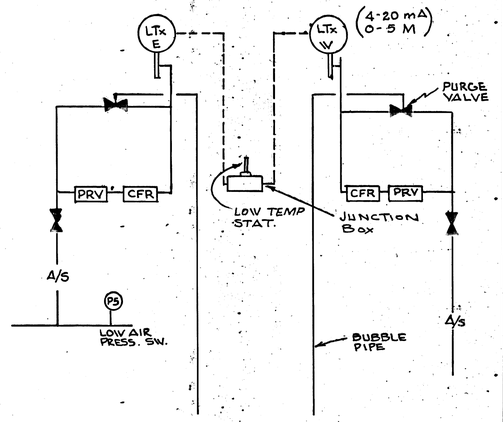

NB. - 100% = OVERFLOW ELEVATION 235
0% = ELEVATION 230

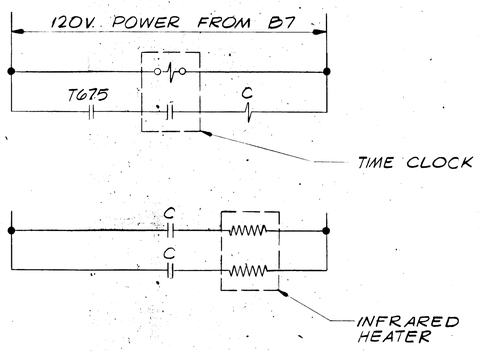

INFRARED HEATER CONTROL SCHEMATIC

N.T.S.

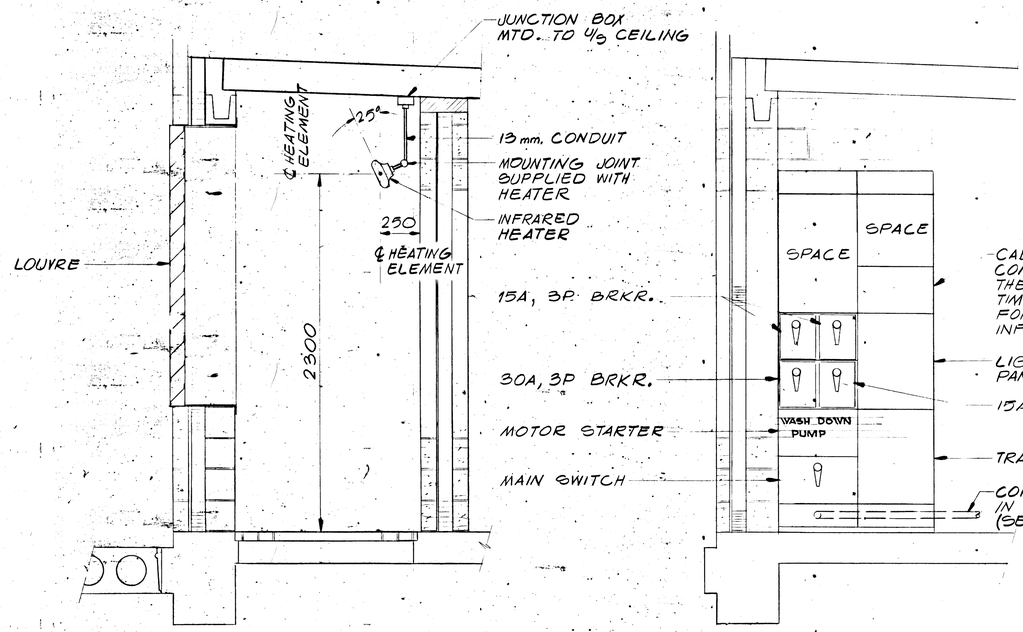

INFRARED HEATER MOUNTING DETAIL

1:20

SECTION 1

1:20

BID OPPORTUNITY No. 930-2015
ISSUED FOR ADDENDUM No. 3
2015-12-15

METRIC NOTES

WHOLE NUMBERS IND. MILLIMETRES
DECIMALIZED EXPRESSIONS IND. METRES

NO.	REVISIONS	DATE	APP.
3	REVISED TO DATE	82-11-24	M.S.
2	RECORD DRAWING	DEC/81	EEL
1	CONST. RECORD CHANGES	AUG/81	EEL

ENGINEER'S SEAL — 30/3/82

Underwood McLellan Ltd. (the uma group)
Consulting Engineers and Planners

DESIGNED BY: E.M.R. A.G.L. | DRAWN BY: A.G.L.
CHECKED BY: | DATE: MARCH 20, 1980
APPROVED BY: | DATE: 20/3/80

THE CITY OF WINNIPEG
WORKS & OPERATIONS DEPARTMENT
WATERWORKS, WASTE & DISPOSAL DIVISION

WILKES AVENUE RESERVOIR RECONSTRUCTION
ELECTRICAL

RELEASED FOR CONSTRUCTION: DATE: 20/03/80
SCALE: AS NOTED
DRAWING NO: WIL-44

RECORD DRAWING
MICROFILMED JUN -- 1982

Job #RE 10298