


Issue / rev.

#	date	issued notes
1	2017.01.10	ISSUED FOR ADDENDUM 4
0	2016.12.08	ISSUED FOR CONSTRUCTION

professional seals

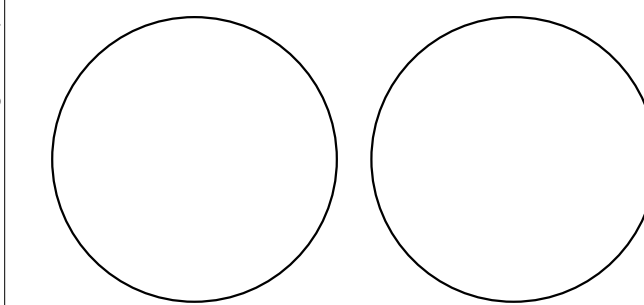

project information

SEVEN OAKS POOL RENOVATION & ADDITION

444 ADSUM DRIVE
 WINNIPEG, MB
 CANADA

client

CITY OF WINNIPEG
 4TH FLOOR - 85 KING ST.
 WINNIPEG, MB


drawing information

Sections & Details

drawn by: M.B. / AVP
 approved by: FDW

scale: As indicated
 date issued: 2017.01.10
 proj. #: W14432
 rev. #: 1

This drawing must not be scaled. The contractor shall verify all dimensions and other data on site prior to commencement of work. All discrepancies, errors, and omissions are to be reported to the architect. Drawings and specifications, as instruments or service, are the property of the architect, and when made, must bear his name. All prints to be returned to the architect on request.

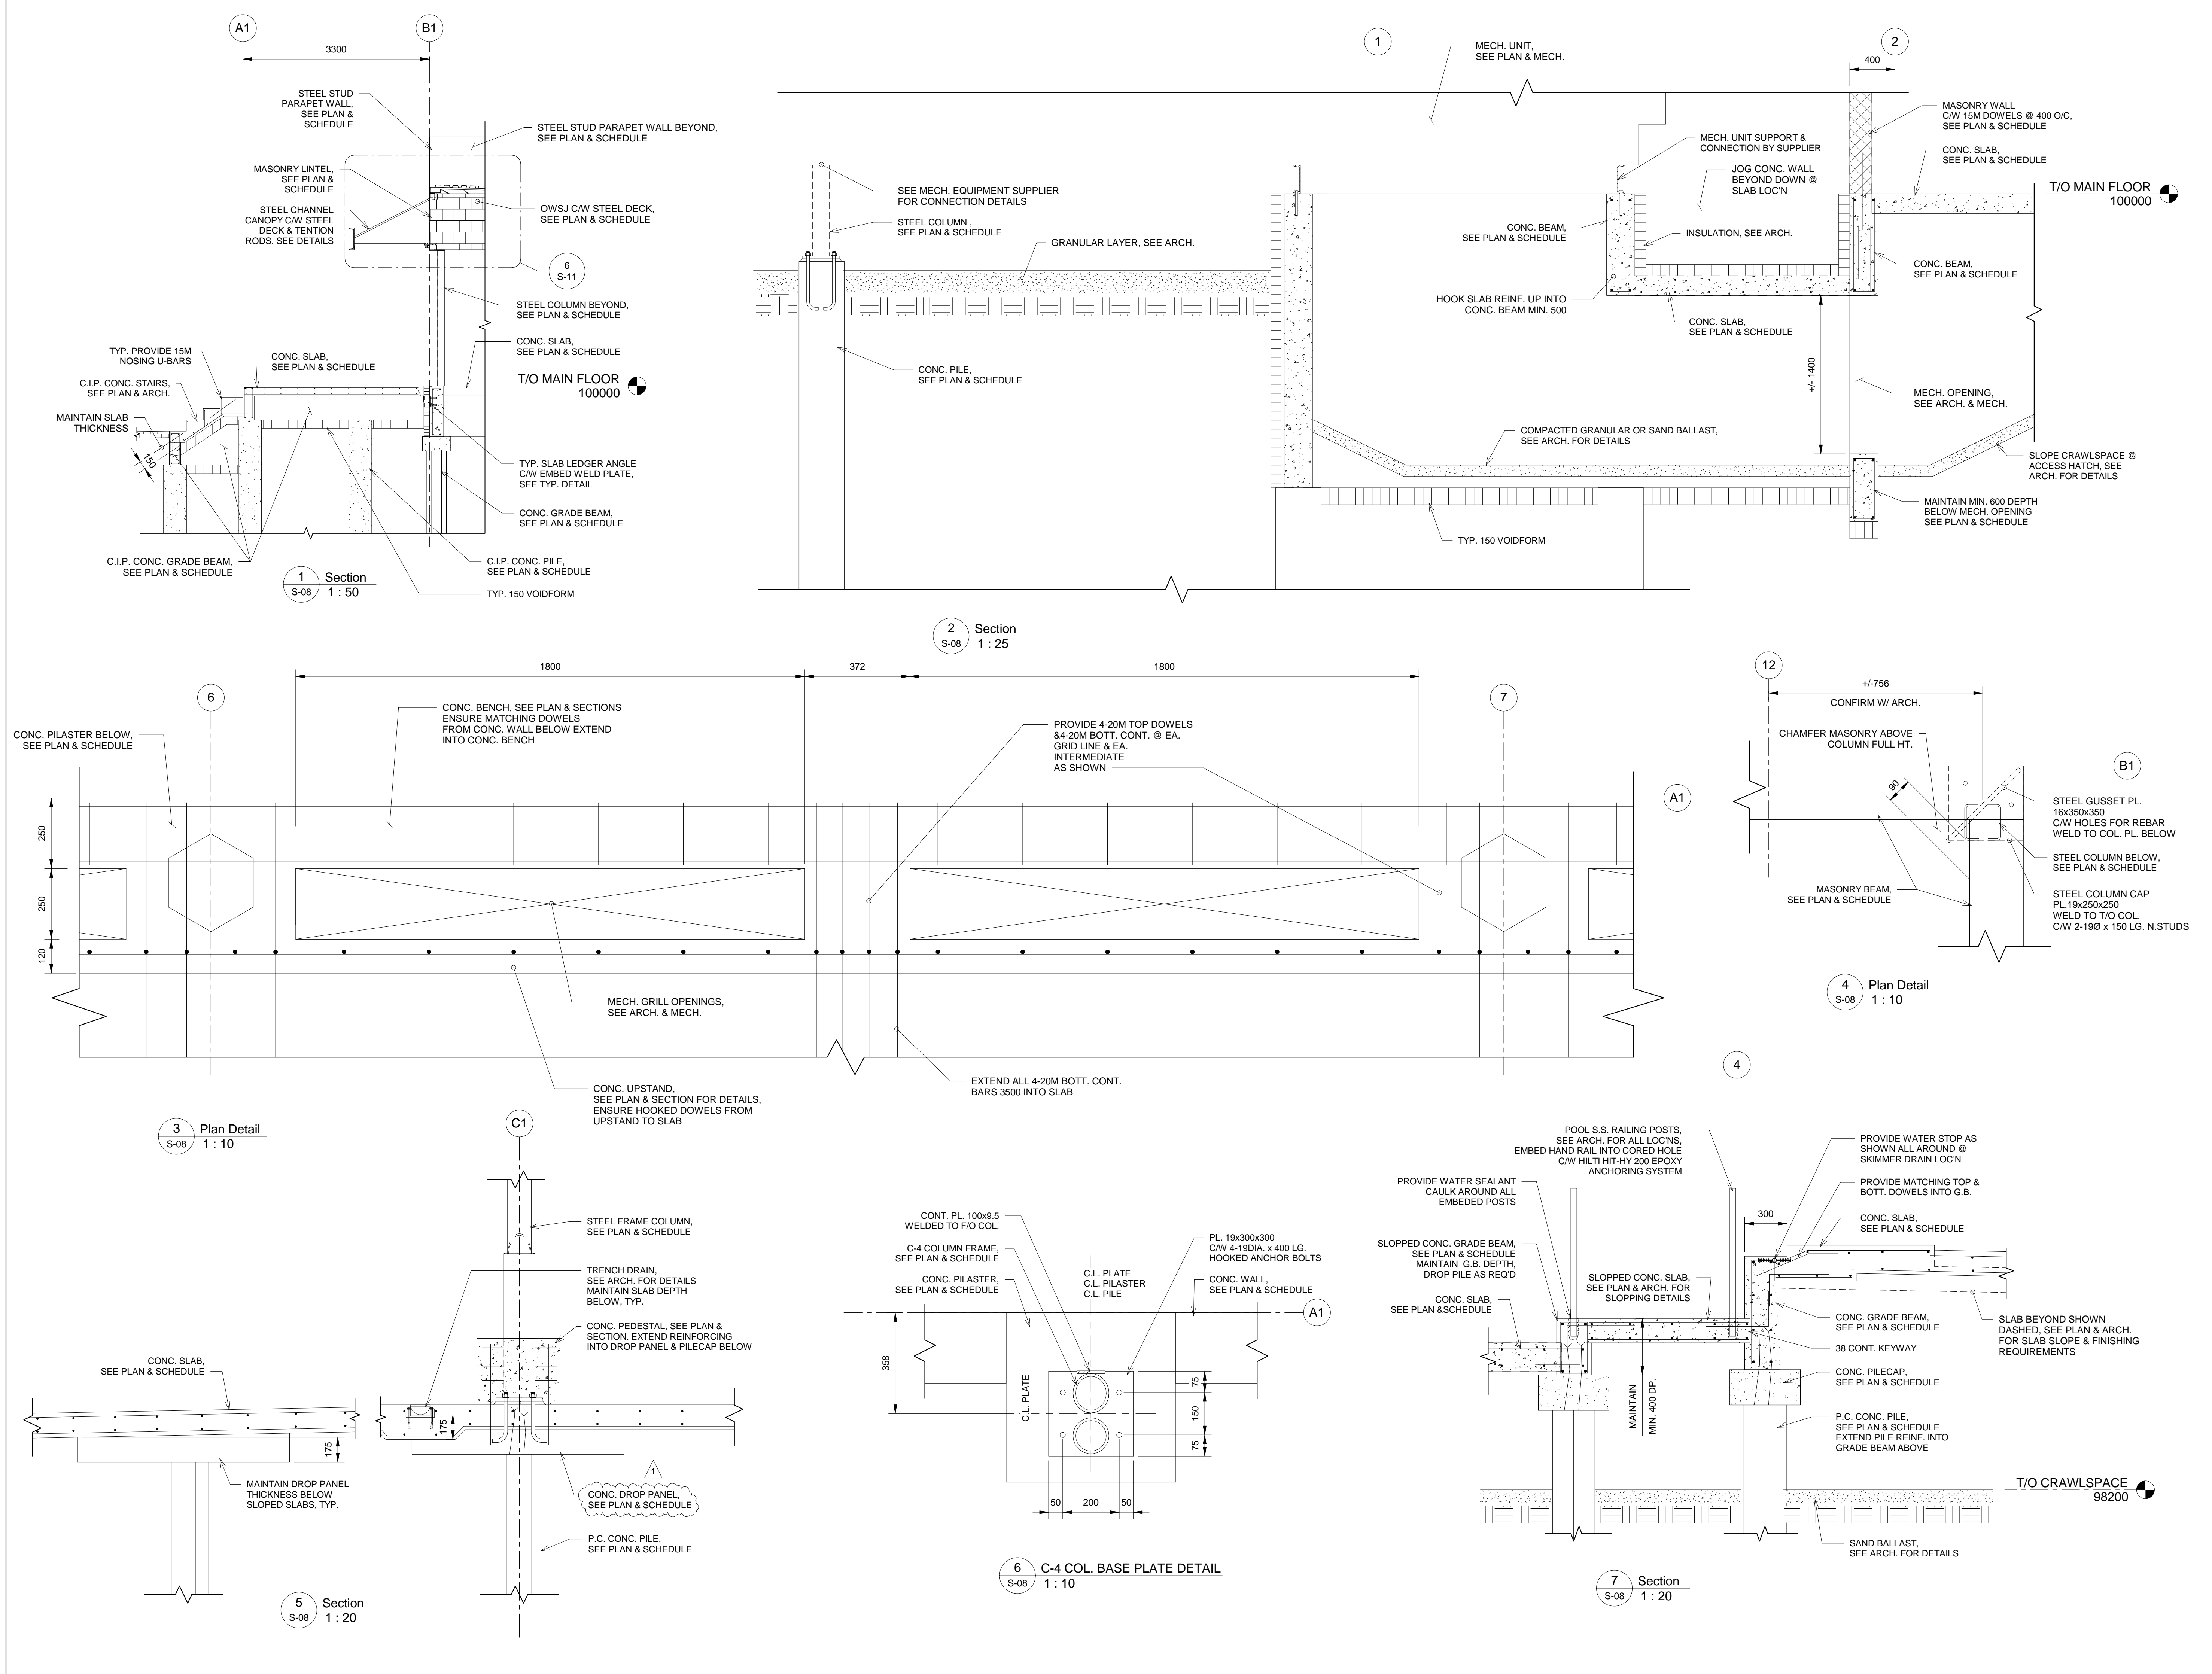

A1 B1
 3300

1 2
 MECH. UNIT, SEE PLAN & MECH.
 400

1 Section
 S-08 1 : 50

2 Section
 S-08 1 : 25

3 Plan Detail
 S-08 1 : 10

4 Plan Detail
 S-08 1 : 10

5 Section
 S-08 1 : 20

6 C-4 COL. BASE PLATE DETAIL
 S-08 1 : 10

7 Section
 S-08 1 : 20

T/O MAIN FLOOR
 100000

T/O CRAWLSPACE
 98200