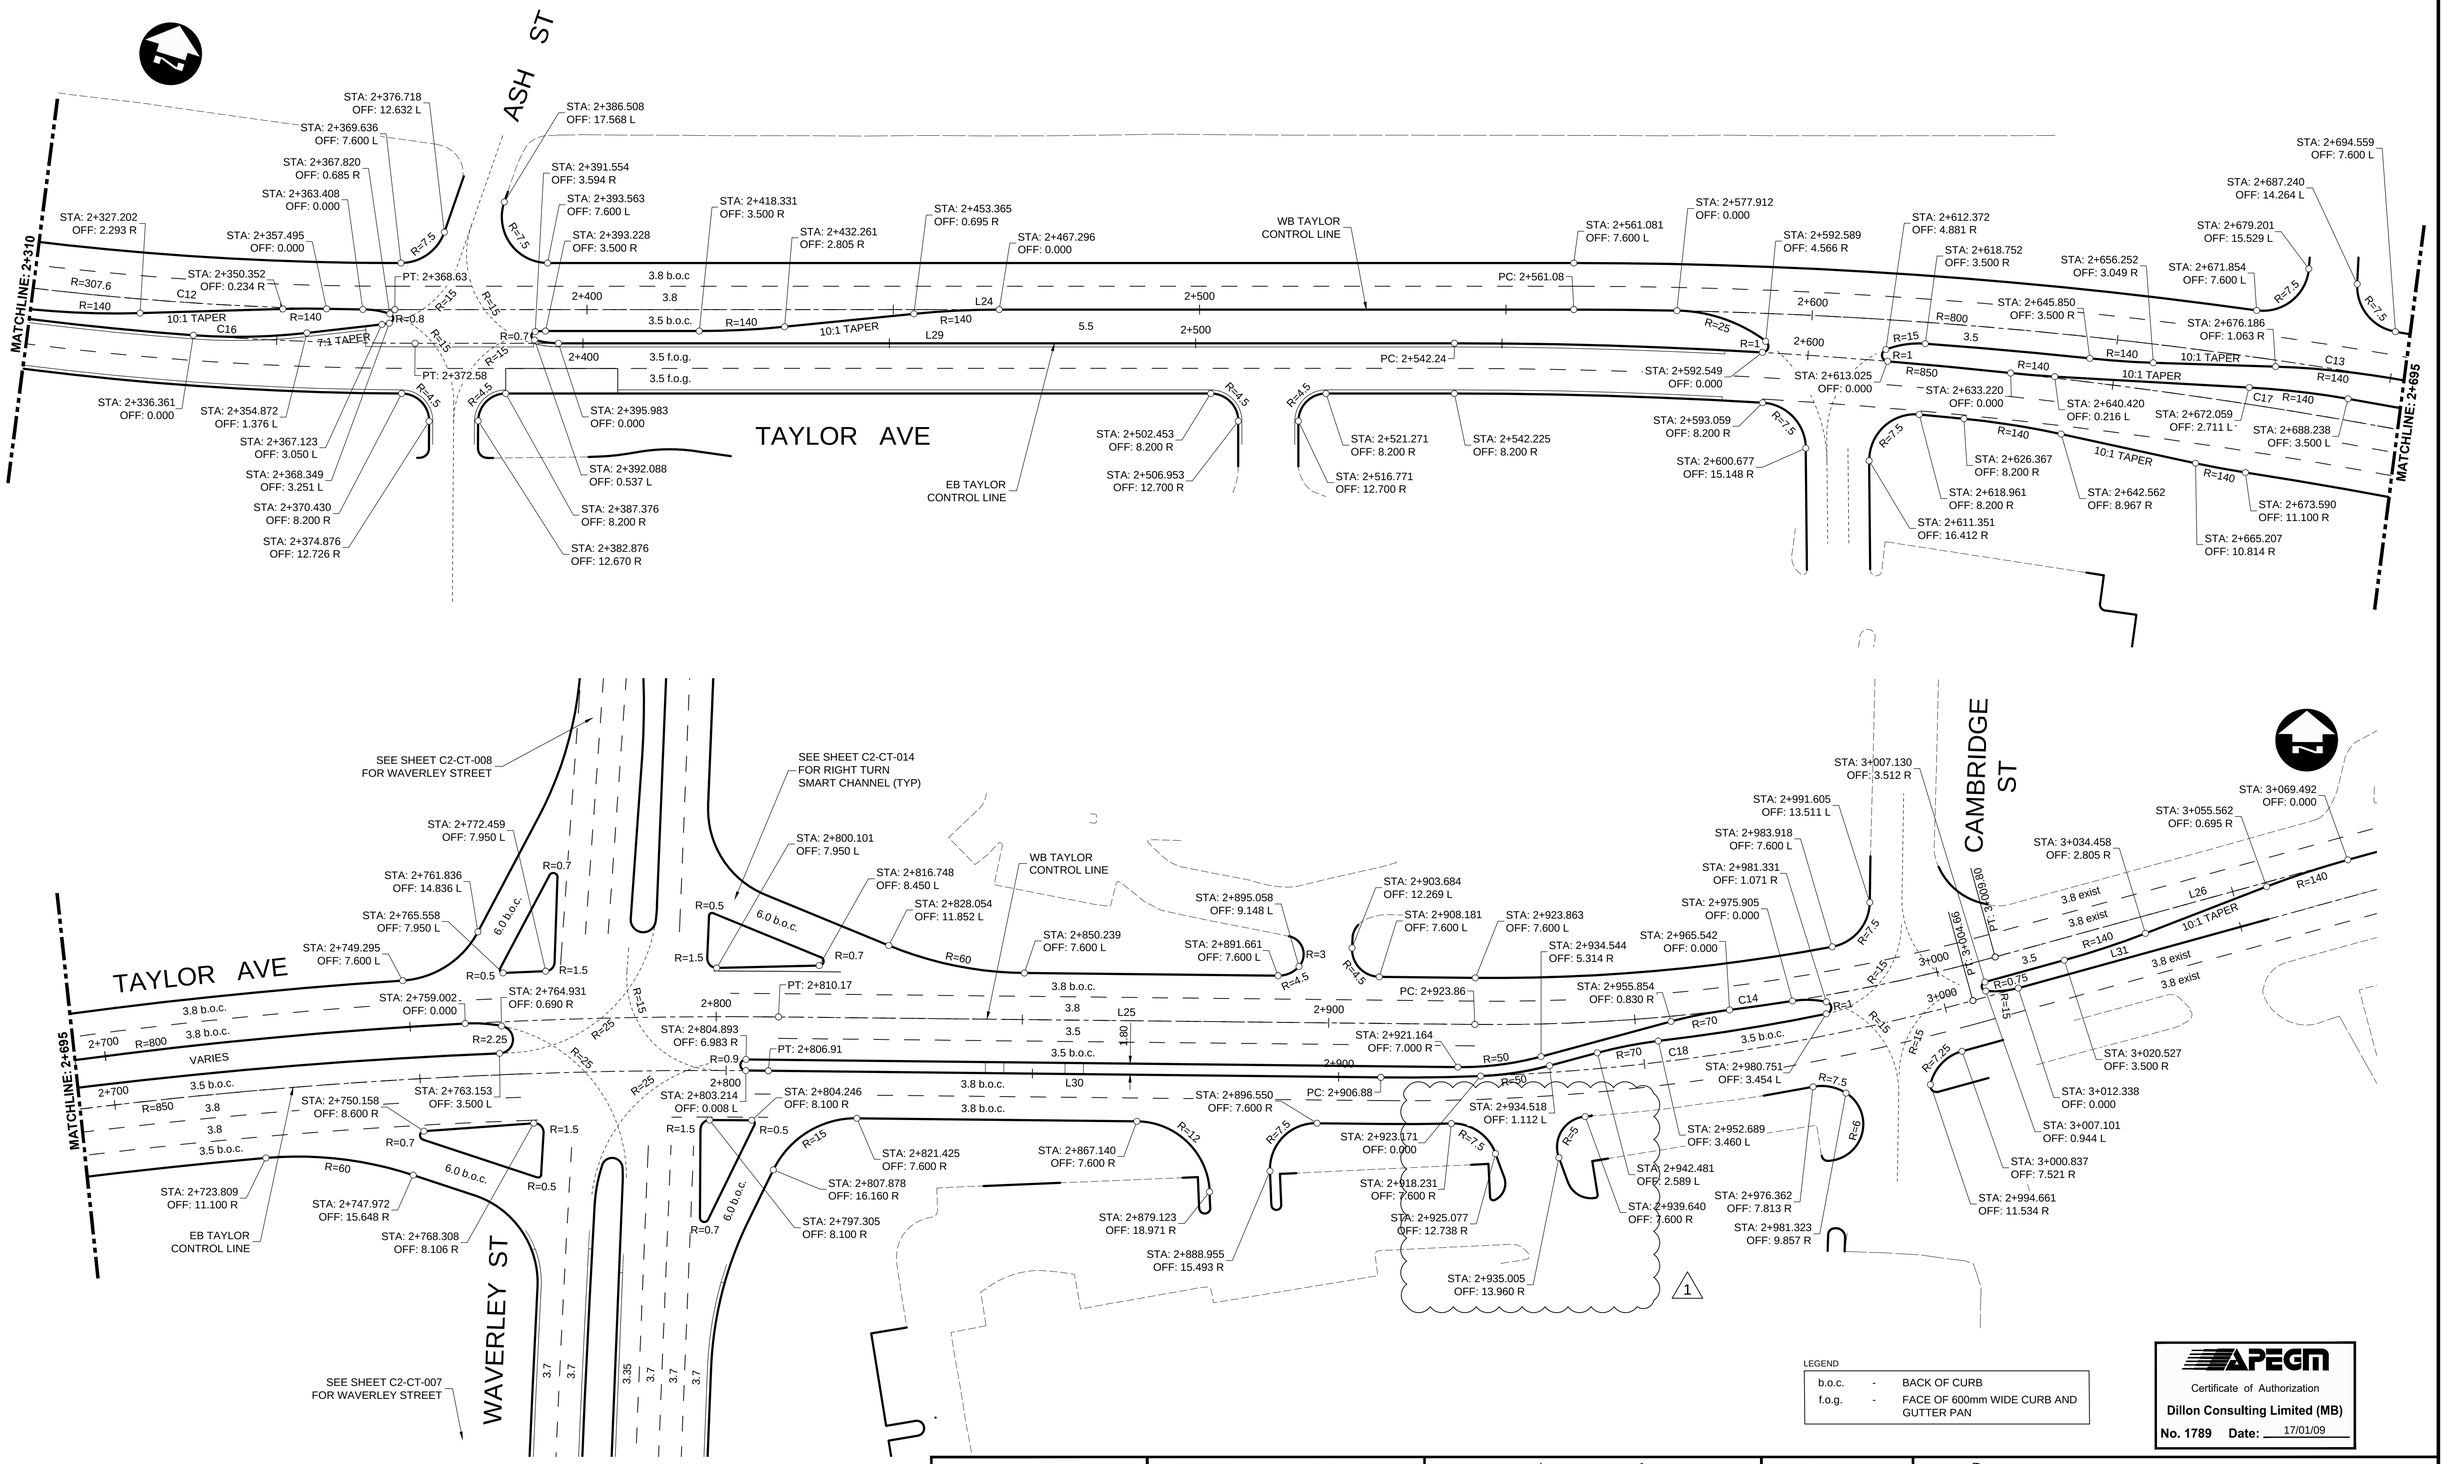

LEGEND

b.o.c.	-	BACK OF CURB
f.o.g.	-	FACE OF 600mm WIDE CURB AND GUTTER PAN

APEGM
Certificate of Authorization
Dillon Consulting Limited (MB)
No. 1789 Date: 17/01/09

UNDERGROUND STRUCTURES

SUPV. U/G STRUCTURES — DATE

LOCATION OF UNDERGROUND STRUCTURES AS SHOWN ARE BASED ON THE BEST INFORMATION AVAILABLE, BUT NO GUARANTEE IS GIVEN THAT ALL EXISTING UTILITIES ARE SHOWN OR THAT THE GIVEN LOCATIONS ARE EXACT. CONFIRMATION OF EXISTENCE AND EXACT LOCATION OF ALL SERVICES MUST BE OBTAINED FROM THE INDIVIDUAL UTILITIES BEFORE PROCEEDING WITH CONSTRUCTION.

B.M. ELEV. — SEE SHEET C2–CT–007 FOR CONTROL POINT INFORMATION

NO.	REVISIONS	DATE	BY
1	ADDENDUM #1	17/01/25	DBW
0	ISSUED FOR TENDER	17/01/09	DBW

DILLON CONSULTING

DESIGNED BY	RTP	CHECKED BY	DBW
DRAWN BY	TJH	APPROVED BY	DBW
HOR. SCALE	1:500	RELEASED FOR CONSTRUCTION	
VERTICAL			
DATE		DATE	

ENGINEER'S SEAL — PROVINCE OF MANITOBA — D.B. WIEBE — Member 22480 — REGISTERED PROFESSIONAL ENGINEER

CONSULTANT PROJECT NUMBER: 16-3353

Winnipeg

THE CITY OF WINNIPEG
PUBLIC WORKS DEPARTMENT

WAVERLEY STREET UNDERPASS AT CN MILE 3.89 RIVERS SUB
CONTRACT 2: UNDERPASS STRUCTURES, RAILWORKS, ROADWORKS, LAND DRAINAGE SEWER, PUMPING STATION AND LANDSCAPING WORKS

CONTROL LINE GEOMETRY
TAYLOR AVENUE (2 OF 2)

CITY DRAWING NUMBER: U-239-2016-C2-CT-011
SHEET 011 OF 081
CONSULTANT DRAWING NUMBER: C2-CT-011

G:\CAD\163353\Technical Workspace\Engineering\Drawings and Figures\Roadworks\Contract\163353-C2-CON-CT-CONTROL-LINE-GEOMETRY.dwg