
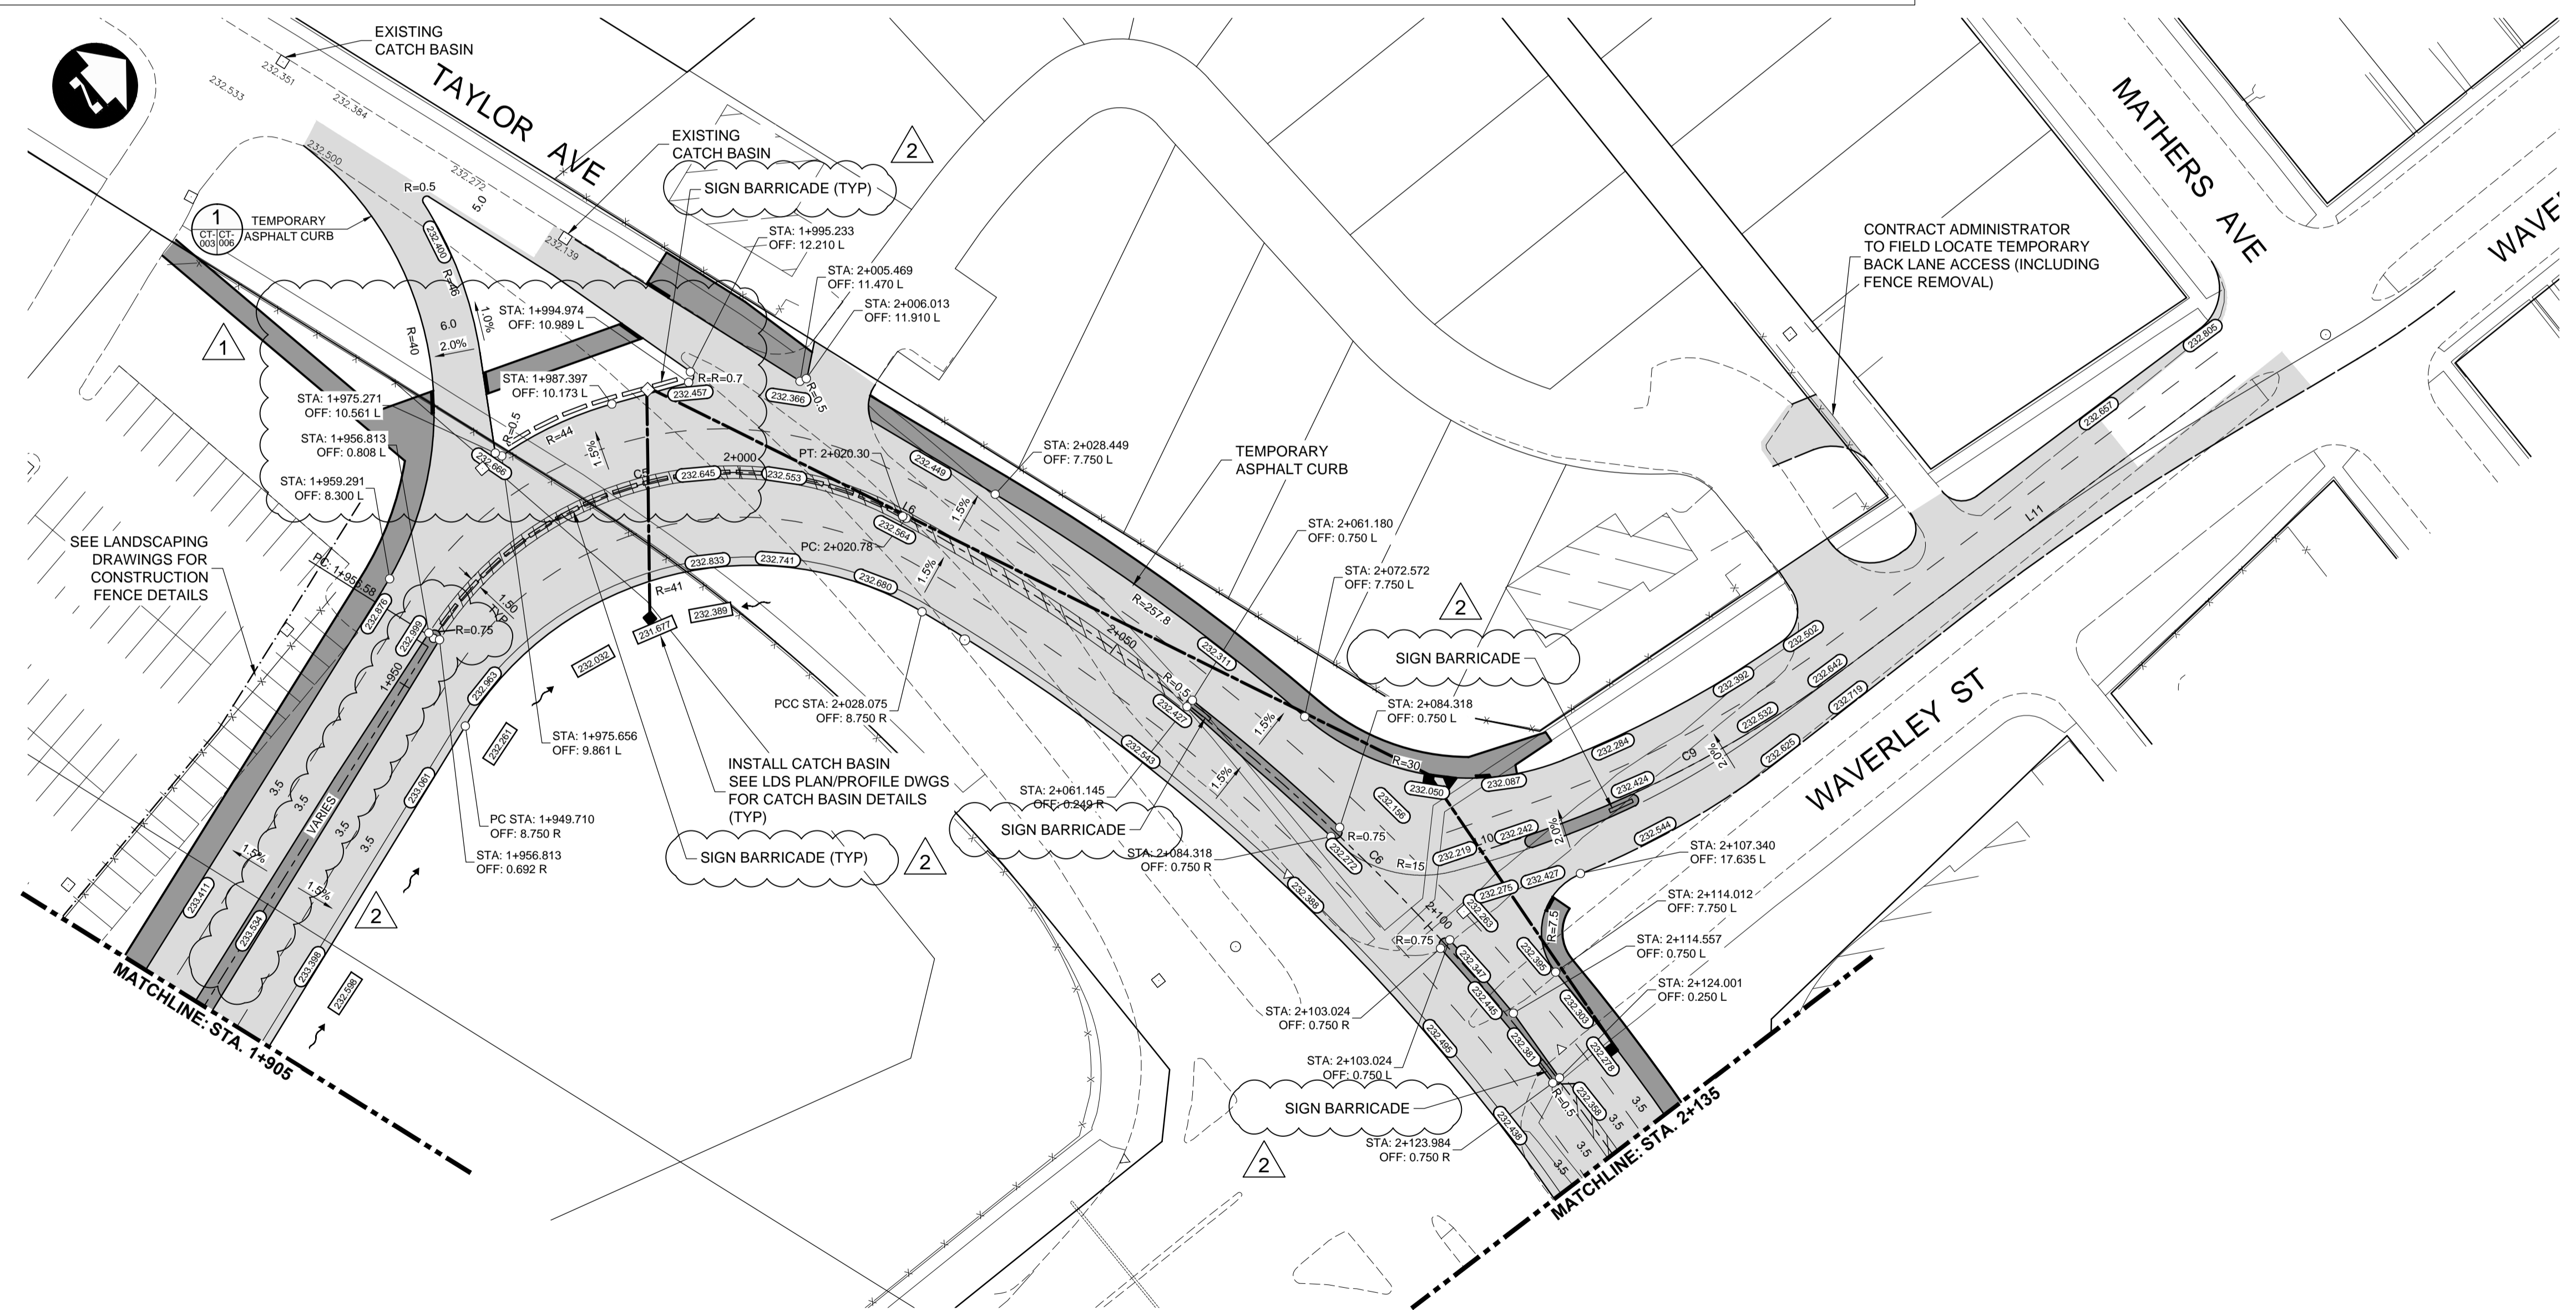


GENERAL DETOUR CONSTRUCTION NOTES:

- SEE CONSTRUCTION STAGING SHEETS FOR DETOUR SECTIONS (GE-025 TO GE-052)

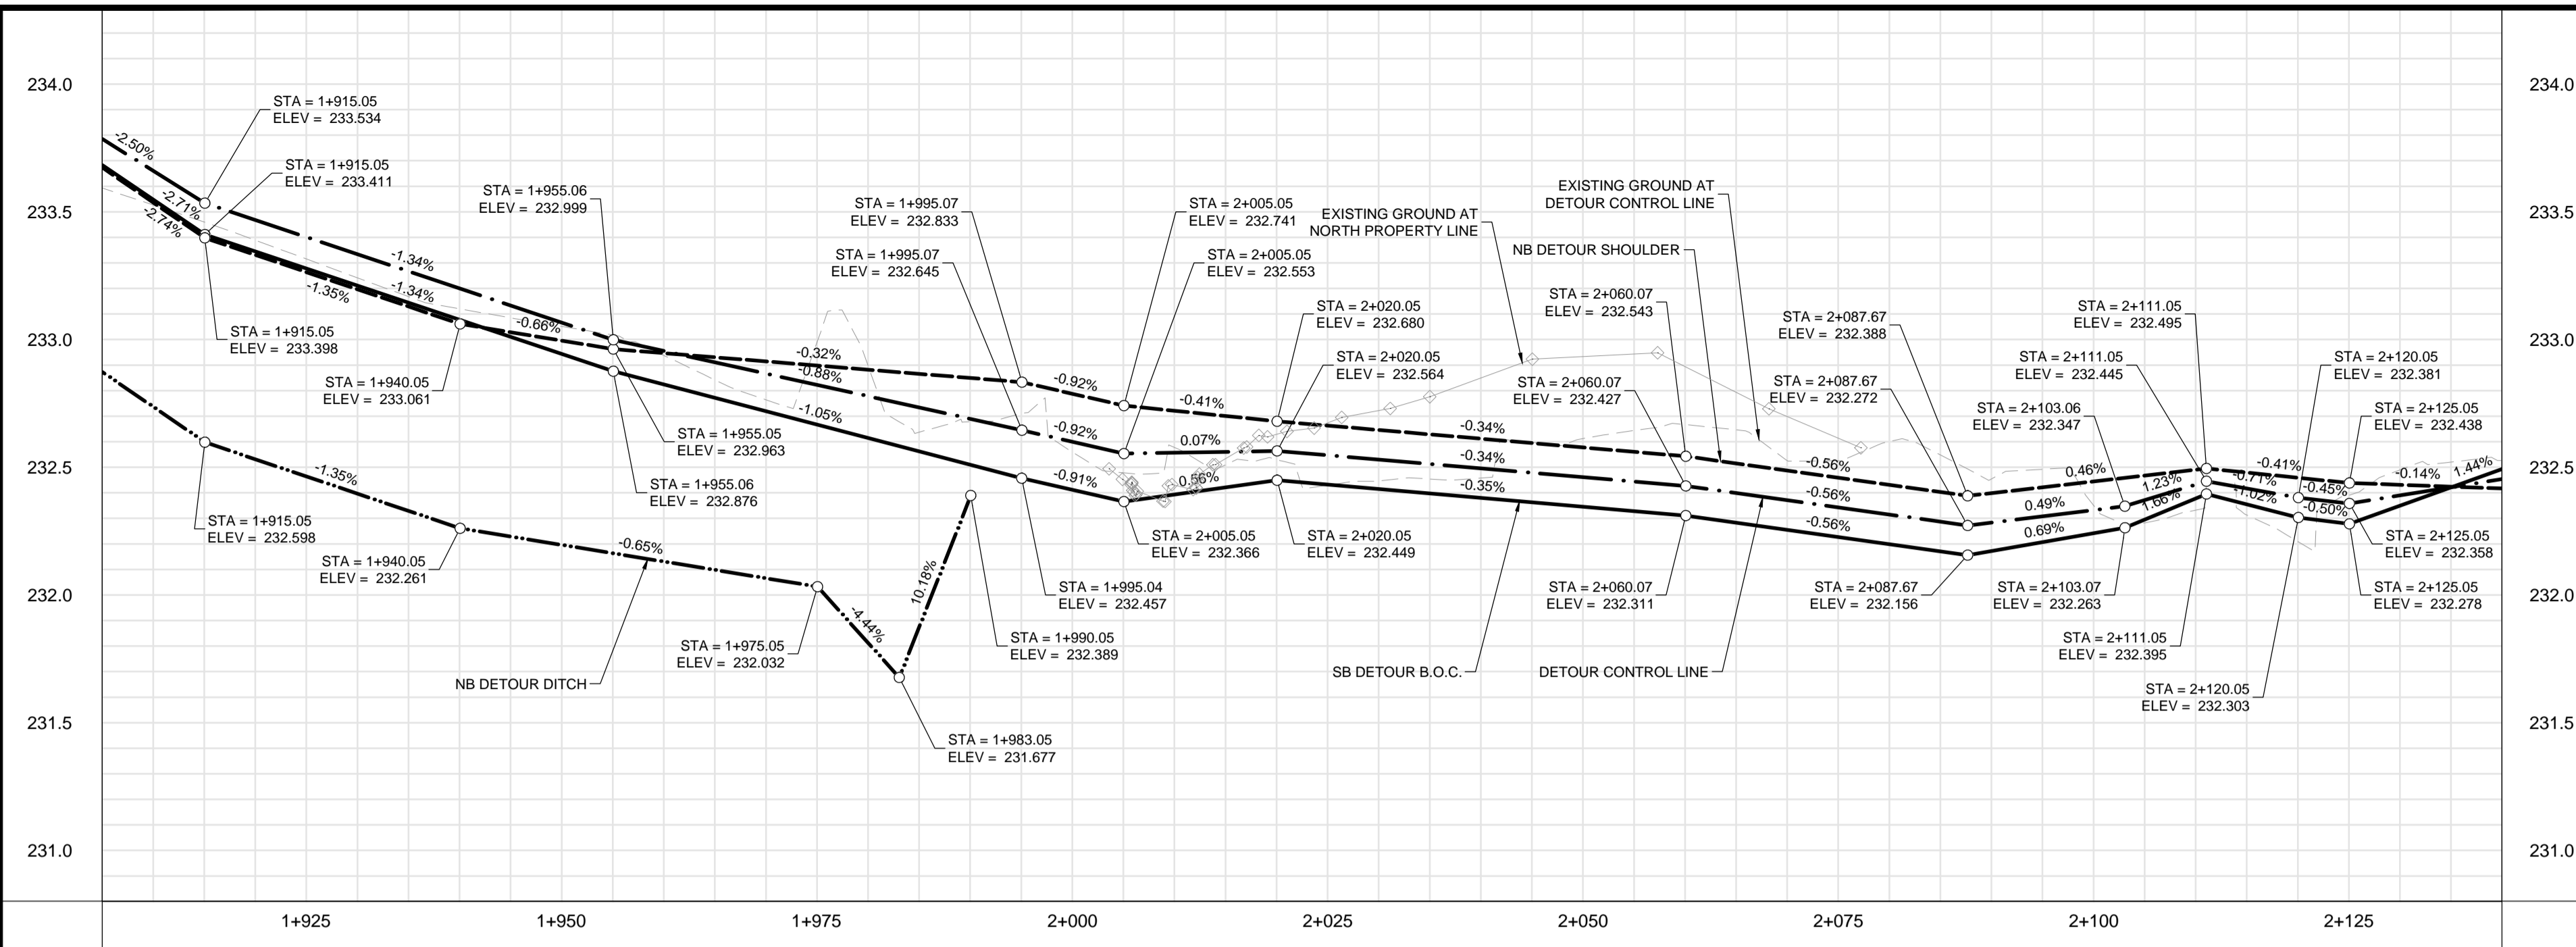

METRIC

WHOLE NUMBERS INDICATE MILLIMETRES
DECIMALIZED NUMBERS INDICATE METRES

WARNING

- IF POWER EQUIPMENT OR EXPLOSIVES ARE TO BE USED FOR EXCAVATION ON THIS PROJECT THE CONTRACTOR MUST:
- NOTIFY THE GAS COMPANY OF THE PROPOSED LOCATION OF EXCAVATION.
 - TAKE PRECAUTION TO AVOID DAMAGE TO GAS COMPANY INSTALLATIONS SEE PROVINCIAL REGULATION 210/72 FOR DETAILS.
 - OBTAIN EXCAVATION PERMITS PRIOR TO CONSTRUCTION.



G:\CAD\163353\Technical\Workspac\Engineering\Drawings and Figures\Roadworks\Contract\163353-C2-CON-CT-PLAN-PROFILE-DETOUR.dwg

150 WM	WATERMAIN	150 WM	CONCRETE	150 WM	WATERMAIN	150 WM	WATERMAIN	B.M. ELEV.	SEE SHEET C2-CT-007 FOR CONTROL POINT INFORMATION		DESIGNED BY	RTP	CHECKED BY	DBW			THE CITY OF WINNIPEG PUBLIC WORKS DEPARTMENT	WAVERLEY STREET UNDERPASS AT CN MILE 3.89 RIVERS SUB CONTRACT 2: UNDERPASS STRUCTURES, RAILWORKS, ROADWORKS, LAND DRAINAGE SEWER, PUMPING STATION AND LANDSCAPING WORKS	CITY DRAWING NUMBER U-239-2016-C2-CT-003
300 LDS	LAND DRAINAGE SEWER	300 LDS	ASPHALT	300 LDS	LAND DRAINAGE SEWER	300 LDS	LAND DRAINAGE SEWER				NO. REVISIONS	DATE	BY	DATE					
250 WWS	WASTE WATER SEWER	250 WWS	PLANING	250 WWS	WASTE WATER SEWER	250 WWS	WASTE WATER SEWER	2	17/02/15	DBW	17/01/25	DBW	17/01/09	DBW	16-3353	DETOUR PLAN-PROFILE - STA. 1+905 TO 2+135	CONSULTANT DRAWING NUMBER	C2-CT-003	
300 LVS	LAND DRAINAGE SEWER	300 LVS	SIDEWALK	300 LVS	LAND DRAINAGE SEWER	300 LVS	LAND DRAINAGE SEWER	1	17/01/25	DBW	17/01/25	DBW	17/01/09	DBW	16-3353	DETOUR PLAN-PROFILE - STA. 1+905 TO 2+135	CONSULTANT DRAWING NUMBER	C2-CT-003	
250 WWS	WASTE WATER SEWER	250 WWS	PAVING STONES	250 WWS	WASTE WATER SEWER	250 WWS	WASTE WATER SEWER	0	ISSUED FOR TENDER	17/01/09	DBW	17/01/09	DBW	17/01/09	16-3353	DETOUR PLAN-PROFILE - STA. 1+905 TO 2+135	CONSULTANT DRAWING NUMBER	C2-CT-003	
300 LVS	LAND DRAINAGE SEWER	300 LVS	PARTIAL DEPTH REPAIR	300 LVS	LAND DRAINAGE SEWER	300 LVS	LAND DRAINAGE SEWER								16-3353	DETOUR PLAN-PROFILE - STA. 1+905 TO 2+135	CONSULTANT DRAWING NUMBER	C2-CT-003	
250 WWS	WASTE WATER SEWER	250 WWS	PROPERTY LINE	250 WWS	WASTE WATER SEWER	250 WWS	WASTE WATER SEWER								16-3353	DETOUR PLAN-PROFILE - STA. 1+905 TO 2+135	CONSULTANT DRAWING NUMBER	C2-CT-003	
HYDRO	HYDRO	HYDRO	DRAINAGE ARROW	HYDRO	HYDRO	HYDRO	HYDRO								16-3353	DETOUR PLAN-PROFILE - STA. 1+905 TO 2+135	CONSULTANT DRAWING NUMBER	C2-CT-003	
M.T.S.	M.T.S.	M.T.S.	CURB RAMP (SD-229C)	M.T.S.	M.T.S.	M.T.S.	M.T.S.								16-3353	DETOUR PLAN-PROFILE - STA. 1+905 TO 2+135	CONSULTANT DRAWING NUMBER	C2-CT-003	
100 GAS	GAS	100 GAS	DETECTABLE WARNING SURFACE TILE (SD-229AA)	100 GAS	GAS	100 GAS	GAS								16-3353	DETOUR PLAN-PROFILE - STA. 1+905 TO 2+135	CONSULTANT DRAWING NUMBER	C2-CT-003	
EXISTING	LEGEND-PLAN	PROPOSED	EXISTING	LEGEND-PLAN	PROPOSED	EXISTING	LEGEND-PROFILE								16-3353	DETOUR PLAN-PROFILE - STA. 1+905 TO 2+135	CONSULTANT DRAWING NUMBER	C2-CT-003	