



1 | NORTH ELEVATION

BB-201 SCALE: 1 : 50

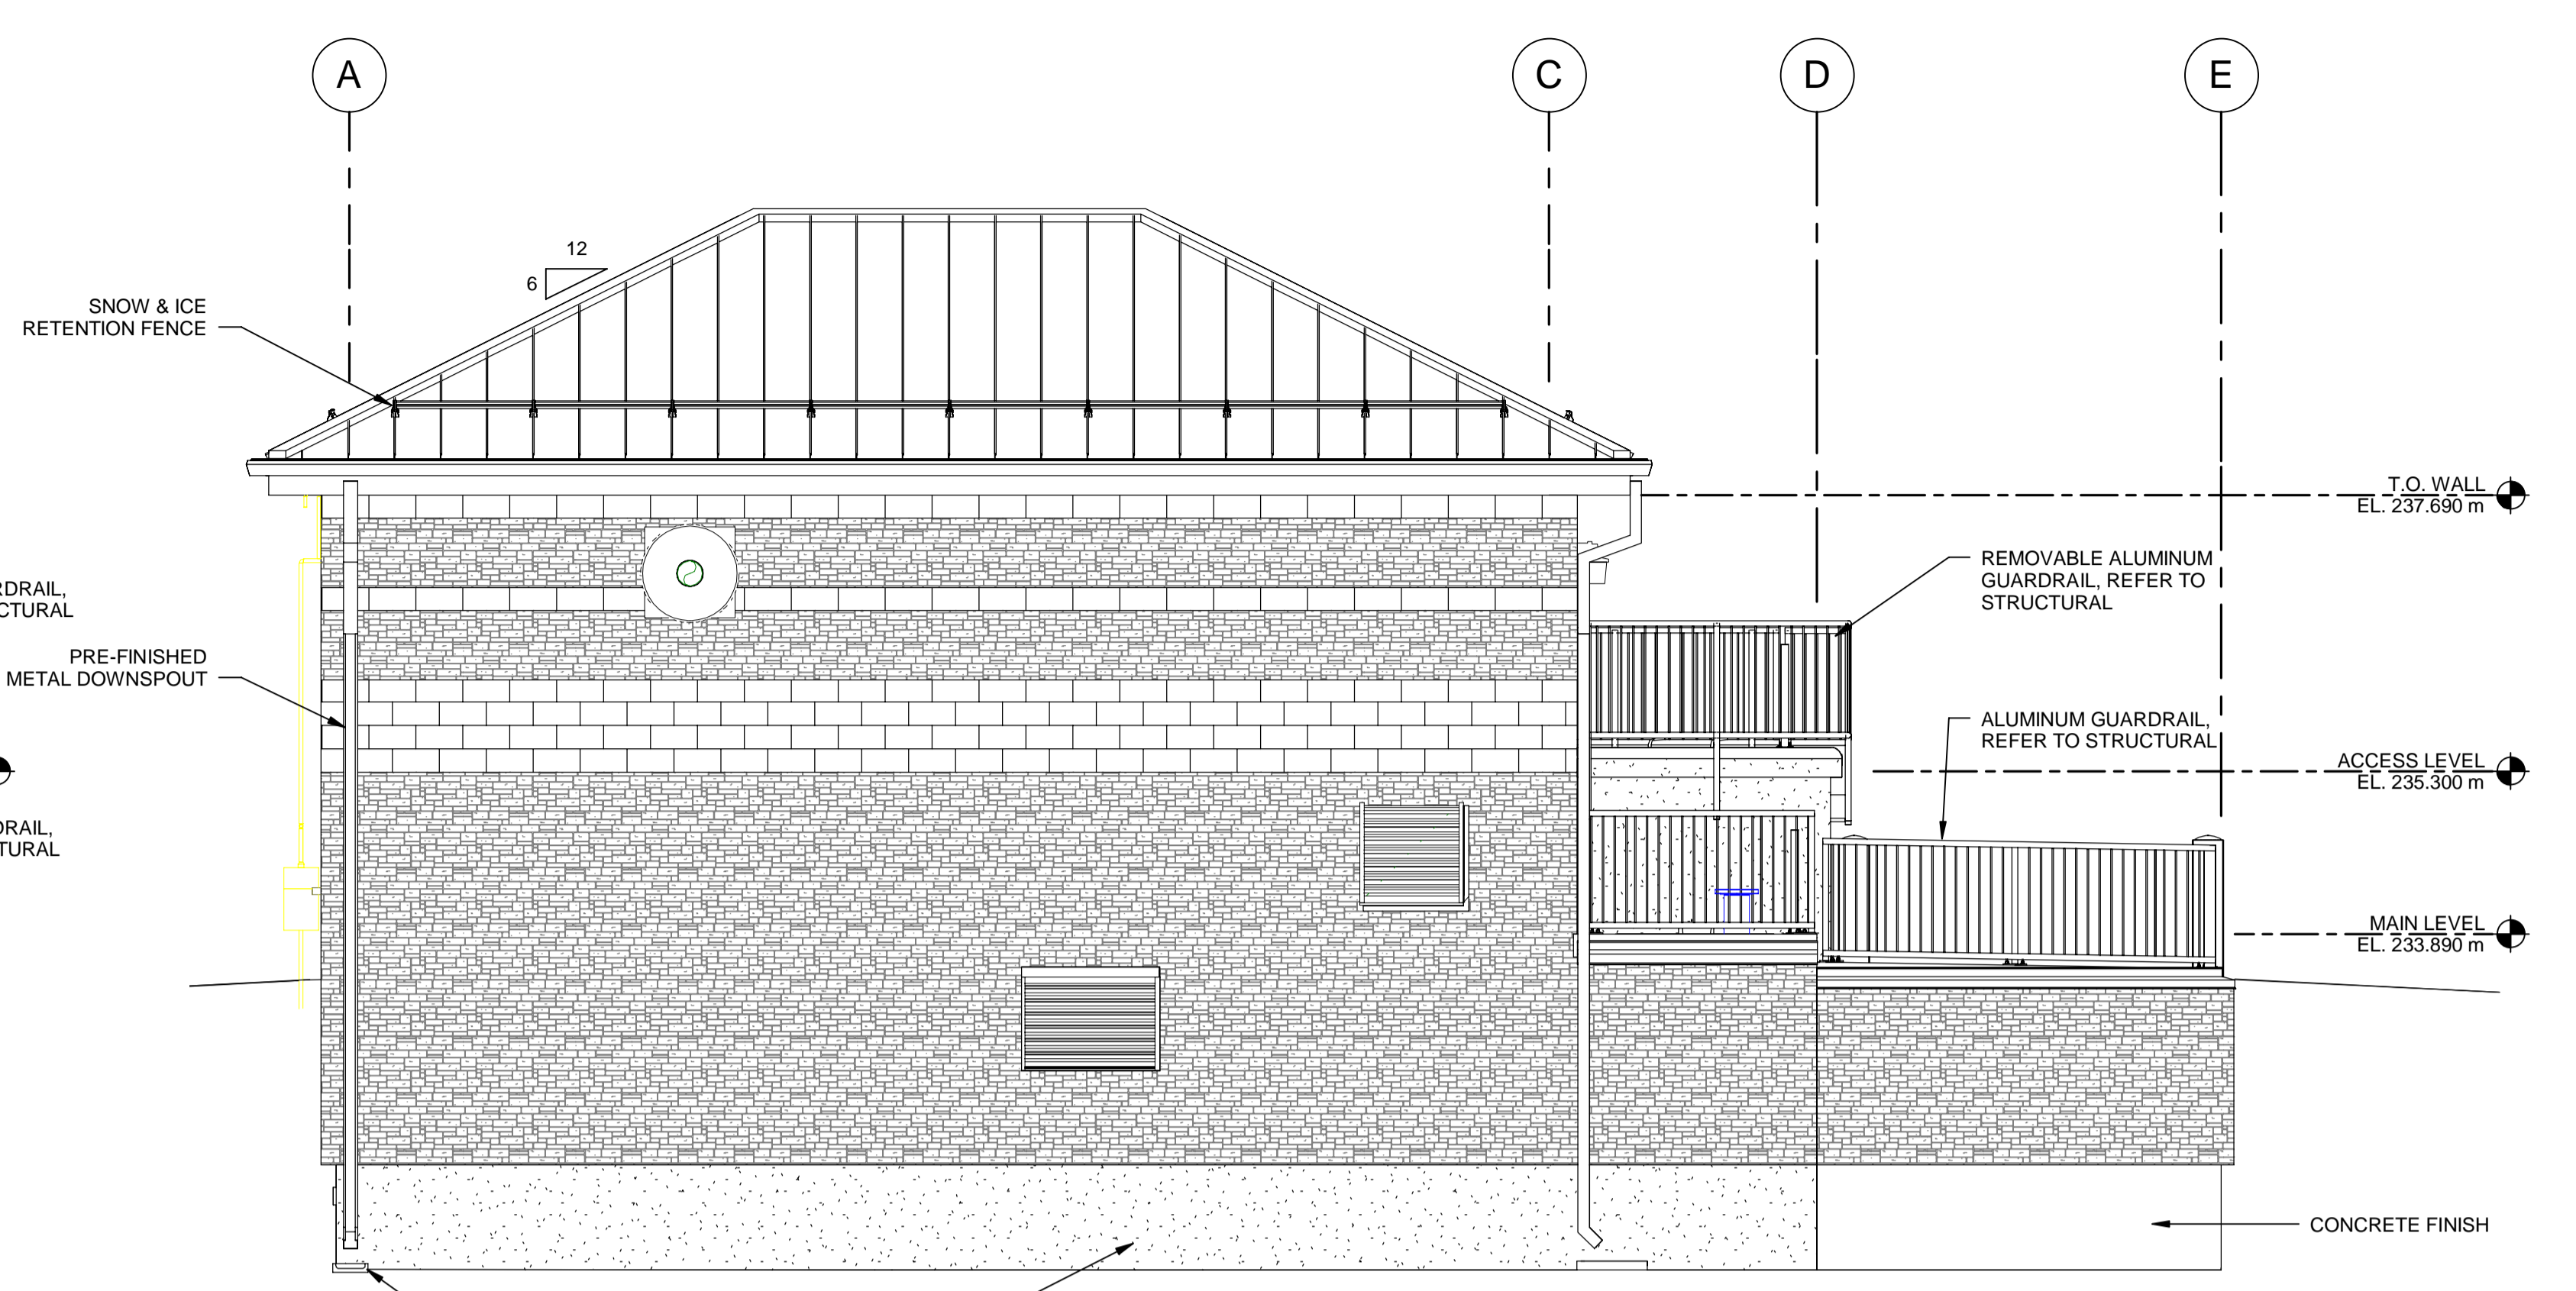


2 | EAST ELEVATION

BB-201 SCALE: 1 : 50

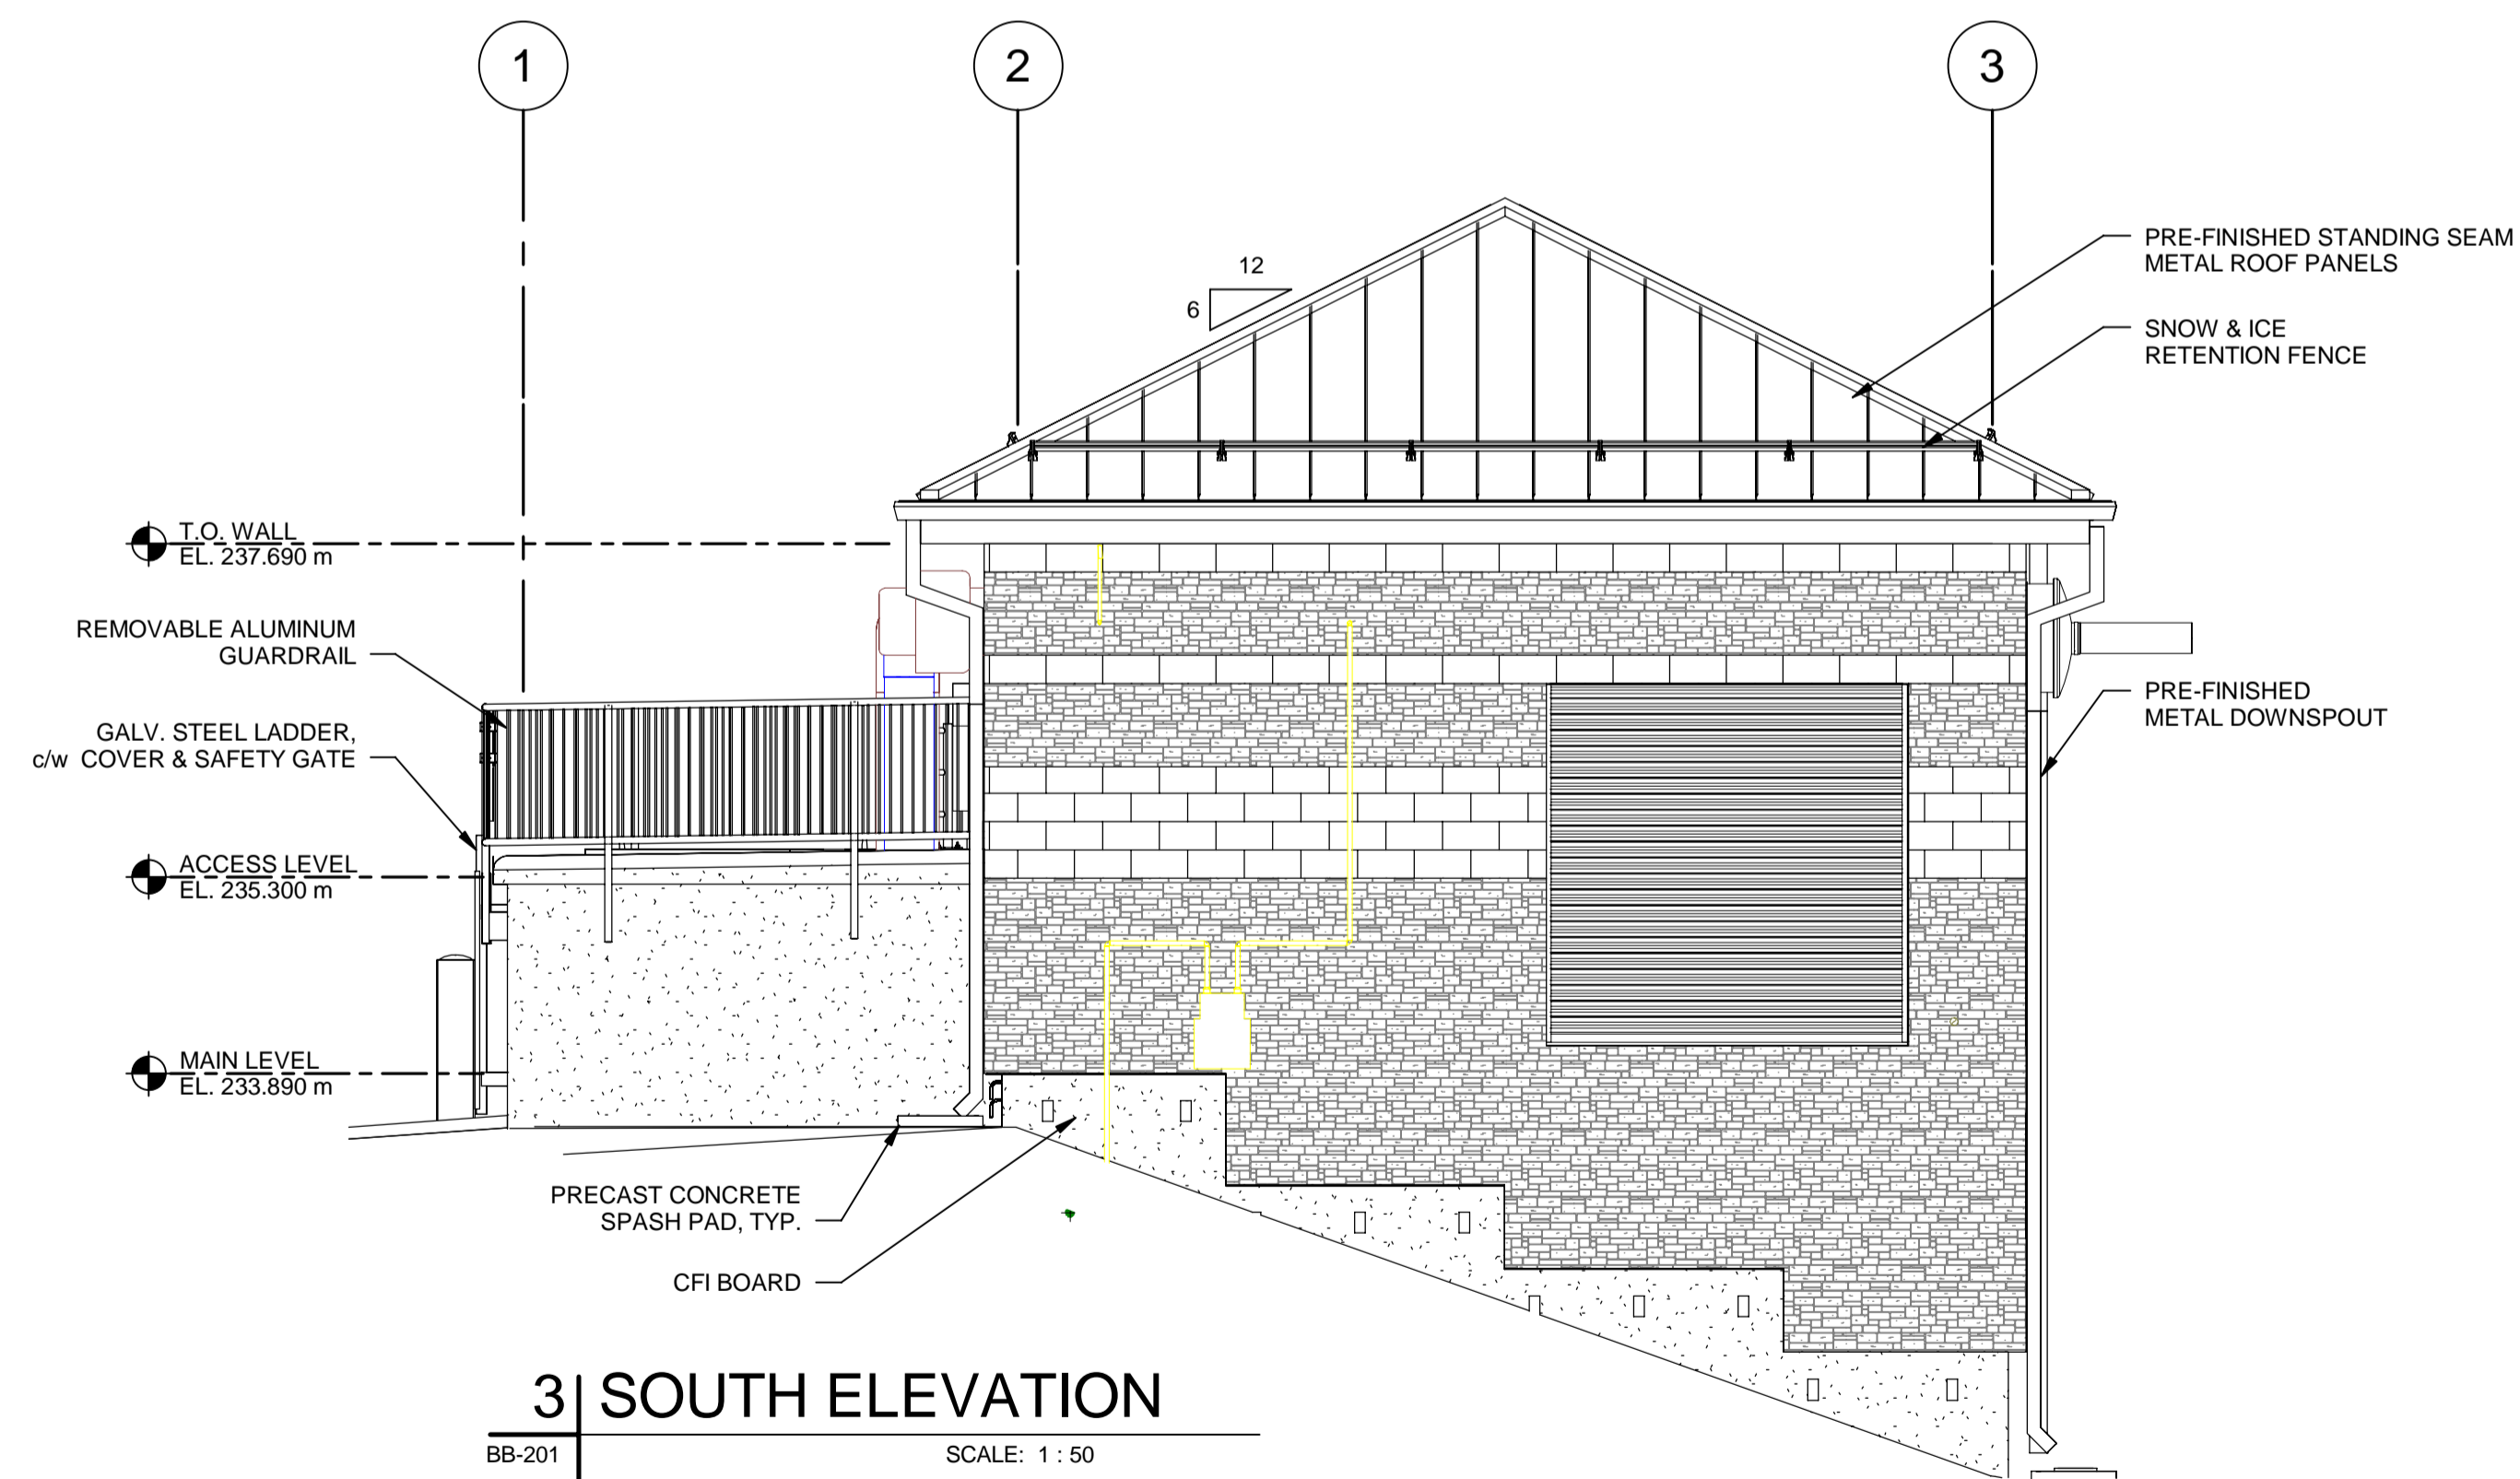

3 | SOUTH ELEVATION

BB-201 SCALE: 1 : 50

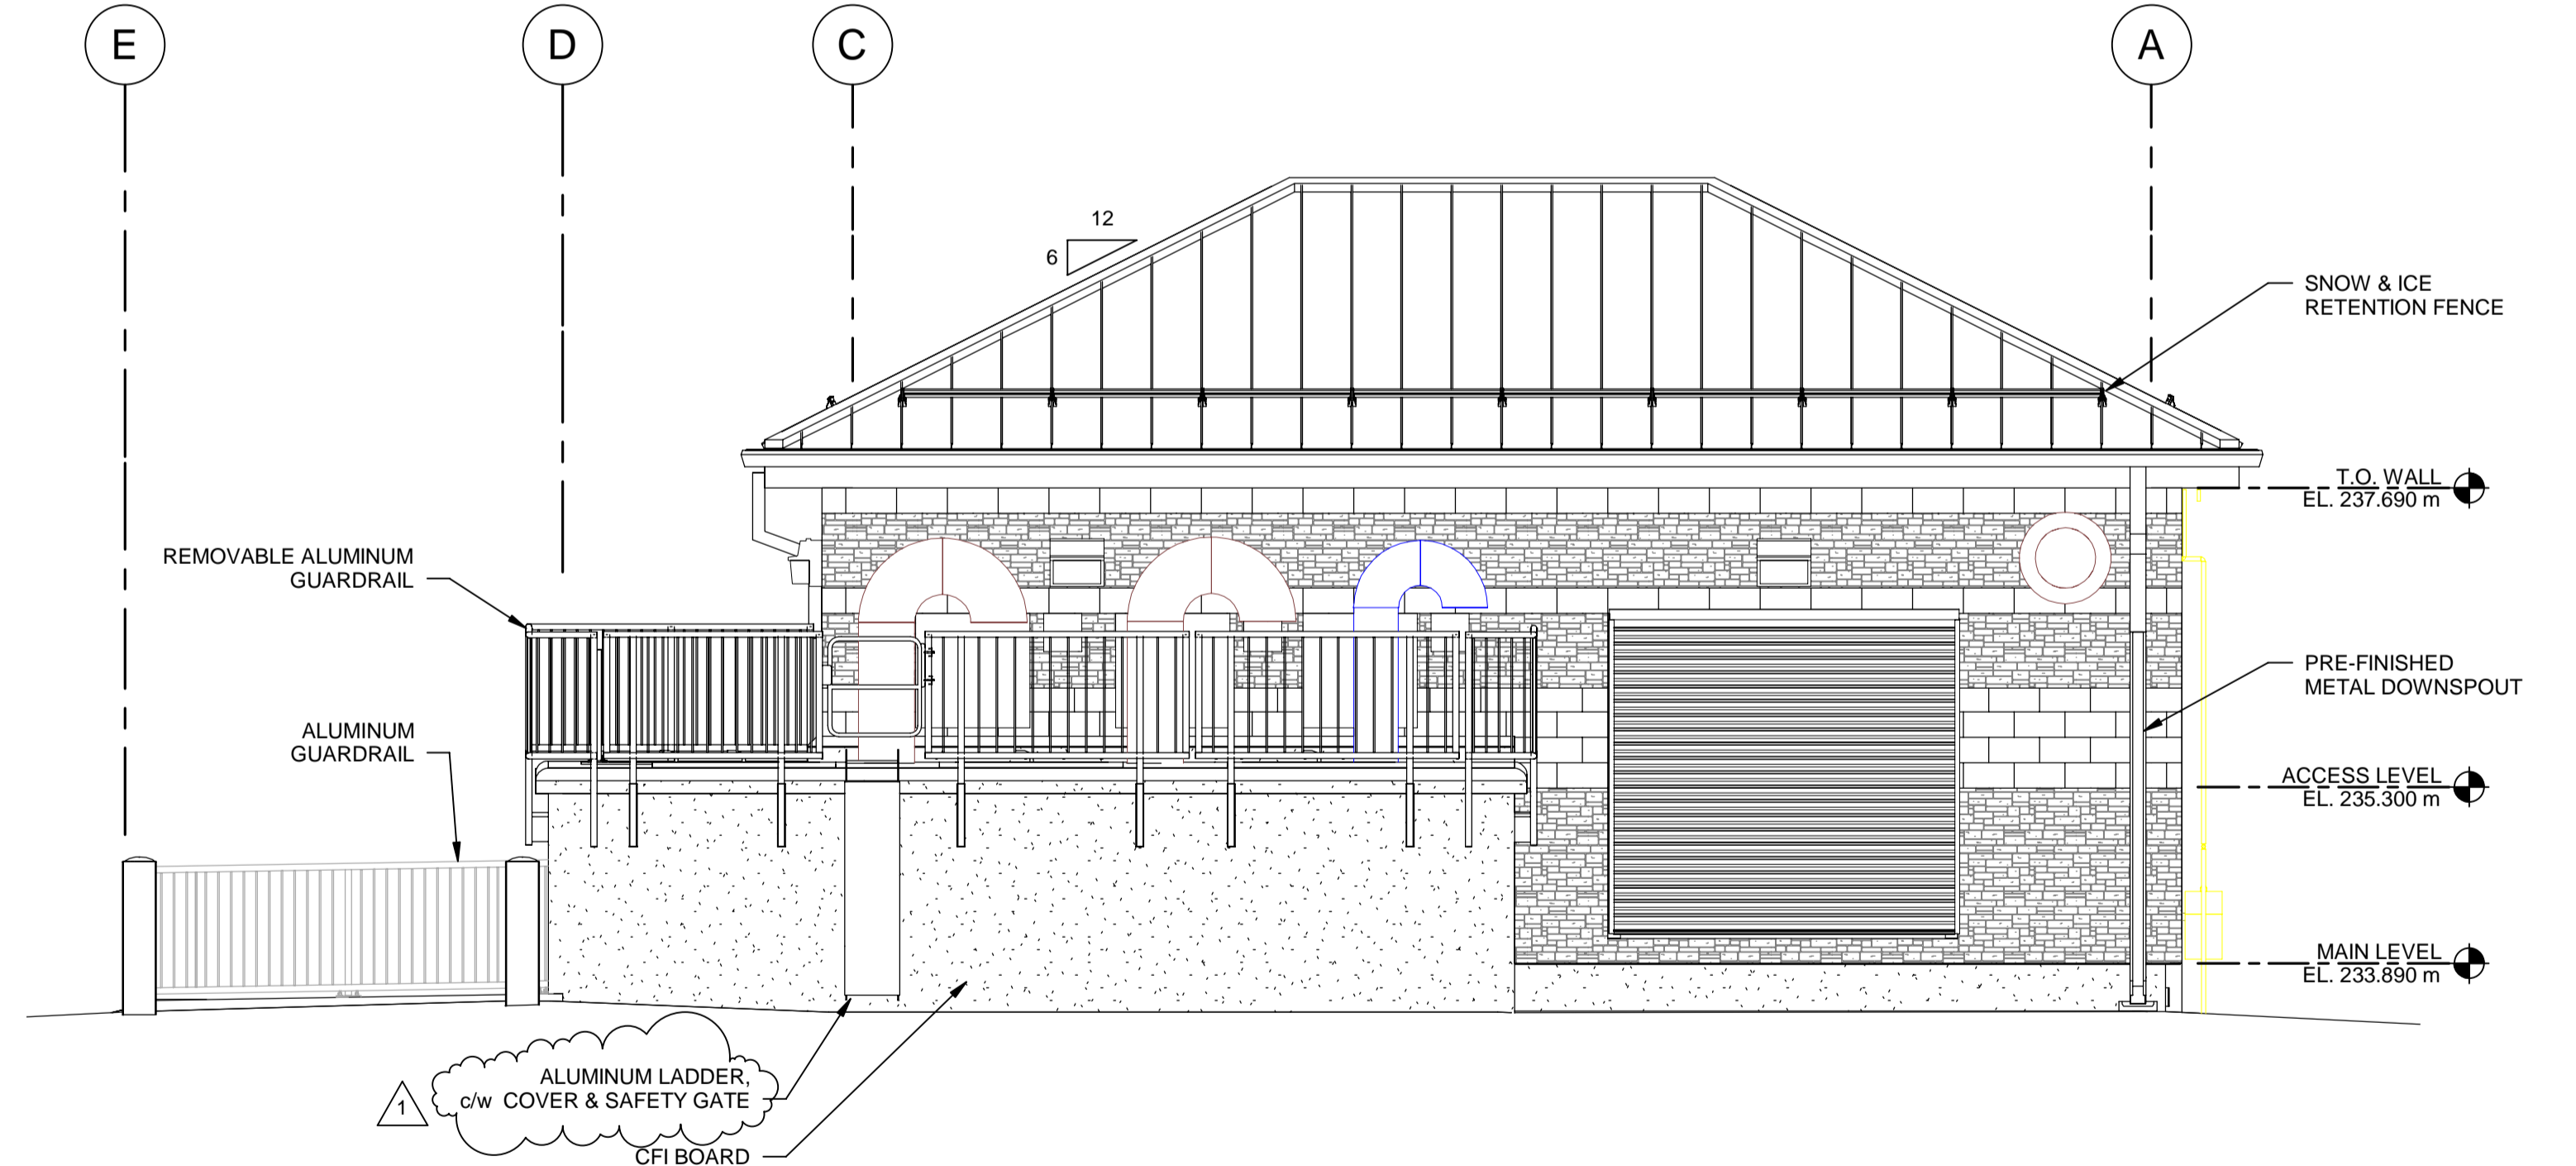

4 | WEST ELEVATION


BB-201 SCALE: 1 : 50

METRIC
WHOLE NUMBERS INDICATE MILLIMETRES
DECIMALIZED NUMBERS INDICATE METRES



UNDERGROUND STRUCTURES		B.M. ELEV.
SUPV. U/G STRUCTURES	DATE	
LOCATION OF UNDERGROUND STRUCTURES AS SHOWN ARE BASED ON THE BEST INFORMATION AVAILABLE. BUT NO GUARANTEE IS GIVEN THAT ALL EXISTING UTILITIES ARE SHOWN OR THAT THE GIVEN LOCATIONS ARE EXACT. CONFIRMATION OF EXISTENCE AND EXACT LOCATION OF ALL SERVICES MUST BE OBTAINED FROM THE INDIVIDUAL UTILITIES BEFORE PROCEEDING WITH CONSTRUCTION.		

DESIGNED BY		CHECKED BY	
KK		GPP	
DRAWN BY		APPROVED BY	
KK		AN	
HOR. SCALE		RELEASED FOR CONSTRUCTION	
AS SHOWN			
VERTICAL		DATE	
		06/01/2016	09/06/2016
NO. REVISIONS		DATE	

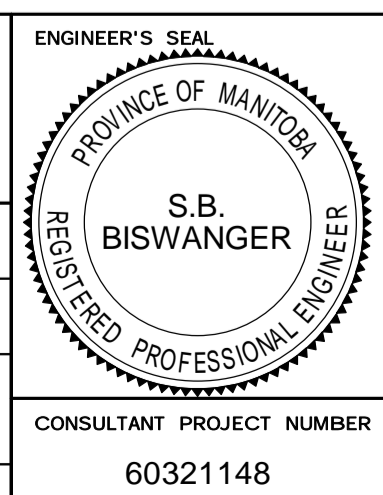

THE CITY OF WINNIPEG
PUBLIC WORKS DEPARTMENT

Waverley Street Underpass at CN Mile 3.89 Rivers Sub
Contract 2: Underpass Structure, Railworks,
Roadworks, Land Drainage Sewer, Pumping Station
and Landscaping Works

PUMPING STATION
ELEVATIONS

CITY DRAWING NUMBER: U-239-2016-C2-BB-201
SHEET 6 OF 9
CONSULTANT DRAWING NUMBER: C2-BB-201

P:\60321148\900-Work\910-CAD\99-SUPPORT\PROJECT_TITLE_BLOCKS\Title_Block_for_Pump_Station_works\163383-XTB-C1-CU.dwg