


1 | MAIN LEVEL - CURBS & SLABS
 BS-103 SCALE: 1:50

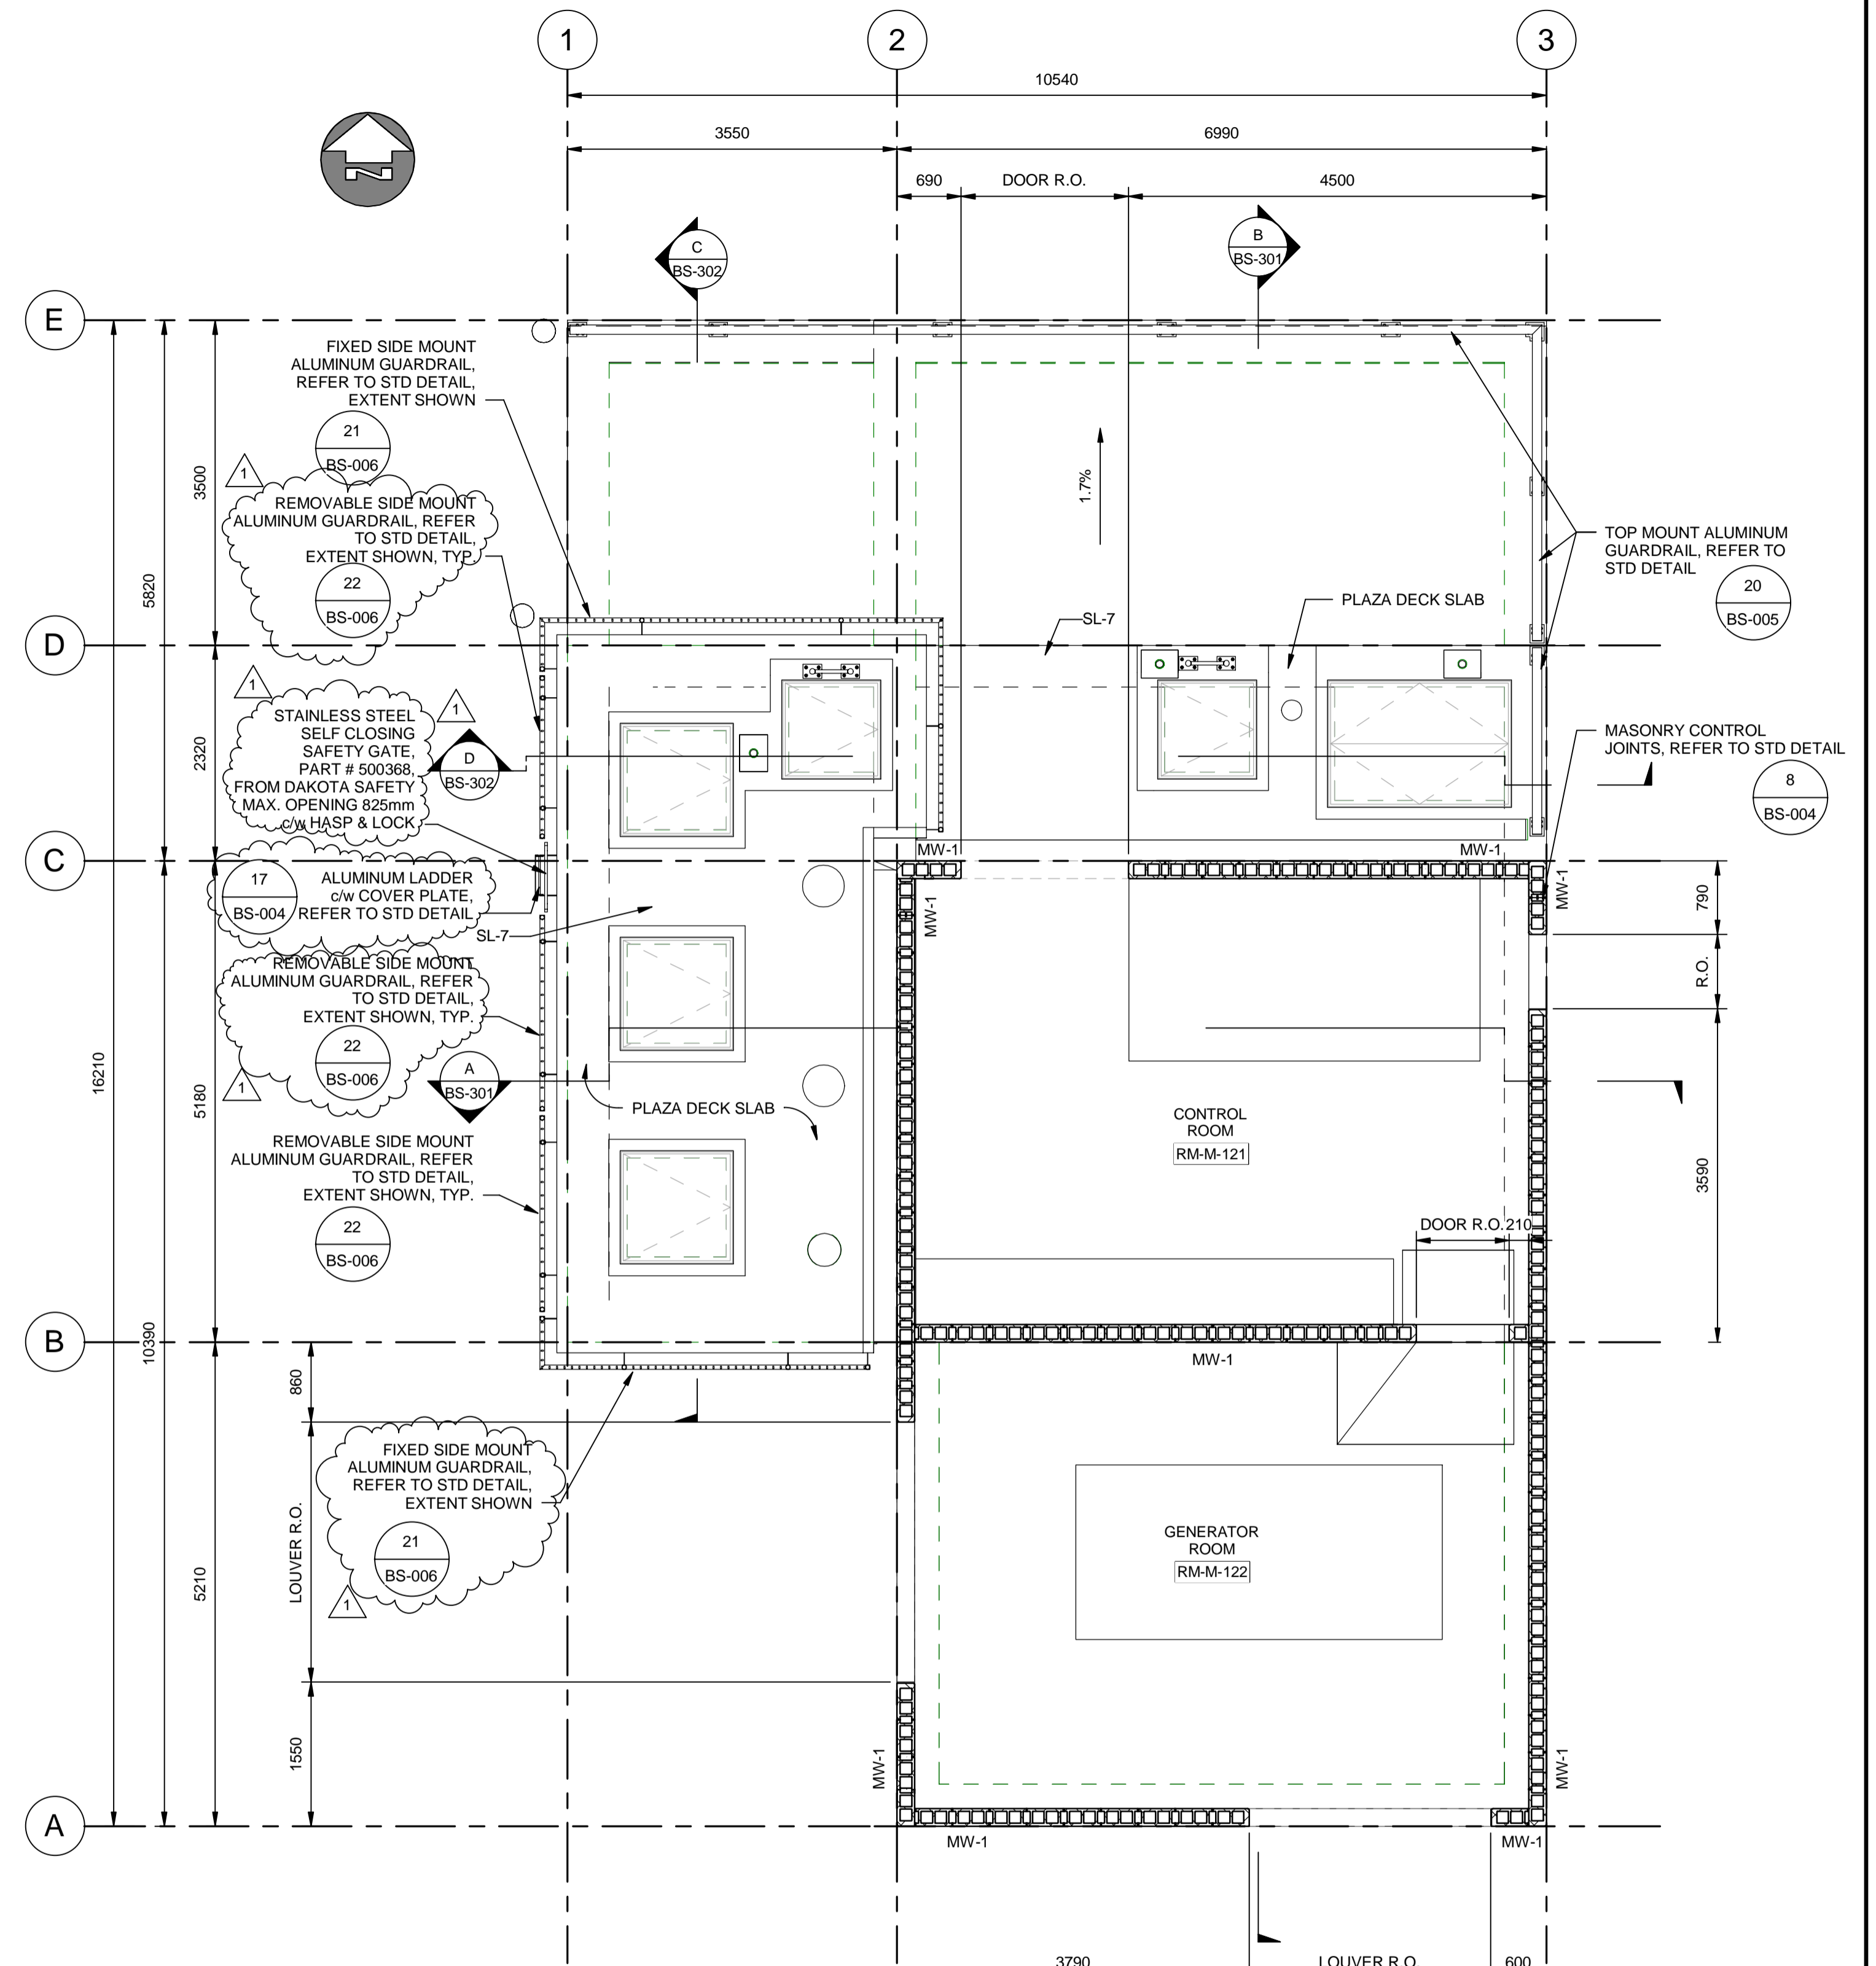

2 | MAIN LEVEL - WALLS
 BS-103 SCALE: 1:50

NOTE:
 1. PLAZA DECK SLAB NOT SHOWN FOR CLARITY.

MAIN LEVEL DESIGN LOADS (UNFACTORED)		
DEAD LOADS	STRUCTURE SELF WEIGHT	
LIVE LOADS	MAIN LEVEL FLOOR	9.6 kPa
EARTH LOADS	LATERAL EARTH PRESSURE	(6+15H) kPa (H=DEPTH OF SOIL)
	SOIL UNIT WEIGHT	21 kN/m ³



UNDERGROUND STRUCTURES		B.M. ELEV.
SUPPLY U/G STRUCTURES	DATE	
LOCATION OF UNDERGROUND STRUCTURES AS SHOWN ARE BASED ON THE BEST INFORMATION AVAILABLE BUT NO GUARANTEE IS GIVEN THAT ALL EXISTING UTILITIES ARE SHOWN OR THAT THE GIVEN LOCATIONS ARE EXACT. CONFIRMATION OF EXISTENCE AND EXACT LOCATION OF ALL SERVICES MUST BE OBTAINED FROM THE INDIVIDUAL UTILITIES BEFORE PROCEEDING WITH CONSTRUCTION.		

NO.	REVISIONS	DATE	BY	DATE
1	ISSUED FOR ADDENDUM 4	17/02/22	KK	
0	ISSUED FOR TENDER	17/01/09	KK	

AECOM

DESIGNED BY	KK/JT	CHECKED BY	SBB
DRAWN BY	KK	APPROVED BY	AN
HOR. SCALE	AS SHOWN	RELEASED FOR CONSTRUCTION	
VERTICAL		DATE	09/06/2016

CONSULTANT PROJECT NUMBER: 60321148

ENGINEER'S SEAL

PROVINCE OF MANITOBA

J.A. THOMPSON
 Member
 30632

REGISTERED PROFESSIONAL ENGINEER

THE CITY OF WINNIPEG
 PUBLIC WORKS DEPARTMENT

Waverley Street Underpass at CN Mile 3.89 Rivers Sub
 CONTRACT 2: UNDERPASS STRUCTURE, RAILWORKS, ROADWORKS, LAND DRAINAGE SEWER, PUMPING STATION AND LANDSCAPING WORKS

PUMPING STATION
 MAIN FLOOR FRAMING & CURBS PLAN

CITY DRAWING NUMBER: U-239-2016-C2-BS-103
 SHEET 9 OF 16
 CONSULTANT DRAWING NUMBER: C2-BS-103

METRIC
 WHOLE NUMBERS INDICATE MILLIMETRES
 DECIMALIZED NUMBERS INDICATE METRES

P:\60321148\900-Work\910-CAD\910-CAD\99-SUPPORT\PROJECT_TITLE_BLOCKS\Title_Block_for_Pump_Station_works\1633853-XTB-C1-CU.dwg