


WEST SIDE RETAINING WALL PLAN - SOUTH OF MATCH LINE
1:150

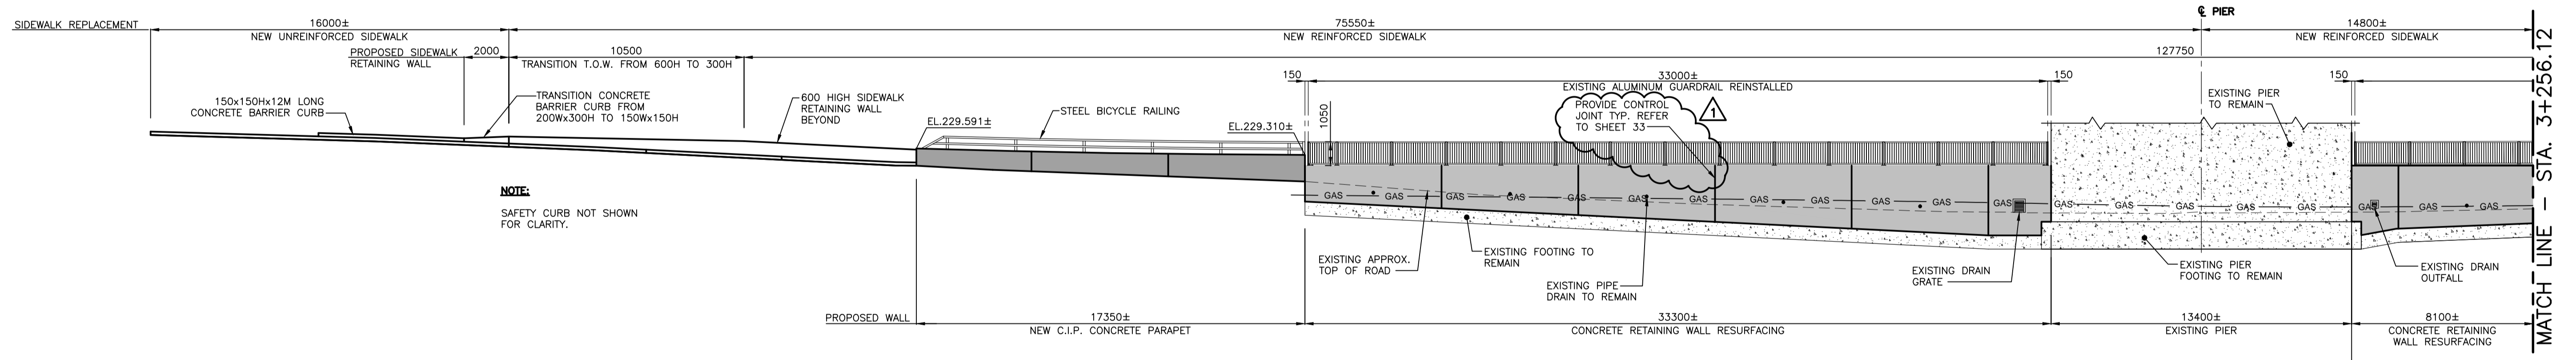

WEST SIDE RETAINING WALL ELEVATION - SOUTH OF MATCH LINE
1:150

- NOTES:
- REFER TO SHEET 19 FOR GENERAL NOTES.

- LEGEND:
- EXISTING CONCRETE
 - RESURFACED/RECONSTRUCTED RETAINING WALL
 - RECONSTRUCTED PARAPET WALL

VA1197.ecd\w\1197\6880\0302.dwg (p.02) sheet: 1197\03_struct\06880s-104-884.dwg 2016/07/14 1:41 PM BJC Coley, Tracer

150 WM		150 WM		HYDRO		150 WM		150 WM	
	HYDRANT VALVE		M.T.S. CONCRETE		MILL AND FILL OVERLAY		WASTE WATER SEWER		NORTH OR WEST GUTTER
	LAND DRAINAGE SEWER		SEEDING		CONCRETE SIDEWALK		SOUTH OR EAST GUTTER		NORTH OR EAST R
	WASTE WATER SEWER		PROPERTY LINE		SURVEY BAR		SOUTH OR EAST R		NORTH OR WEST DITCH
	MANHOLE		ELEVATION		SIDEWALK DETECTABLE		SOUTH OR EAST DITCH		EXISTING
	CATCH BASIN/CATCH PIT CURB INLET		PROPOSED		EXISTING		PROPOSED		EXISTING
	CURB RENEWAL		PROPOSED		EXISTING		PROPOSED		EXISTING
	GRAVEL		PROPOSED		EXISTING		PROPOSED		EXISTING
	GAS		PROPOSED		EXISTING		PROPOSED		EXISTING
	EXISTING LEGEND-PLAN		PROPOSED LEGEND-PLAN		EXISTING LEGEND-PLAN		PROPOSED LEGEND-PLAN		EXISTING LEGEND-PROFILE

LOCATION APPROVED UNDERGROUND STRUCTURES

SUPV. U/G STRUCTURES COMMITTEE DATE

NOTE:
LOCATION OF UNDERGROUND STRUCTURES AS SHOWN ARE BASED ON THE BEST INFORMATION AVAILABLE BUT NO GUARANTEE IS GIVEN THAT ALL EXISTING UTILITIES ARE SHOWN OR THAT THE GIVEN LOCATIONS ARE EXACT. CONFIRMATION OF EXISTENCE AND EXACT LOCATION OF ALL SERVICES MUST BE OBTAINED FROM THE INDIVIDUAL UTILITIES BEFORE PROCEEDING WITH CONSTRUCTION.

B.M. ELEV.	NO.	REVISIONS	DATE	BY
	1	ISSUED FOR ADDENDUM No.1	16.07.13	K.S.A.
	0	ISSUED FOR TENDER	16.07.04	K.S.A.

Stantec
500 - 311 Portage Avenue, Winnipeg MB Canada
www.stantec.com

DESIGNED BY: S.Y. CHECKED BY: K.S.A.
DRAWN BY: M.U. APPROVED BY: B.J.W.

HOR. SCALE: AS SHOWN
VERTICAL: _____

DATE: 2016.07.04

ENGINEER'S SEAL

CONSULTANT DRAWING NO. S-107

THE CITY OF WINNIPEG
PUBLIC WORKS DEPARTMENT
ENGINEERING DIVISION

2016 REGIONAL STREET PROGRAM
ARCHIBALD STREET
UNDERPASS REHABILITATION
WEST RECONSTRUCTION PLAN (1 OF 2)

SHEET 23 OF 62
CAD FILE DRAWING NUMBER 06880s-104-884.dwg
CITY DRAWING NUMBER U205-16-23