


EAST SIDE RETAINING WALL PLAN – SOUTH OF MATCH LINE
1:150

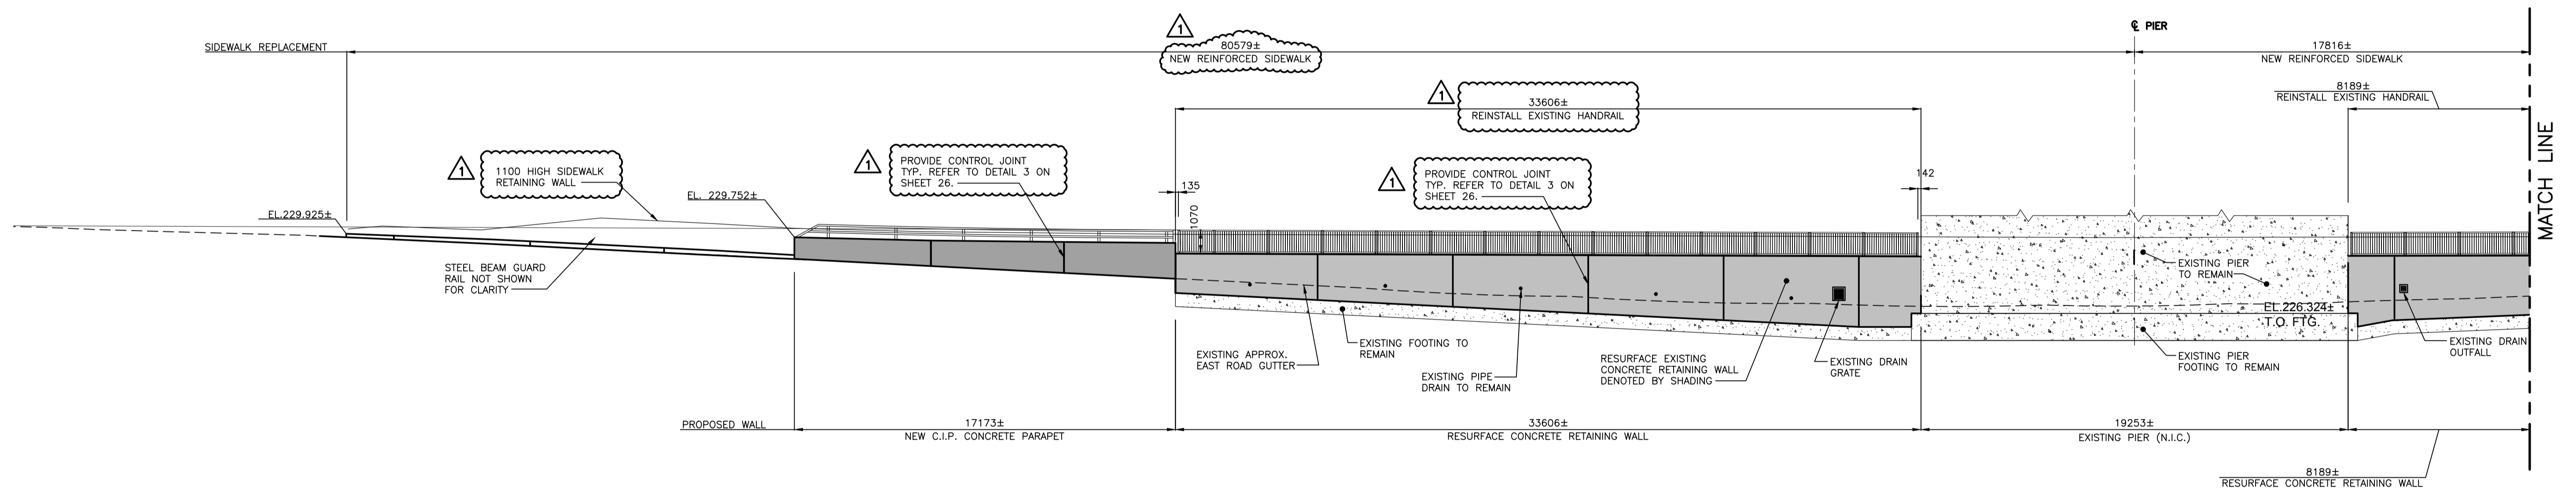

EAST SIDE RETAINING WALL ELEVATION – SOUTH OF MATCH LINE
1:150

NOTES:

- REFER TO DRAWING S102 FOR GENERAL NOTES.
- SIDEWALK CONTROL JOINTS SHALL MATCH EXISTING RETAINING WALL CONTROL JOINTS OR PAVEMENT JOINTS.

LEGEND:

- EXISTING CONCRETE
- RESURFACED/RECONSTRUCTED RETAINING WALL
- RECONSTRUCTED PARAPET WALL

VA:1371.ecd\w\1137168\0302.dwg\p\0302.dwg\1137168.dwg\1137168.dwg

150 WM	WATERMAIN	150 WM	HYDRO	150 WM	WATERMAIN	150 WM
+	HYDRANT	+	M.T.S.	+	HYDRANT, VALVE	+
+	VALVE	+	CONCRETE	+	LAND DRAINAGE SEWER	+
+	LAND DRAINAGE SEWER	+	MILL AND FILL OVERLAY	+	WASTE WATER SEWER	+
+	WASTE WATER SEWER	+	CONCRETE SIDEWALK	+	WASTE WATER SEWER	+
○	MANHOLE	○	BOREHOLE	○	NORTH OR WEST GUTTER	○
□	CATCH BASIN/CATCH PIT	□	SEEDING	○	SOUTH OR EAST GUTTER	○
▽	CURB INLET	▽	PROPERTY LINE	◇	NORTH OR WEST R.	◇
▽	CURB RENEWAL	▽	SURVEY BAR	◇	SOUTH OR EAST R.	◇
---	GRAVEL	---	ELEVATION	△	NORTH OR WEST DITCH	△
---	GAS	---	SIDEWALK DETECTABLE	▽	SOUTH OR EAST DITCH	▽
---	LEGEND-PLAN	---	PROPOSED	---	LEGEND-PROFILE	---
---	EXISTING	---	EXISTING	---	PROPOSED	---

LOCATION APPROVED UNDERGROUND STRUCTURES

SUPV. U/G STRUCTURES COMMITTEE DATE

NOTE:
LOCATION OF UNDERGROUND STRUCTURES AS SHOWN ARE BASED ON THE BEST INFORMATION AVAILABLE BUT NO GUARANTEE IS GIVEN THAT ALL EXISTING UTILITIES ARE SHOWN OR THAT THE GIVEN LOCATIONS ARE EXACT. CONFIRMATION OF EXISTENCE AND EXACT LOCATION OF ALL SERVICES MUST BE OBTAINED FROM THE INDIVIDUAL UTILITIES BEFORE PROCEEDING WITH CONSTRUCTION.

NO.	REVISIONS	DATE	BY
1	ISSUED FOR ADDENDUM No.1	16.07.13	K.S.A.
0	ISSUED FOR TENDER	16.07.04	K.S.A.

Stantec
500 - 311 Portage Avenue, Winnipeg MB Canada
www.stantec.com

DESIGNED BY: S.Y. CHECKED BY: K.S.A.
DRAWN BY: T.B.C. APPROVED BY: B.J.W.

HOR. SCALE: AS NOTED
VERTICAL: AS NOTED

DATE: 2016.07.04

ENGINEER'S SEAL

CONSULTANT DRAWING NO. S-114

THE CITY OF WINNIPEG
PUBLIC WORKS DEPARTMENT
ENGINEERING DIVISION

2016 REGIONAL STREET PROGRAM
ARCHIBALD STREET
UNDERPASS REHABILITATION
EAST RECONSTRUCTION PLAN (1 OF 2)

SHEET 30 OF 62
CAD FILE DRAWING NUMBER 06880s-111-884.dwg
CITY DRAWING NUMBER U205-16-30